
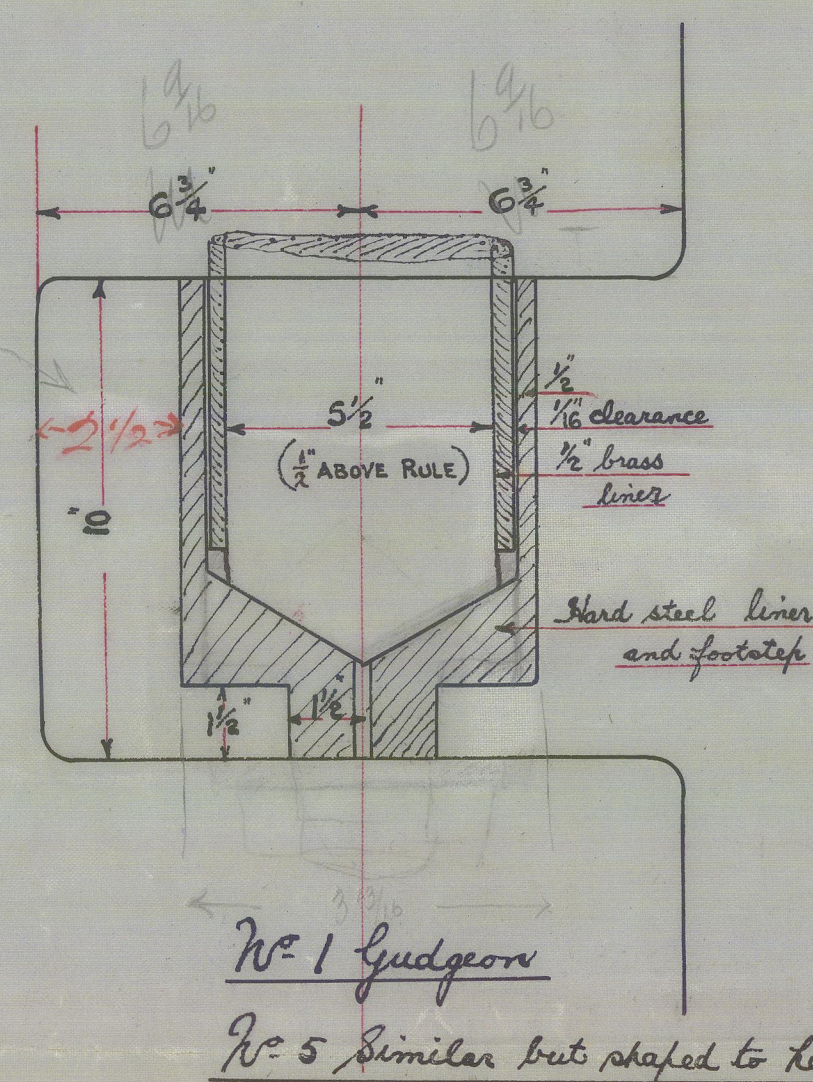
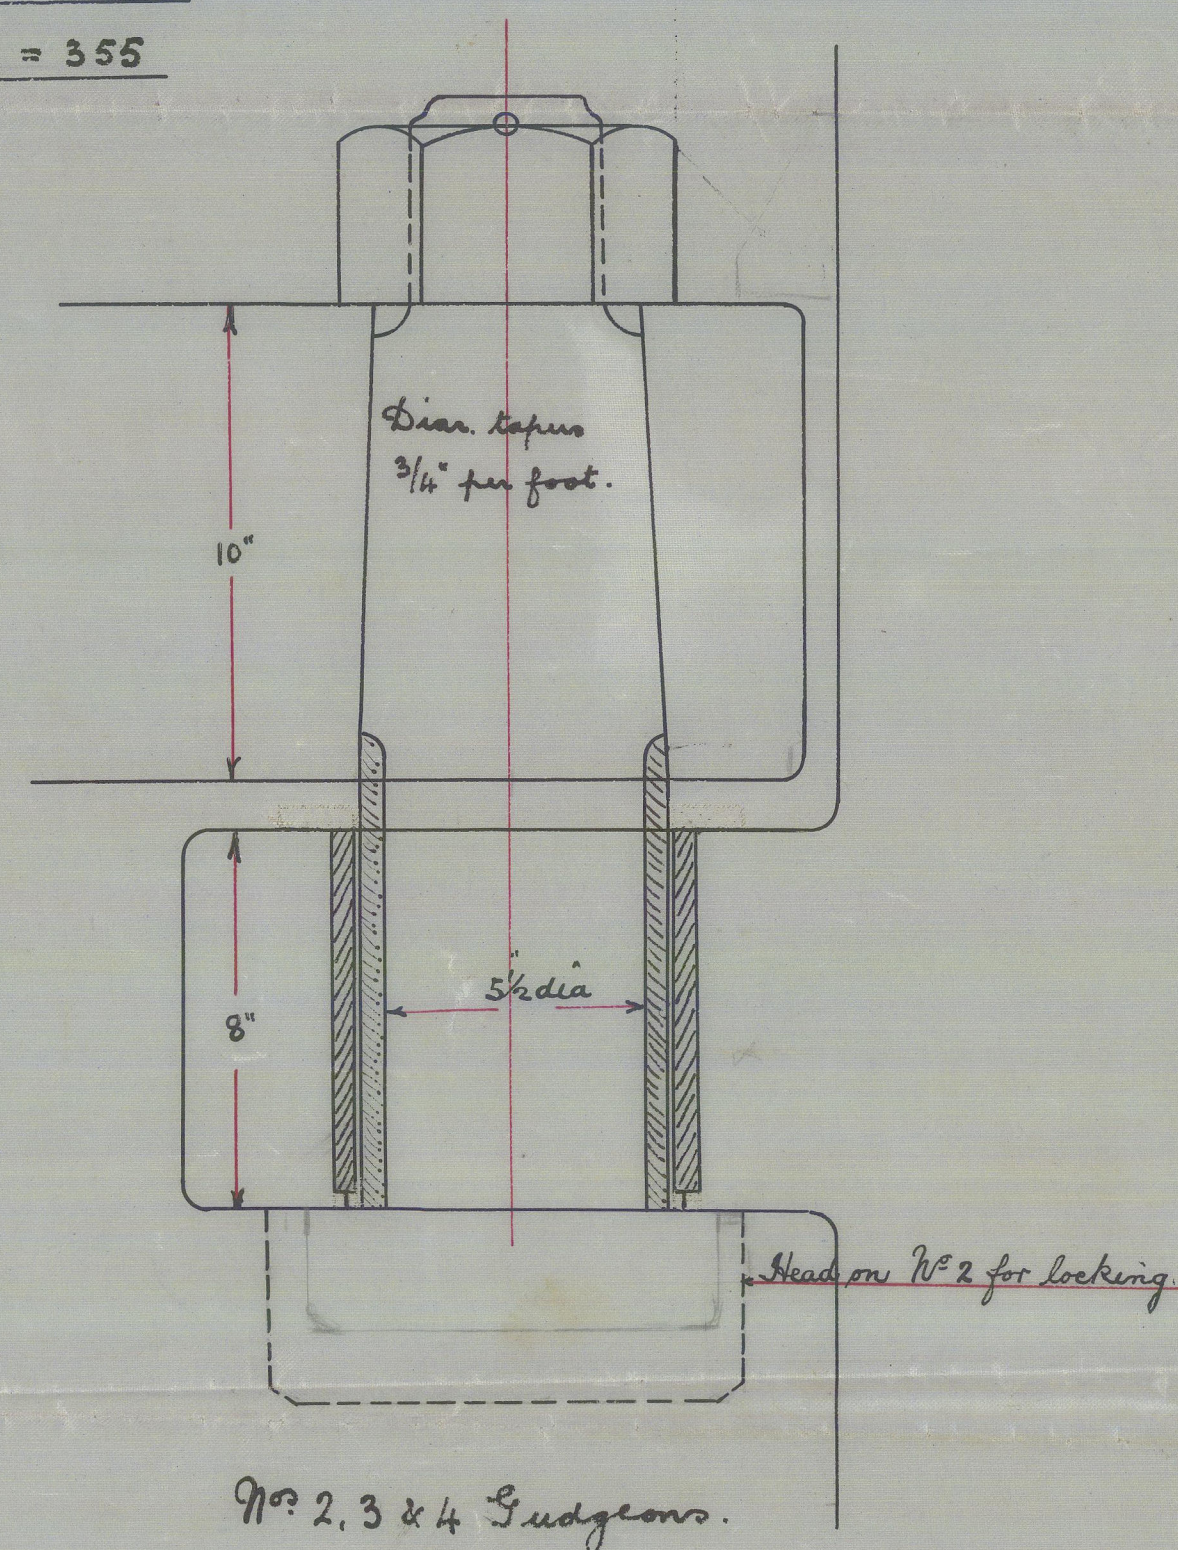


18-10-23

Scale $\frac{1}{2}" = 1 \text{ Foot.}$

Length of Vessel 350.0'
 Draft 20.3"
 Speed 15 knots.
 Total area 113 sq
 C. of G. from centre of fin 3.14.
 $A \times D = 113 \times 3.14 = 355$

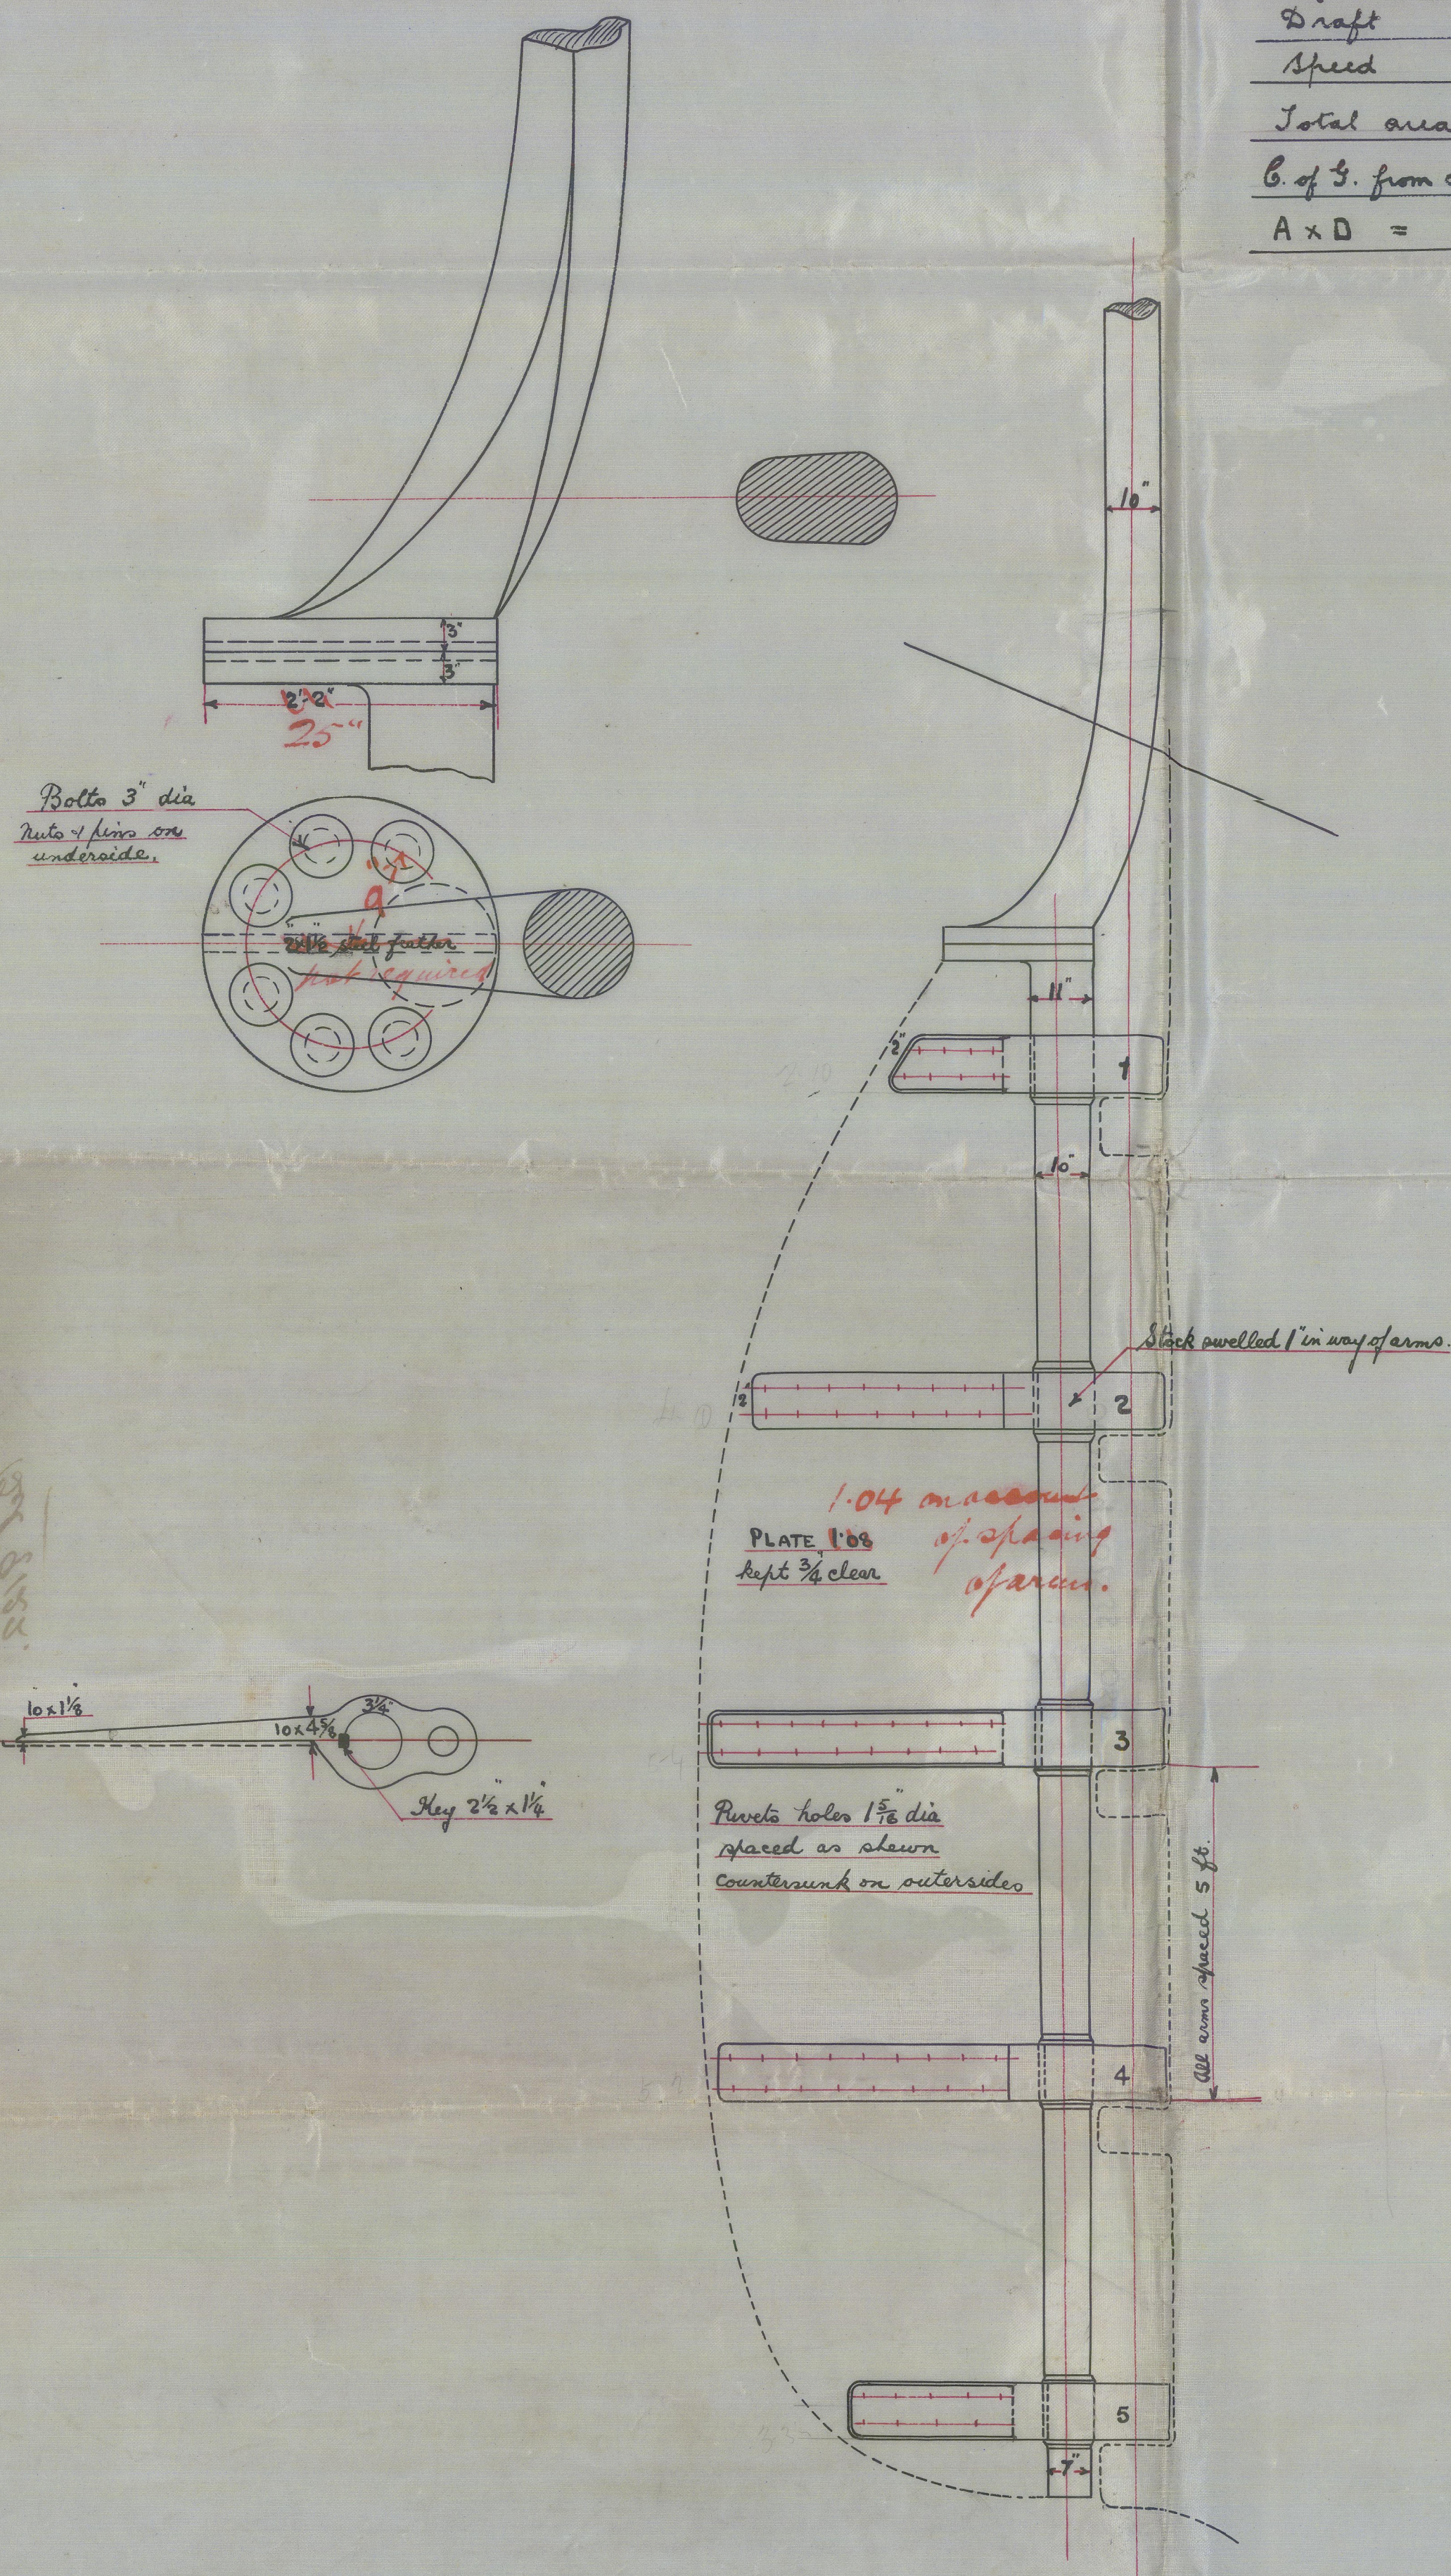

No 1 Gudgeon

No 5 Similar but shaped to heel.

16. 10. 23.



