

Lloyd's Register of Shipping.
SURVEYS FOR FREEBOARD.

Computation of Freeboard for ^{Motor} Steamer, Sailing Ship, Tanker					Port of Survey <u>London</u>
having <u>Forecastle & Raised Quarter Deck.</u>					Date of Survey <u>16-1-33.</u>
(Type of Superstructures.)					Name of Surveyor <u>Thomas E. Sowden.</u>
Ship's Name	Nationality and Port of Registry	Official Number	Gross Tonnage	Date of Build	Particulars of Classification <u>+100A.1.</u>
<u>"ASSIDUITY"</u>	<u>British London.</u>	<u>162,508</u>	<u>350</u>	<u>1930-11</u>	
Moulded Dimensions: Length <u>135.</u> Breadth <u>24.50</u> Depth <u>9.6</u>					
Moulded displacement at moulded draught = 85 per cent. of moulded depth <u>568</u> tons					
Coefficient of fineness for use with Tables <u>.745</u>					

Depth for Freeboard (D)	Depth correction	Round of Beam correction
Moulded depth <u>9.50</u>	(a) Where D is greater than Table depth (D-Table depth) R = <u>(9.53 - 9.00) 1.038 = + .55</u>	Moulded Breadth (B) <u>24.50</u>
Stringer plate <u>38.</u> <u>.03</u>	(b) Where D is less than Table depth (if allowed) (Table depth-D) R =	Standard Round of Beam = $\frac{B \times 12}{50} =$ <u>5.88</u>
Sheathing on exposed deck $T \left(\frac{L-S}{L} \right) =$ <u>✓</u>	If restricted by superstructures <u>✓</u>	Ship's Round of Beam = <u>6</u>
Depth for Freeboard (D) = <u>9.53</u>		Difference <u>.12</u>
		Restricted to
		Correction = $\frac{\text{Diff}^2}{4} \times \left(1 - \frac{S_1}{L} \right) = \frac{.12^2}{4} \times .2118 = -.01$

DEDUCTION FOR SUPERSTRUCTURES.

	Mean Covered Length (S)	Equivalent Enclosed Length (S ₁)	Height	Height Correction	Effective Length (E)	
Poop enclosed						Standard Height of Superstructure <u>6.0</u>
" overhang						" " R.Q.D. <u>3.24</u>
R.Q.D. enclosed	<u>89.69</u>	<u>89.69</u>	<u>3.6</u>	<u>✓</u>	<u>89.69</u>	Deduction for complete superstructure <u>19.50</u>
" overhang						Percentage covered $\frac{S}{L} =$ <u>78.82%</u>
Bridge enclosed						" " $\frac{S_1}{L} =$ <u>78.82%</u>
" overhang aft						" " $\frac{E}{L} =$ <u>78.82%</u>
" overhang forward	<u>16.72</u>	<u>16.72</u>	<u>7.0</u>	<u>✓</u>	<u>16.72</u>	Percentage from Table, Line A. <u>73.84%</u>
Poole enclosed <u>Equipped</u>	<u>15.56</u>	<u>16.72</u>	<u>7.0</u>	<u>✓</u>	<u>16.72</u>	(corrected for absence of fore-castle (if required)) <u>✓</u>
" overhang	<u>2.5</u>		<u>7.0</u>			Percentage from Table, Line B. <u>✓</u>
Trunk aft						(corrected for absence of fore-castle (if required)) <u>✓</u>
" forward						Interpolation for bridge less than 2L (if required) <u>✓</u>
Tonnage opening aft						Deduction = <u>19.50</u> × <u>.7384</u> = <u>-14.40</u>
" " forward						
Total	<u>106.41</u>	<u>106.41</u>			<u>106.41</u>	

SHEER CORRECTION.

Station	Standard Ordinate	S	M	Product	Actual Ordinate	Effective Ordinate	S	M	Product	
A.P.	<u>23.50</u>	1		<u>23.50</u>	<u>27</u>	<u>27.00</u>	1		<u>23.50</u>	Mean actual sheer aft = <u>Excess</u>
$\frac{1}{4}$ L from A.P.	<u>10.46</u>	4		<u>41.84</u>	<u>13.5</u>	<u>13.43</u>	4		<u>41.84</u>	Mean actual sheer forward = <u>Deficient</u>
$\frac{3}{4}$ L "	<u>2.58</u>	2		<u>5.16</u>	<u>3.5</u>	<u>3.36</u>	2		<u>5.16</u>	Mean standard sheer forward
Amidships	<u>✓</u>	4		<u>✓</u>	<u>✓</u>	<u>✓</u>	4		<u>✓</u>	Length of enclosed superstructure forward of amidships =
$\frac{3}{4}$ L from F.P.	<u>5.17</u>	2		<u>10.34</u>	<u>4.2</u>	<u>4.74</u>	2		<u>9.48</u>	" " aft of " =
$\frac{1}{4}$ L "	<u>20.91</u>	4		<u>83.64</u>	<u>19</u>	<u>18.96</u>	4		<u>75.84</u>	
F.P.	<u>47.00</u>	1		<u>47.00</u>	<u>45</u>	<u>45.00</u>	1		<u>45.00</u>	
Total				<u>211.48</u>					<u>200.82</u>	
Correction = $\frac{\text{Difference between sums of products}}{18} \left(.75 - \frac{S}{2L} \right) = \frac{10.66}{18} \times (.75 - .3941) = +.21$										
If limited on account of midship superstructure. <u>✓</u>										If limited to maximum allowance of $1\frac{1}{2}$ ins. per 100 ft. <u>✓</u>

Deduction for Tropical Freeboard.
Addition for Winter and Winter North Atlantic Freeboard.Depth to Freeboard Deck = 13.03
Summer freeboard = 3.67
Moulded draught (d) = 9.36Deduction for Tropical freeboard and addition for Winter freeboard = $\frac{d}{4}$ inches = 2.34 = 2\frac{1}{4}
Addition for Winter North Atlantic Freeboard (if required) =

Deduction for Fresh Water.

Displacement in salt water at summer load water line

 $\Delta =$

Tons per inch immersion at summer load water line

T =

Deduction = $\frac{\Delta}{40T}$ inches

TABULAR FREEBOARD corrected for Flush Deck (if required)

Correction for coefficient $\frac{.745 + .68}{1.36} = \frac{1.425}{1.36}$

	+	-
Depth Correction	<u>.55</u>	<u>✓</u>
Deduction for superstructures	<u>✓</u>	<u>14.40</u>
Sheer correction	<u>.21</u>	<u>✓</u>
Round of Beam correction	<u>✓</u>	<u>.01</u>
Correction for Thickness of Deck amidships	<u>42.00</u>	<u>✓</u>
Other corrections, scantlings, etc.	<u>✓</u>	<u>✓</u>
	<u>42.76</u>	<u>14.41</u>
Summer Freeboard =	<u>42.60</u>	

SUMMER FREEBOARD amidships from Centre of Disc to top of Deck Line, ^{RAISED QUARTER}Wood, Steel, Deck: 3'-8" (limited)Tropical Fresh Water Line above Centre of Disc
Fresh Water Line " "
Tropical Line " "
Winter Line below " " 2\frac{1}{4}
Winter North Atlantic Line " "Tropical Fresh Water Freeboard
Fresh Water " "
Tropical " "
Winter " " 3'-10\frac{1}{4}
Winter North Atlantic " "

PARTICULARS OF PROTECTION TO OPENINGS, ETC.

HATCHWAYS ON FREEBOARD AND SUPERSTRUCTURE DECKS									
Description of Hatchway			Nº1. U.D.	Nº2. R.Q.D.					
Dimensions of Hatchway			18'-6" x 16'	33'-3" x 16'					
COAMINGS	{	Height above Deck	39 ✓	39 ✓					
		Thickness { Sides	37.5 ✓	37.5 ✓					
			Ends	37.5 ✓	37.5 ✓				
		Stiffeners	8" B.A. ✓	8" B.A. ✓					
		Brackets, Stays	2 ✓	4 ✓					
HATCH BEAMS	{	Number	2	4					
		Spacing	6'-2" ✓	6'-8" ✓					
		Scantling and Sketch	3 1/2 x 3 x 42 ✓	3 1/2 x 3 x 42 ✓					
			A 3 1/2 x 38 ✓ B 22 x 38 ✓	A 26 1/2 x 38 ✓ B 19 x 38 ✓					
		Bearing Surface	3 ✓	3 ✓					
FORE AND AFTERS	{	Number	3	3					
		Spacing	4' ✓	4' ✓					
		Unsupported Lengths	0'-2" ✓	6'-8" ✓					
		Scantling* and Sketch	C. 6 1/4 x 7 ✓ Wood 5 3/4 x 6 1/2 ✓	7 x 7 ✓ 6 1/4 x 6 1/2 ✓					
			Bearing Surface	3 ✓	3 ✓				
HATCH COVERS	{	Material	P ✓	P ✓					
		Thickness	2 1/2 ✓	2 1/2 ✓					
		How fitted	Atw ✓	ATH. ✓					
		Bearing Surface	3 ✓	3 ✓					
Spacing of Cleats			24 ✓	24 ✓					
Number of Tarpaulins			3 ✓	3 ✓					
<p>*Are wood fore and afters steel shod at all bearing surfaces? <i>Yes</i></p> <p>Are battens and wedges efficient and in good condition? <i>Yes</i></p> <p>Are tarpaulins in good condition and in accordance with rule requirements? <i>Yes</i></p> <p>Are lashings provided in accordance with rule requirements? <i>Yes</i></p>									

Particulars of fiddle, funnel and ventilator coamings :—

E.R. Skylight. Steel. strongly constructed
Funnel & Vent Coamings efficient

Particulars of Flush Bunker Scuttles :—

None.

Particulars of Companionways :—

None.

Particulars of Ventilators in exposed positions on freeboard and superstructure decks :—

File:- 2 at 5' x 30" high to Accm.
U.D. 1 at 8' x 36" - Fore hold
R.Q.D. 1 at 8' x 36" - Aft.

Wood plugs & canvas covers fitted

Particulars of Air Pipes in exposed positions on freeboard, raised quarter, or superstructure decks :—

File:- 1 at 1 1/2' x 14" high to F.P.
R.Q.D. 2 at 1 1/2' x 21" - to Fuel Tank.
2 at 2' x 24" - " "
1 at 2 1/2' x 14" - A.P. "

Efficient
No means of closing provided.

Particulars of Gangway Cargo and Coaling Ports :—

None.



Particulars of Scuppers and Sanitary Discharge Pipes:—

1 in. dia 41 in Deck House aft led below deck & fitted with storm valves

Particulars of Side Scuttles:—

Fitted with fixed hinged deadlights.

Particulars of Guard Rails:—

Fele D^o: 3ft high, 2 rods, & 4'-6" spacing of stanchions

Particulars of Gangways, Lifelines, etc.:—

Suitable lifelines are provided & adequate means of
Securing same available

Particulars of Freeing Arrangements.


	Length of Bulwark	Height of Bulwark	Size of Freeing Ports	Number each side	Area each side	Rule area each side
After Well	89.69 ✓	3'-3"	29" x 18"	4	14.5	17.94 \$
Forward Well	27-3 ✓	3'-6"	38" x 18"	2	9.5 ✓	9.22 \$
State position of each freeing port { After Well:— 28' 49' 63 & 80 ft aft of R.C.D bulkhead; 4" sill. (F, and A. position and height above deck edge) { Forward Well:— 6' & 16' fore of R.C.D; 9" " . State whether the freeing ports are fitted with shutters, bars, or rails, and give particulars of such:— 1 bar to each port.						
Additional area where sheer is less than standard.						

Particulars of Superstructures, Trunks, Casings, Deckhouses.

	Coaming	Plating	Stiffeners	Spacing	End Attachments of Stiffeners	Size of Openings	Height of Sills	Height of Casings
Poop Bulkhead								
Raised Quarter Deck Bulkhead ...	-	36	5" x 3" x 38 42 deep webs.	33" ✓	none. ✓	none ✓	-	3'-6" ✓
Bridge, After Bulkhead								
Bridge, Forward Bulkhead								
Forecastle Bulkhead	39" x 26 ✓	26	2½ x 2½ x 30	28" ✓	none. ✓	30 4'-2" x 20" ✓	26" ✓	7'-0" ✓
Trunk, Aft								
Trunk, Forward								
Exposed Machinery Casings on Freeboard or Raised Quarter Decks ...	32 x 26 ✓	26	2½ x 2½ x 26	30" ✓	none ✓	20 4'-6" x 2' ✓	24" ✓	7'-0" ✓
Exposed Machinery Casings on Superstructure Decks								
Machinery Casings within Superstructures not fitted with Class I Closing Appliances								
Deckhouses on Flush Deck Ships ...								

Particulars of Closing Appliances (state if capable of being manipulated from both sides).

Poop Bulkhead	✓	
Raised Quarter Deck Bulkhead ...	✓	No openings
Bridge, After Bulkhead	✓	
Bridge, Forward Bulkhead	✓	
Forecastle Bulkhead	12	hinged steel doors & hinged steel doors, operated from both sides.
Exposed Machinery Casings on Freeboard or Raised Quarter Decks ...	2	operated from both sides
Exposed Machinery Casings on Superstructure Decks	✓	
Machinery Casings within Superstructures not fitted with Class I Closing Appliances	✓	
Deckhouses on Flush Deck Ships ...	✓	

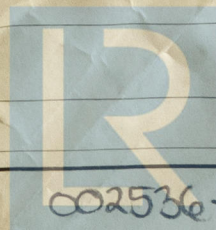


© 2020

Lloyd's Register

002536-002542-00882/2

Superstructure bulkheads, trunks, deckhouses, casings, cargo and coaling hatchways, extent and thickness of sheathing on the freeboard deck, gangway, cargo and coaling ports, and any other openings, etc., which would affect the seaworthiness of the ship are to be shewn on the following sketches:—

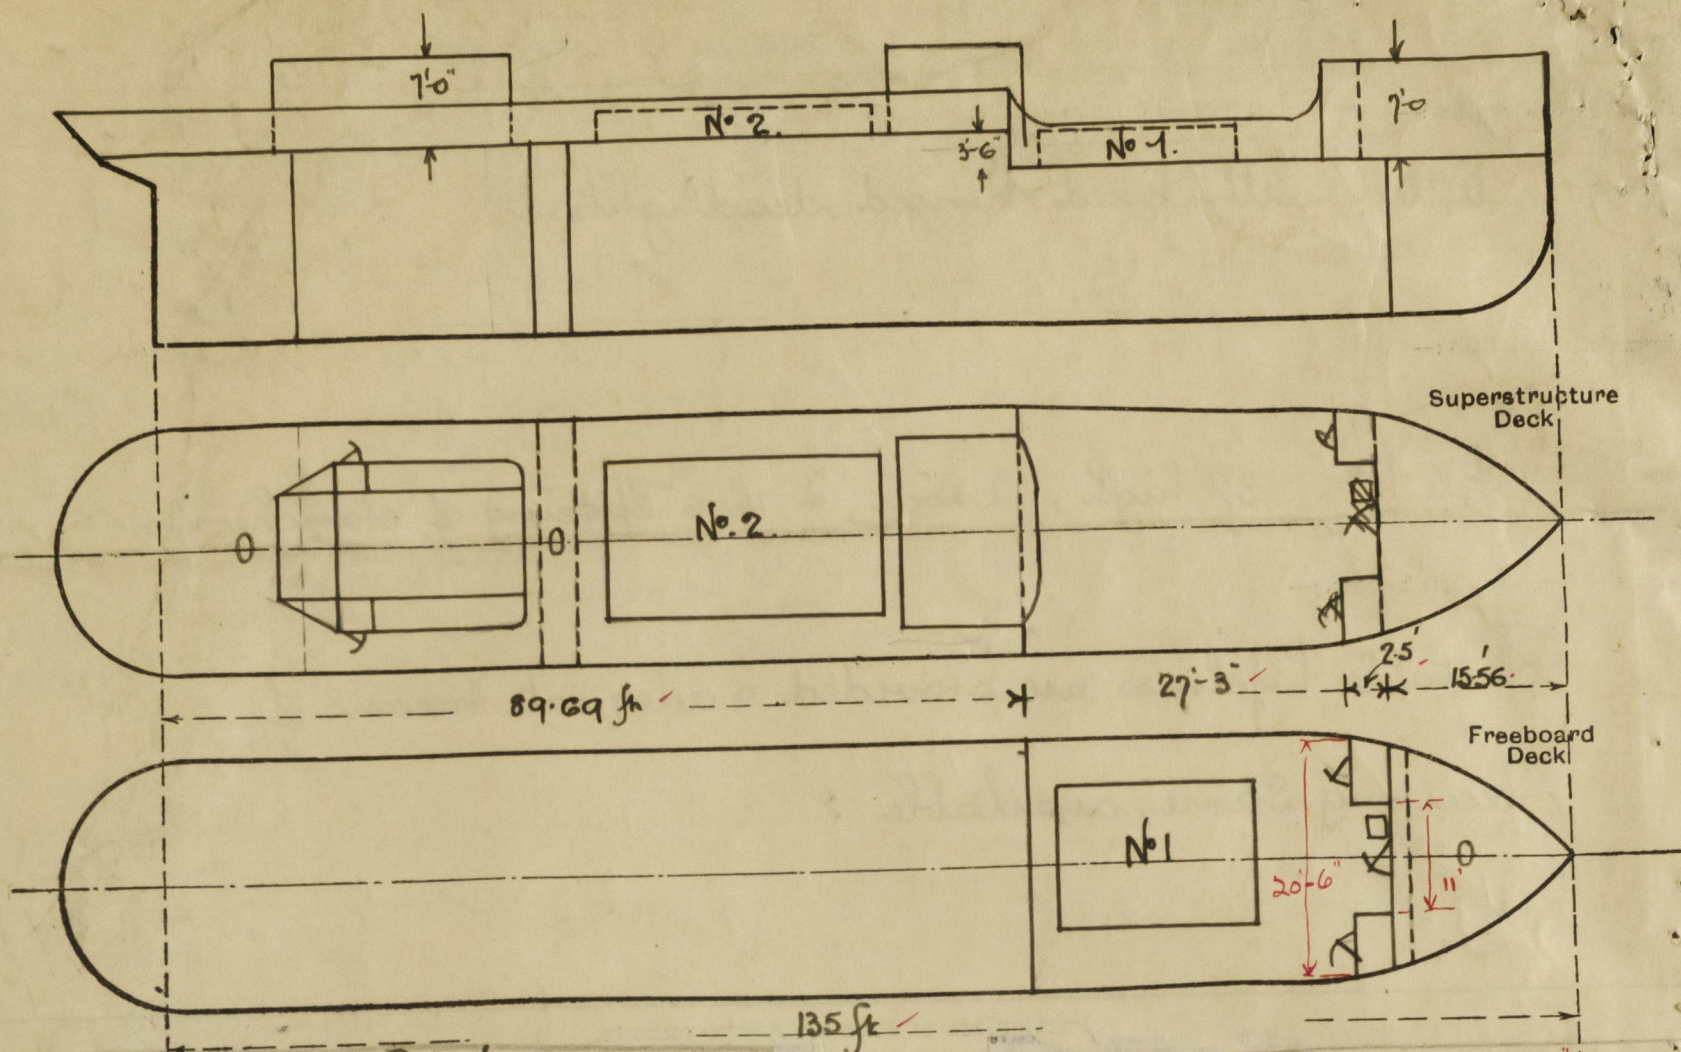

Draught.	Disp.	ons disp.
8'-0"	562	6.6
8'-6"	602	"
9'-0"	641	"
9'-6"	681	"

$$L = 18.06$$

$$DED. \frac{11 \times 2.5}{20.5} = \frac{1.34}{16.72} = \text{Equival}$$

State any special features in the construction of the ship:—

Small Hatches:—

- 1 on Fore Deck to Ch Lr. 24" x 20" x 18" high with covers clips battens & tarpaulins
- 1 Steel Manhole in Yele to Y.P. 16" x 12" x 3" coaming W.T. steel cover.
- 1 " " on aft deck to AP. " " " " " "
- 1 " " R.Q.D to oil tank " " " " " "

Builder's name and yard number

Geo. Brown & Co. No 174

Names of sister ships

Owners

J. Y. Everard & Sons Ltd

Fee £

5 2 0

Received by me

(19 JAN 1933)



© 2020

Lloyd's Register Foundation