
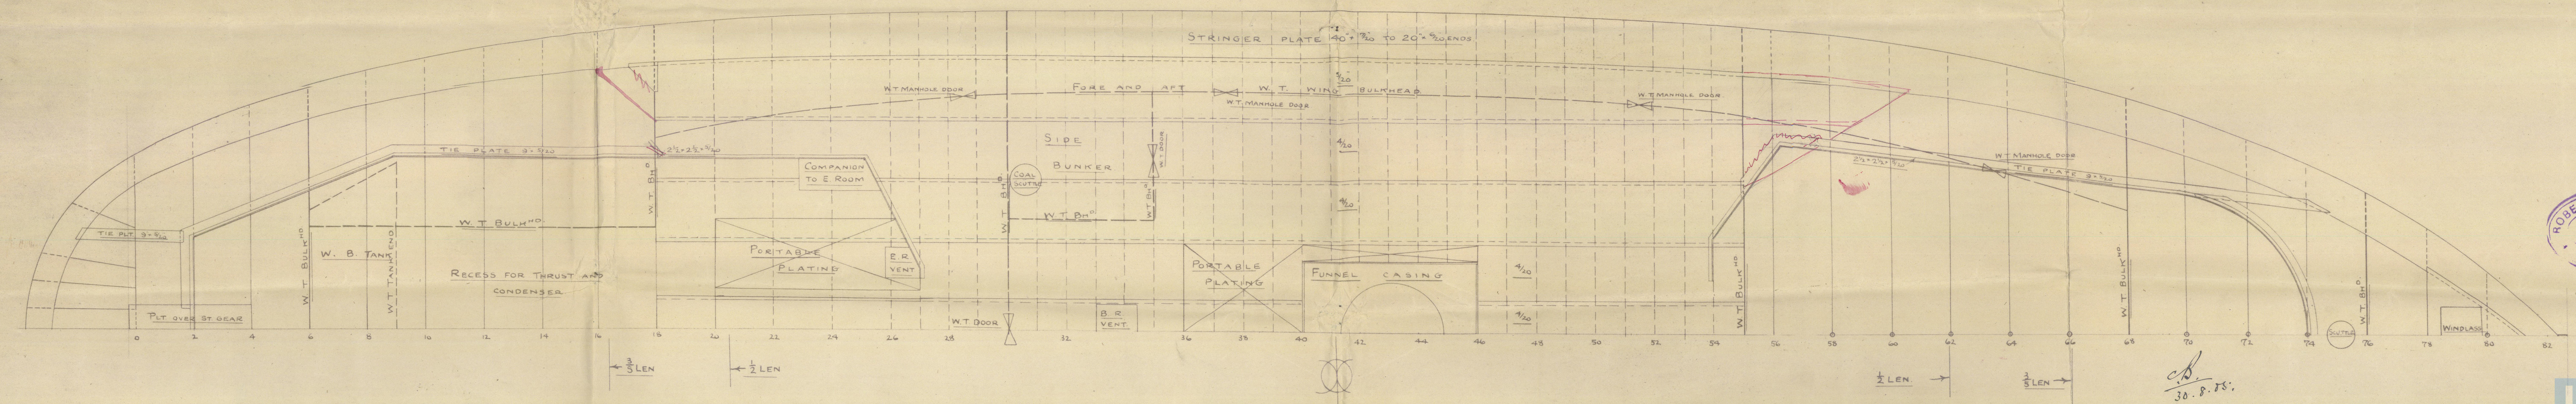


30.8.05
8.9.05
11.9.05
16.10.05

- Nos. 100-1 -
PROFILE AND DECK PLAN
OF
STEEL TWIN SCREW FERRY STEAMERS

| DIMENSIONS | |
|--------------|---------------|
| LEN. B.P. | 152 FT. 0 IN. |
| BREADTH MLD. | 40. 6 |
| DEPTH MLD. | 11. 6 |

TO CLASS A FOR FERRY PURPOSES, LLOYD'S.
TO OBTAIN BOARD OF TRADE CERTIFICATE FORM (No. 5)

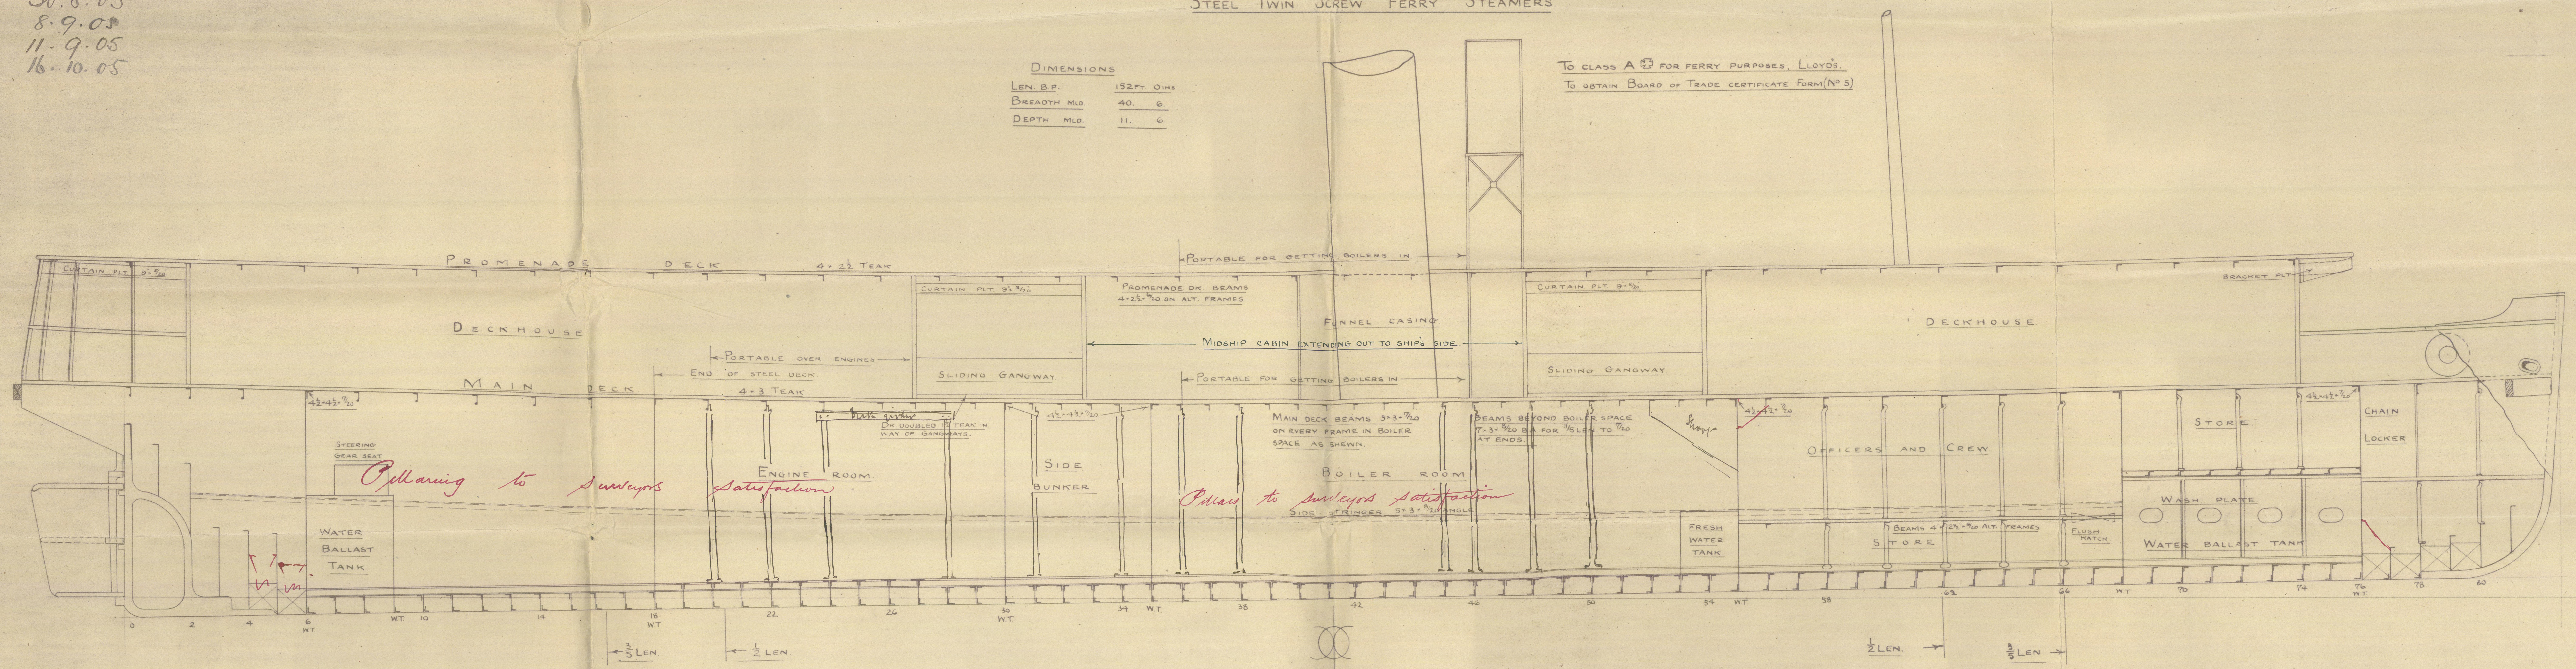

15409 19105
ROBERT STEVENSON & CO.
ENGINEERS
24/8/05
JOHN H. HARRIS
SHIP BUILDERS
HEBBURN-ON-TYNE

002536-002542-0126 1/2

ENCLOSURE




From ROBERT STEPHENSON & Co., Ltd.,
for Lloyd's Register
Foundation

Lloyds Surveyors

R. Stephenson & Co Ltd

SS s. N^o 100 & 101.

Profile and deck plan

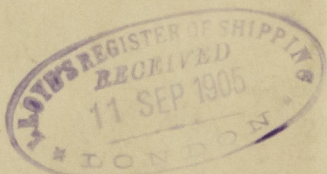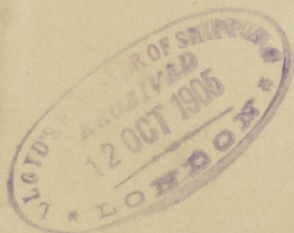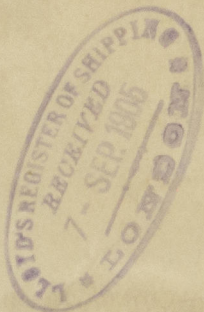

Blatney

G.P. "Iris" ex

Newcastle Report

N^o 51012



© 2020

Lloyd's Register

002536-002542-0126 2/2