

S. 5 N<sup>o</sup> 498 & 9

RUDDER & STERNPOST

SCALE: 1/8" = 1 FOOT

RUDDER: FORGED

STERNPOST: CAST STEEL

ALL TO LLOYD'S REQUIREMENTS

SPEED 12 1/2 KNOTS

DRAFT 23'-9" MLD


A x D = 1475 x 3-30 = 495

DETAILS: SCALE 3" = 1 FOOT

RUDDER AREA & C.G.			
1	3.20	1/2	1.60
2	4.80	2	9.60
3	6.00	1	6.00
4	6.75	2	13.50
5	7.20	1	7.20
6	7.20	2	14.40
7	7.20	1	7.20
8	7.20	2	14.40
9	7.20	1	7.20
10	7.20	2	14.40
11	5.00	1/2	2.50
TOTAL		30.35	330.84
2.25 x 2		4.50	3.36
TOTAL		34.85	334.20
COMMON INTERVAL		2.25	

ALEX. STEPHENSON & SONS LTD.  
SHIPBUILDERS & ENGINEERS  
GLASGOW.

PLAN NO. 4 DATE 27-1-21

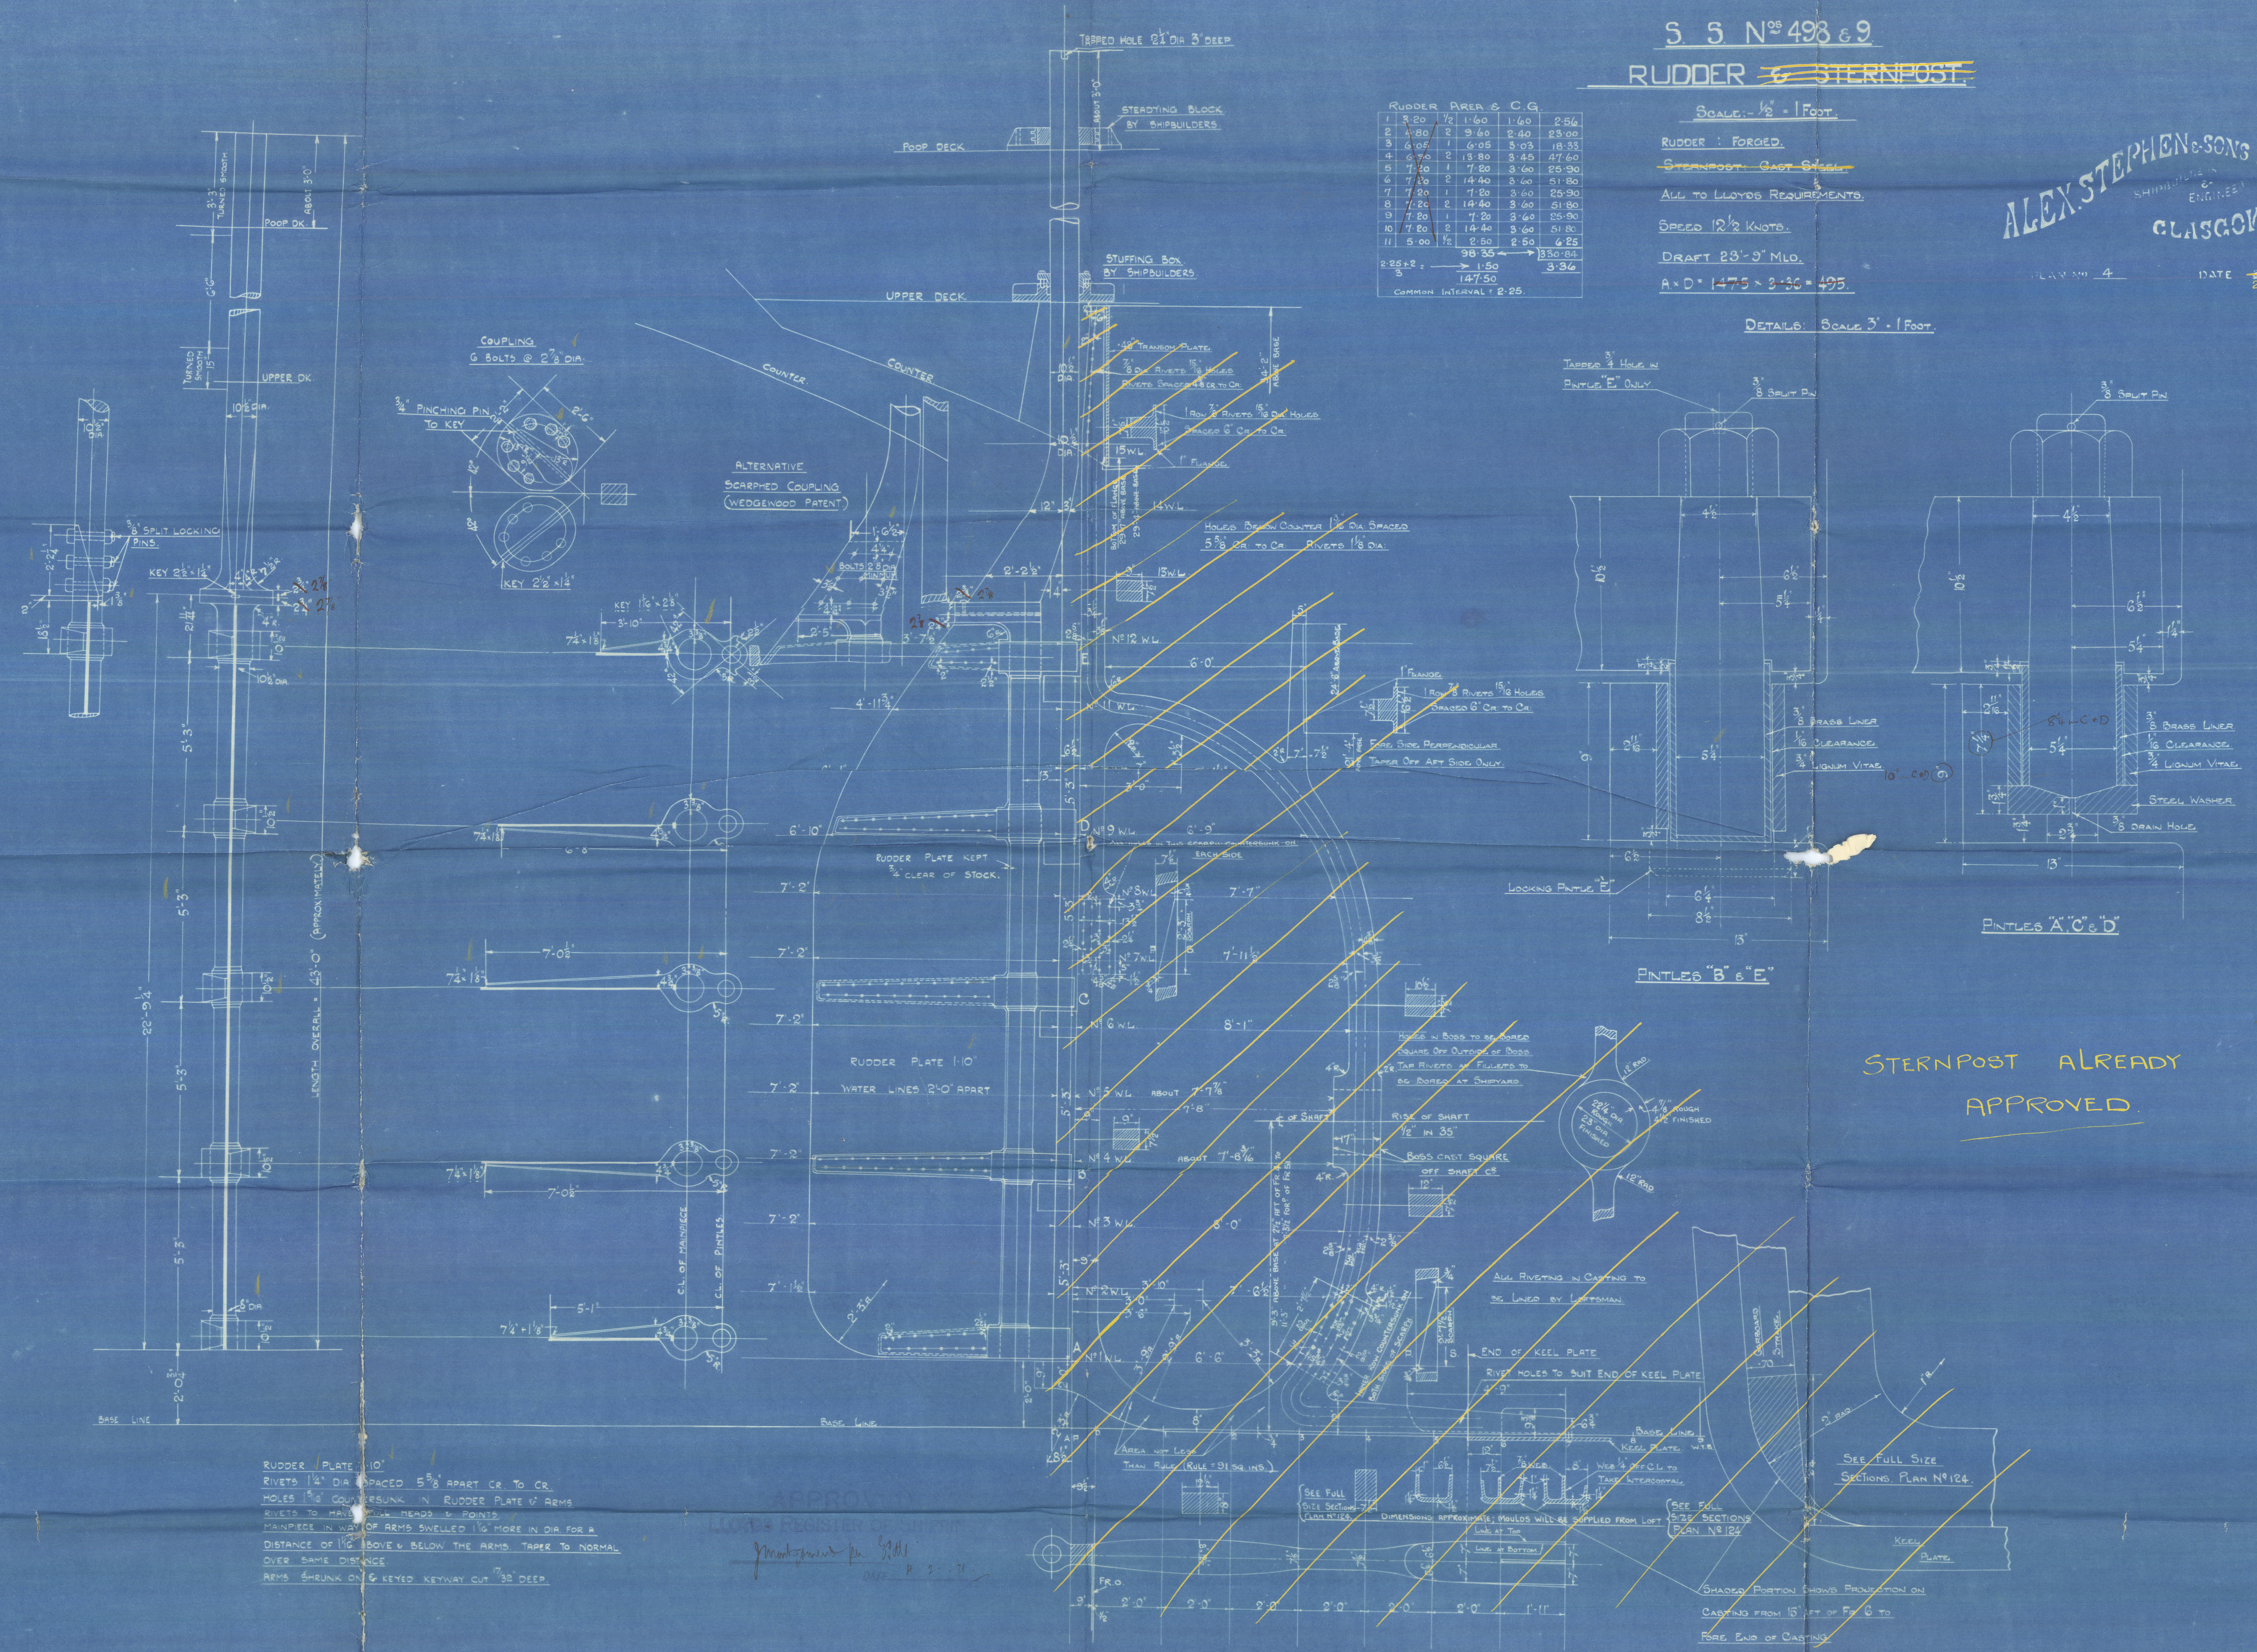

STERNPOST ALREADY  
APPROVED

APPROVED  
REGISTER OF SHIPS  
MONTAGU & CO. LTD.  
LONDON



Shiphins no 498-9

Rudder Plan  
app.

Ormiston

498

"Gamaka"

GLASGOW REPORT No.


42370

No 499

GLASGOW REPORT No.

42484

"Seyara"

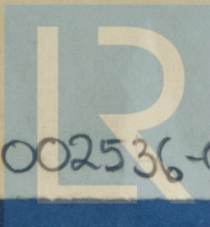

© 2020

002536-002542-0222 Register  
Foundation