


S. S. N° 131. MIDSHIP SECTION.

DIMENSIONS.

LENGTH B.P.	281'-0"
BREADTH MLD	43'-6"
DEPTH MLD	20'-7"

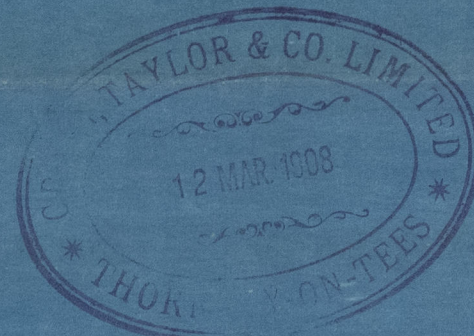

HIGHEST CLASS BRITISH CORPORATION

B.S.*


STEEL

SPACING

EQUIPMENT.

HULL	281 x 43.5 x 20.6 x 785	1976.6
POOP	26 x 43 x 7 x 65	50.86
BRIDGE	74 x 68 x 43 x 7 x 75	153.51
F'CLE	33 x 29 x 43 x 7 x 55	48.00

EQUIPMENT N° 222697

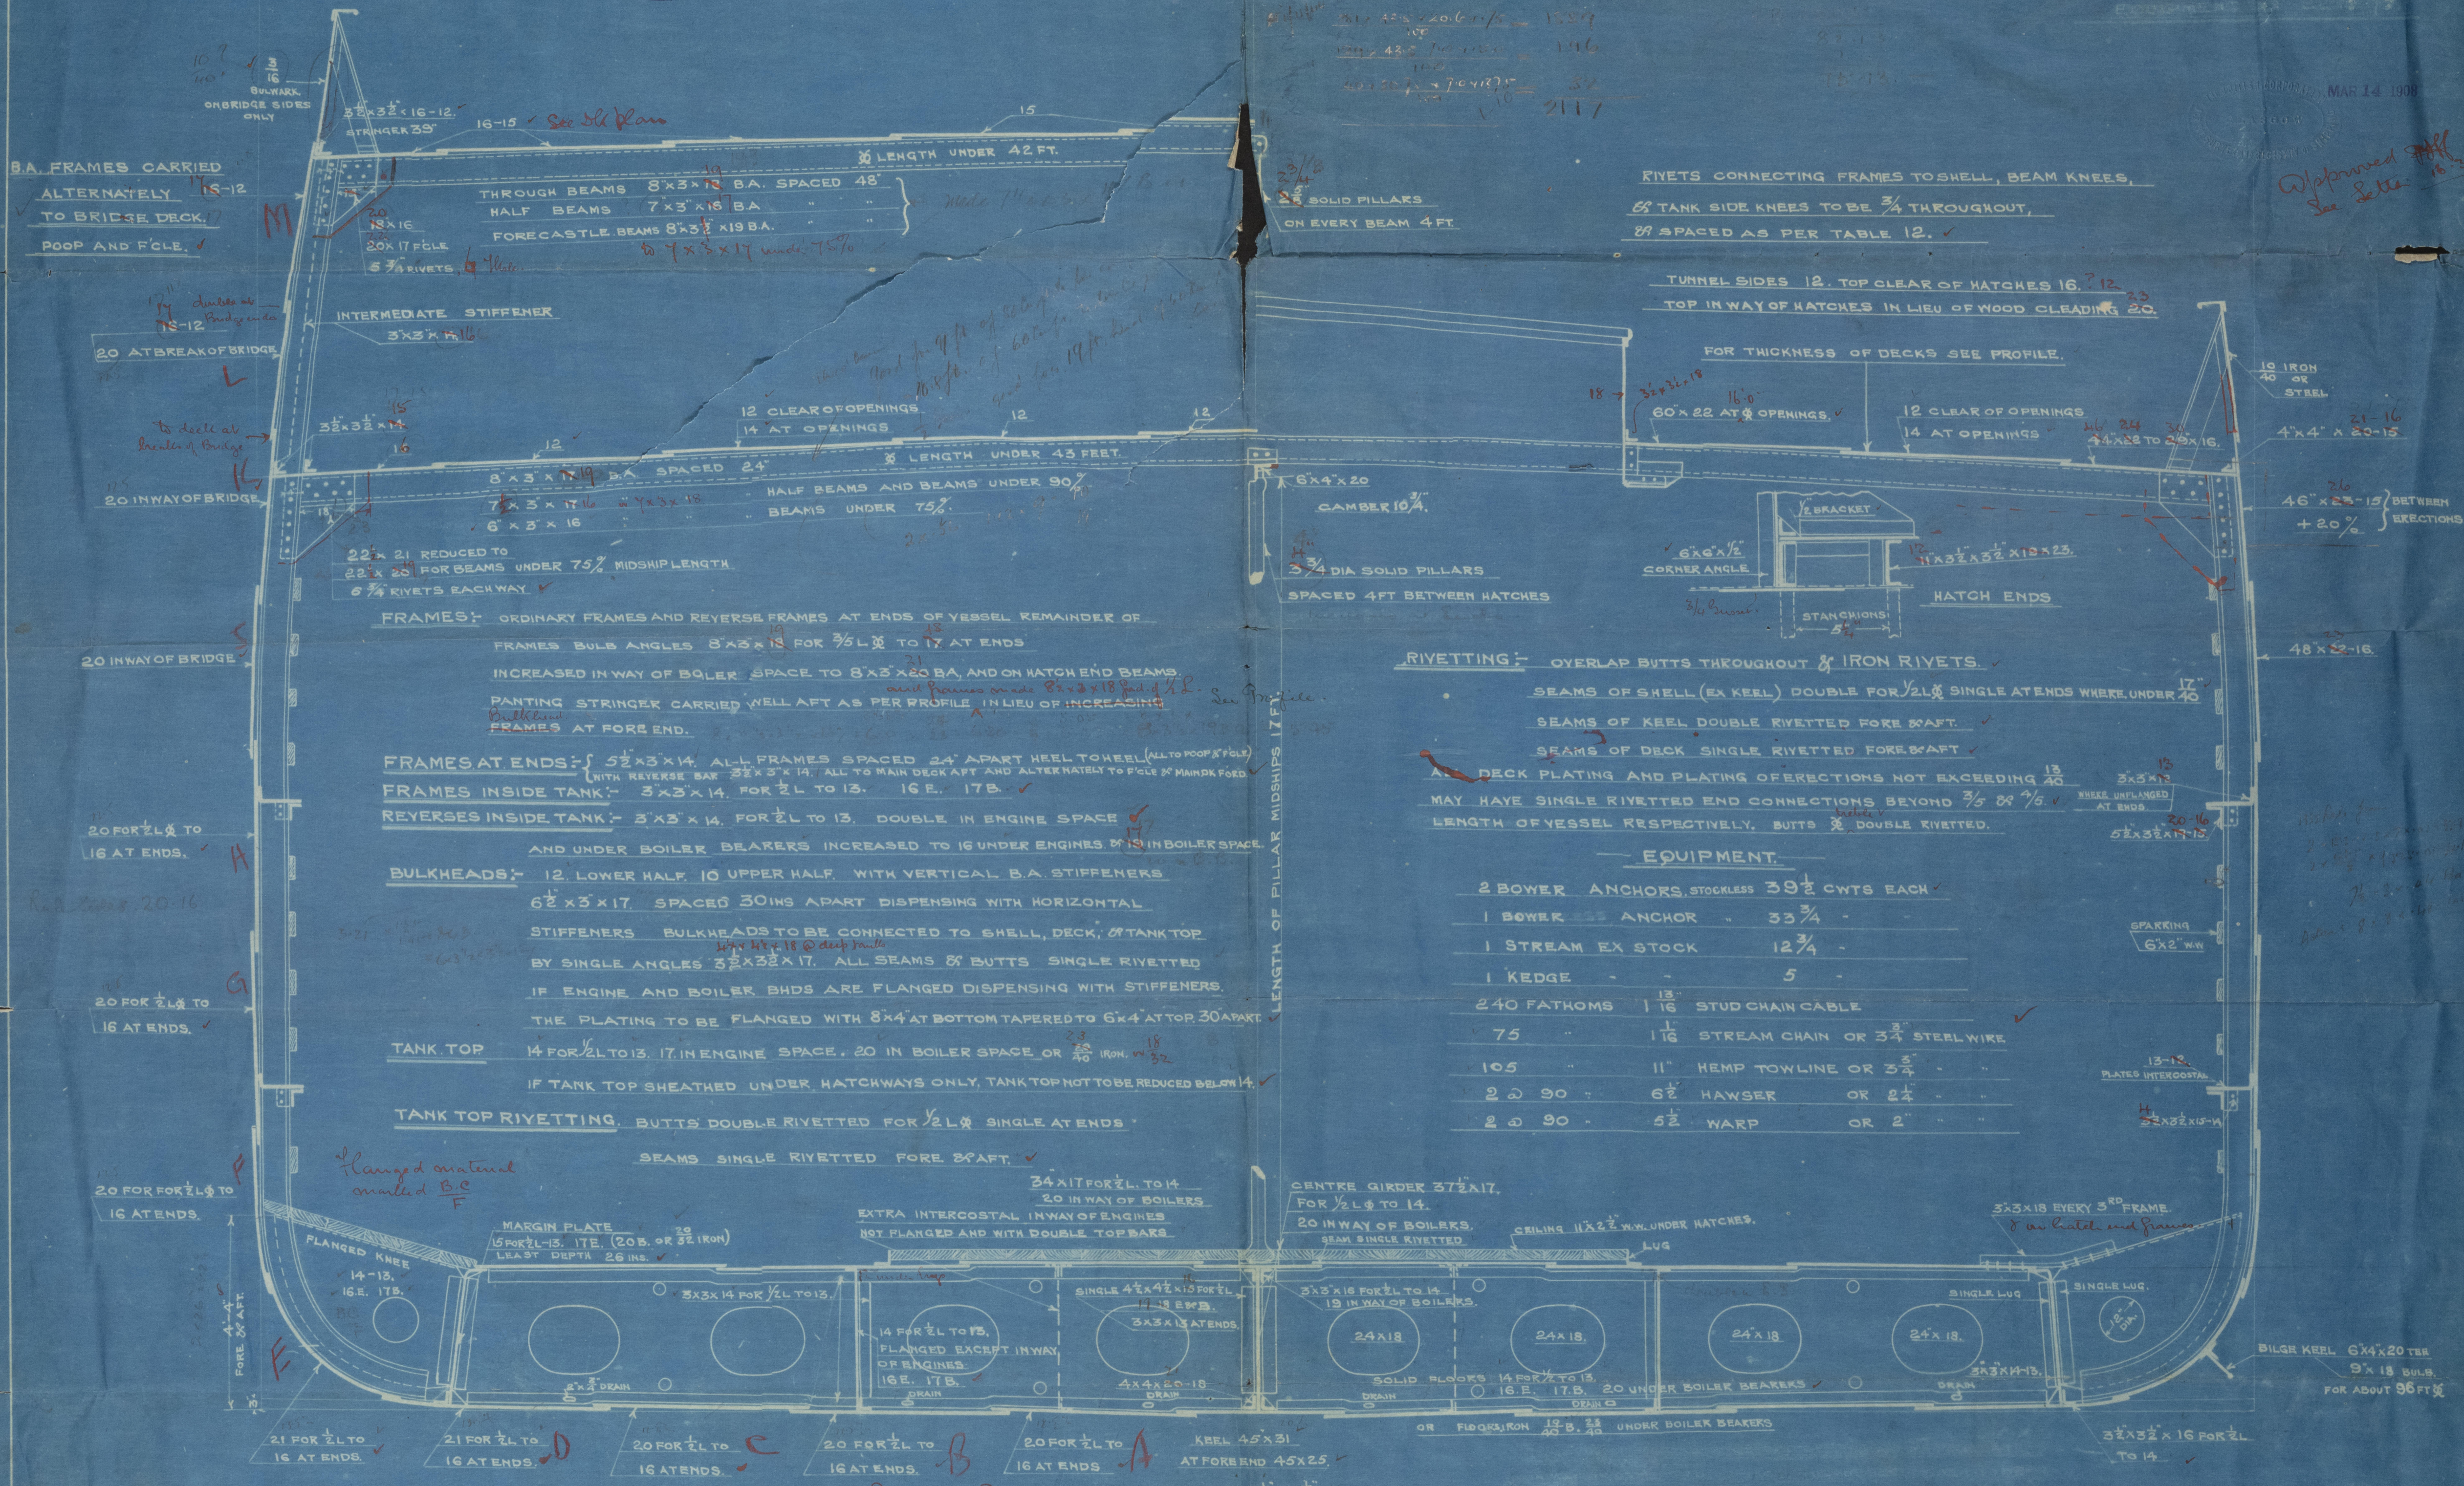

RIVETS CONNECTING FRAMES TO SHELL, BEAM KNEES,

65 TANK SIDE KNEES TO BE 3/4 THROUGHOUT,
89 SPACED AS PER TABLE 12.

TUNNEL SIDES 12. TOP CLEAR OF HATCHES 16. 12.
TOP IN WAY OF HATCHES IN LIEU OF WOOD CLEADING 20.

FOR THICKNESS OF DECKS SEE PROFILE.

12 CLEAR OF OPENINGS
14 AT OPENINGS

60 x 22 AT OPENINGS.
12 CLEAR OF OPENINGS
14 AT OPENINGS

60 x 22 AT OPENINGS.
14 AT OPENINGS

EQUIPMENT.

2 BOWER ANCHORS, STOCKLESS	39 1/2 CWTs EACH
1 BOWER ANCHOR	33 3/4
1 STREAM EX STOCK	12 3/4
1 KEDGE	5
240 FATHOMS	1 1/2 STUD CHAIN CABLE
75	1 1/2 STREAM CHAIN OR 3 1/2 STEEL WIRE
105	11" HEMP TOWLINE OR 3 1/2
2 20 90	6 1/2 HAWSER OR 2 1/2
2 20 90	5 1/2 WARP OR 2

SECTION IN WAY OF ERECTIONS.

SECTION IN WELLS

STEM 8 1/2 x 2 1/2
STERN POST 7 1/2 x 2 1/2
RUDDERHEAD
PINTLES
PLATE



Lloyd's Register Foundation

