


DIMENSIONS 395.5' x 53' x 29' TO UPPER DK.

SCALE $\frac{1}{2}" = 1$ FOOT

TO CLASS 100 A.I. *

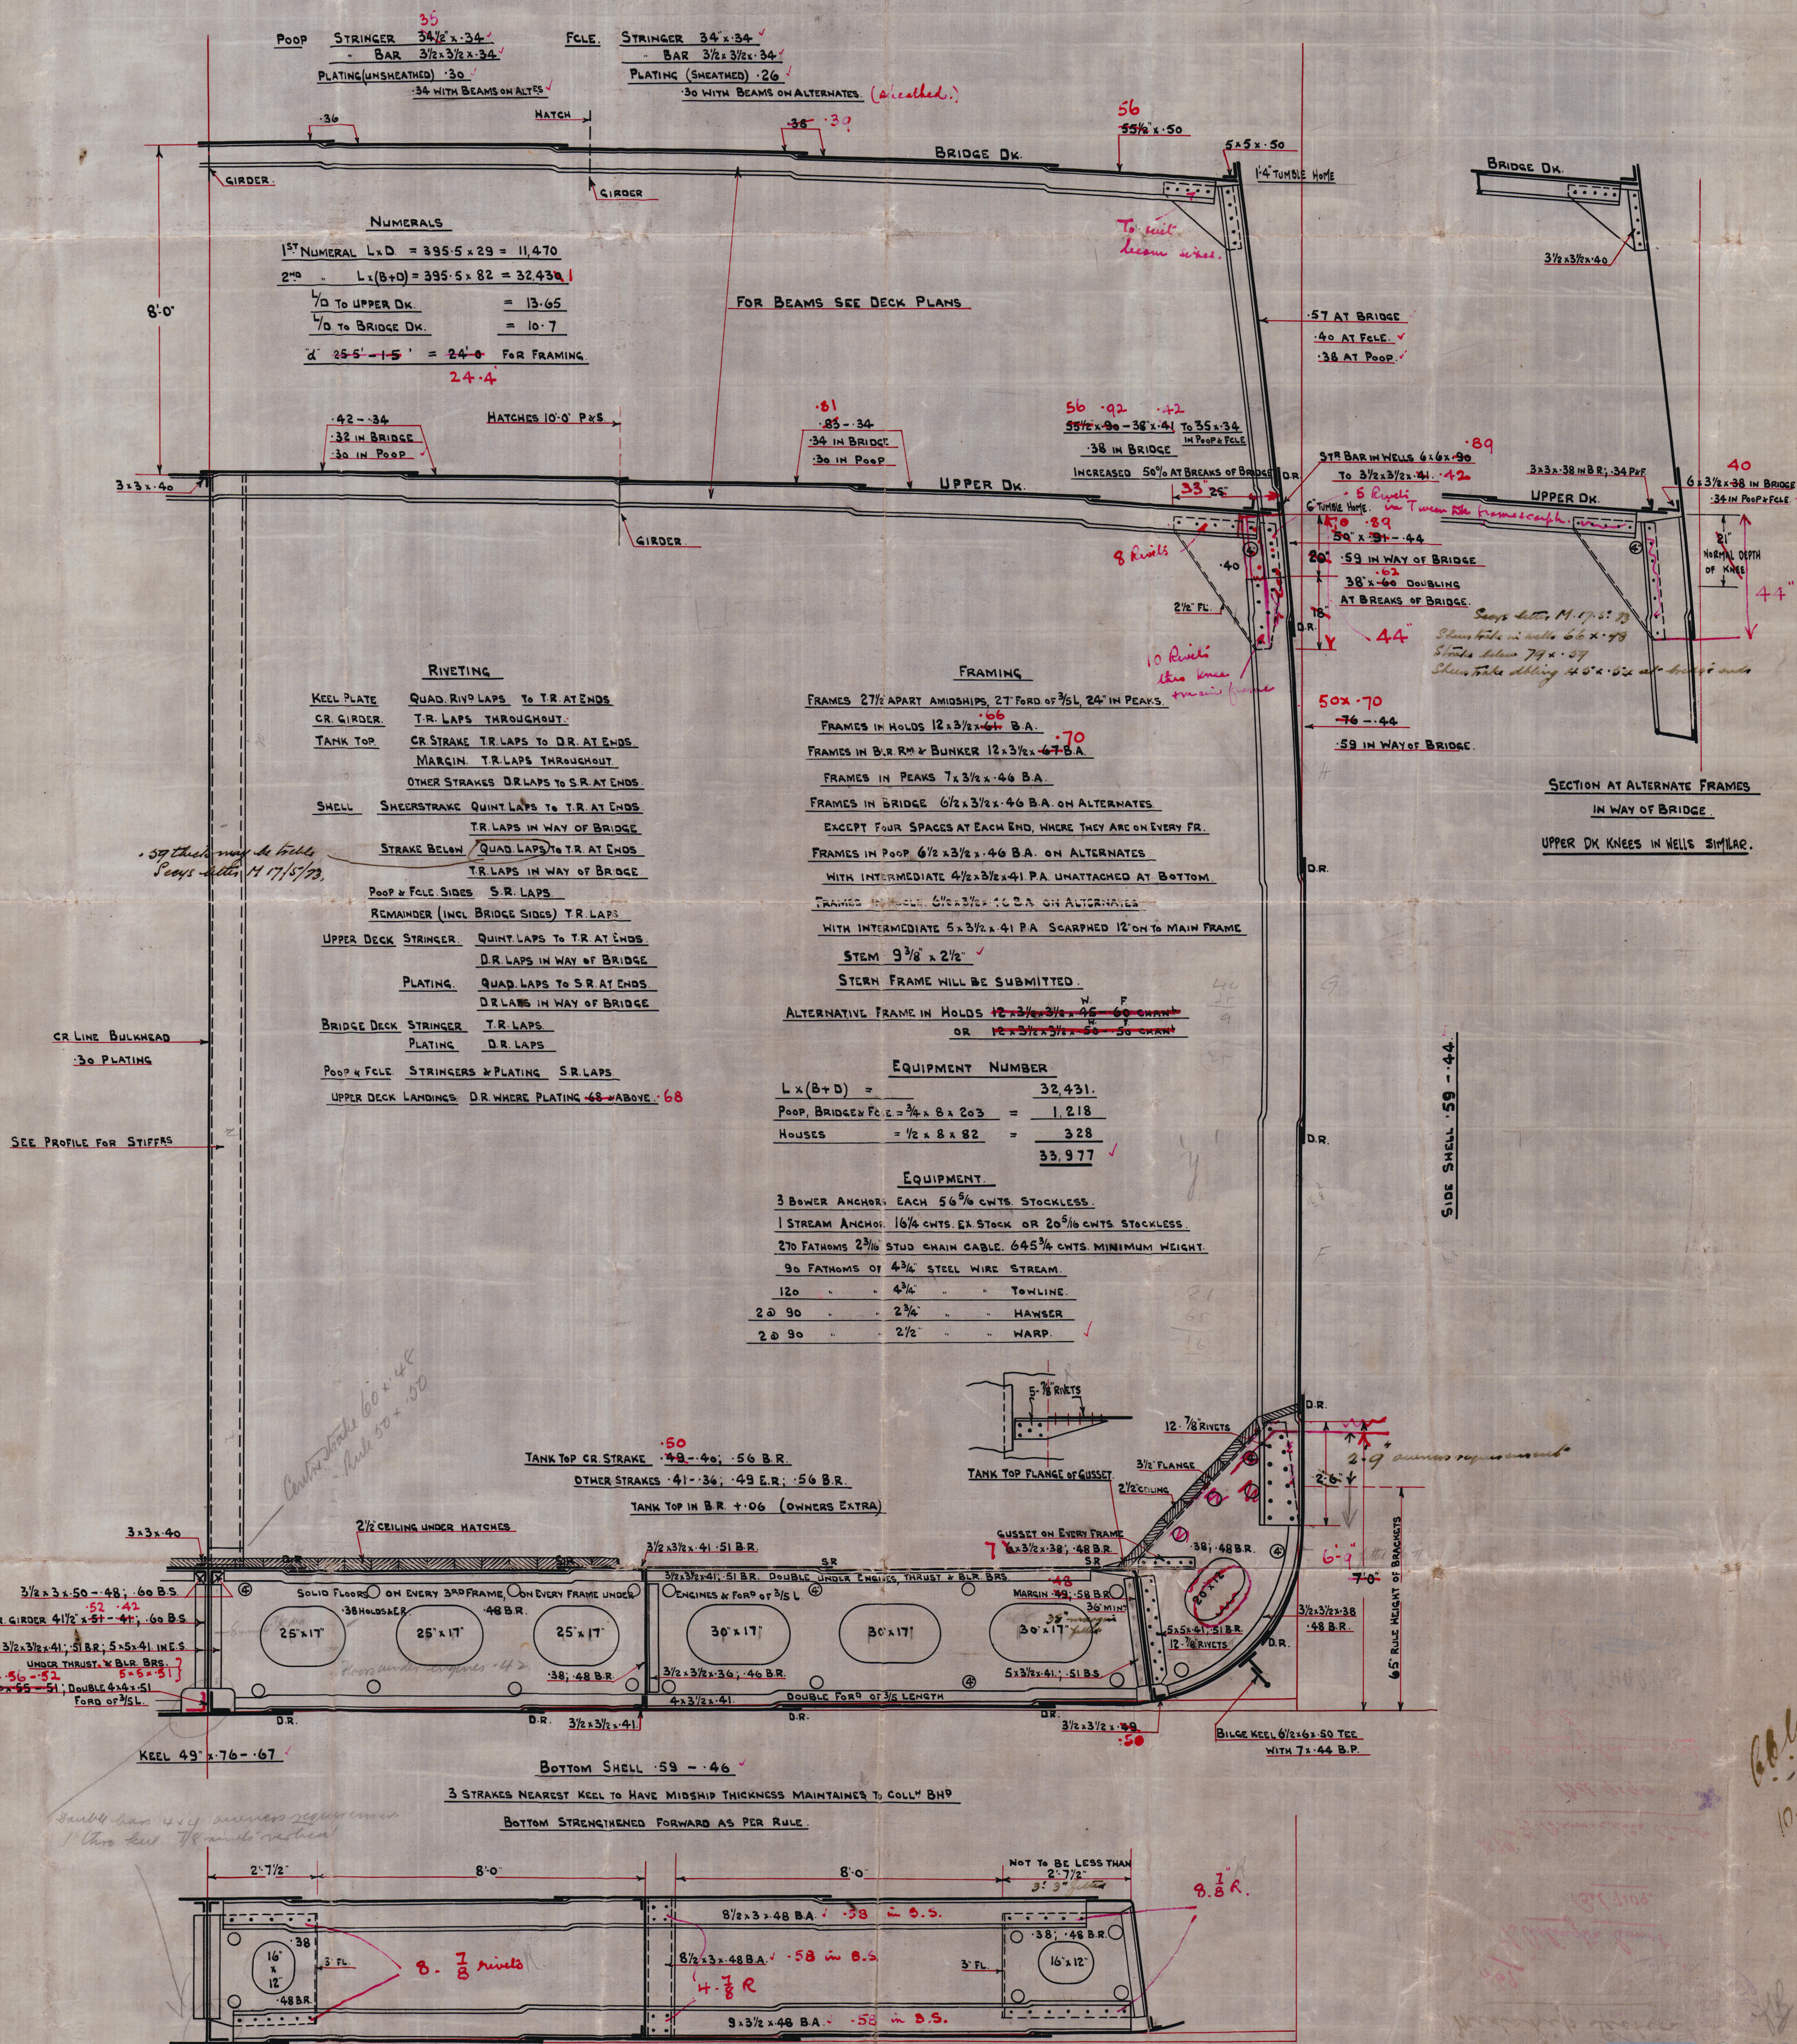

Workman Clark & Co

N^{os} 469 & 470

476

Midship Section

469

8/5 Arlington Court

Bel 9109.

470

8/5. Barrington Court

Bel. 9190 ★

476 Errington Court

Bel.

© 2020
W.N. "THARROS"

Lloyd's Register
Foundation

002543-002544-0132