
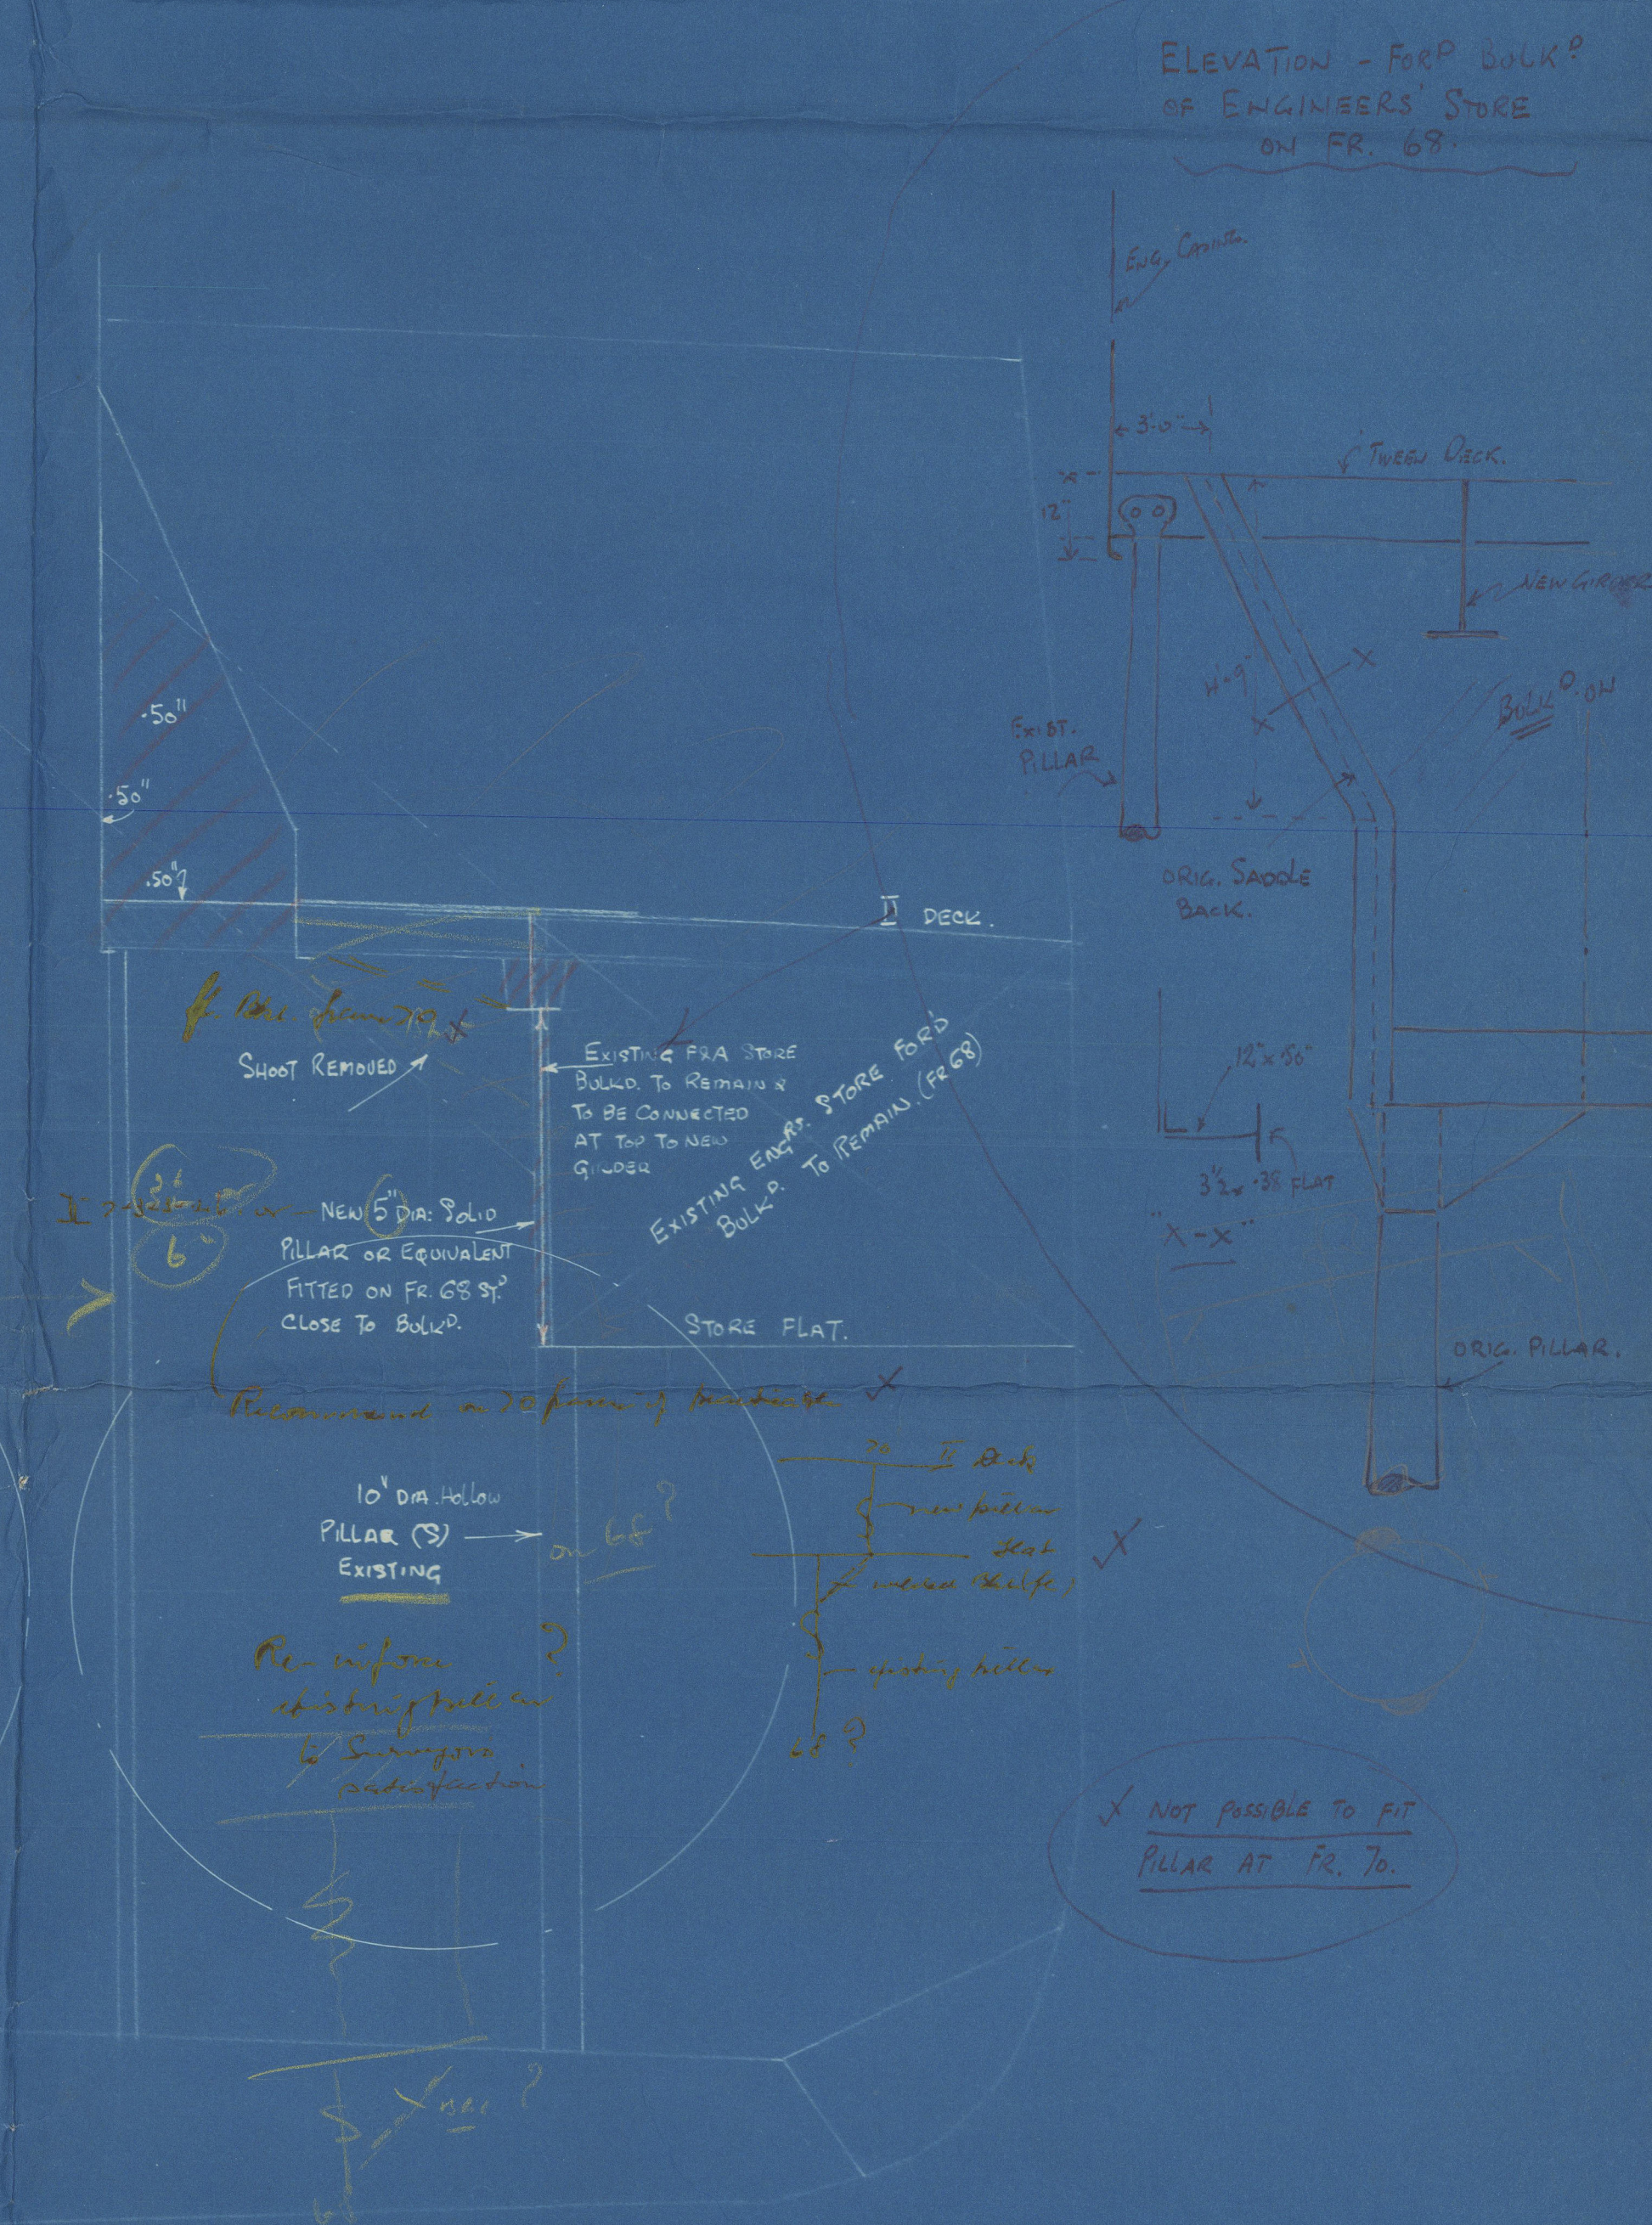
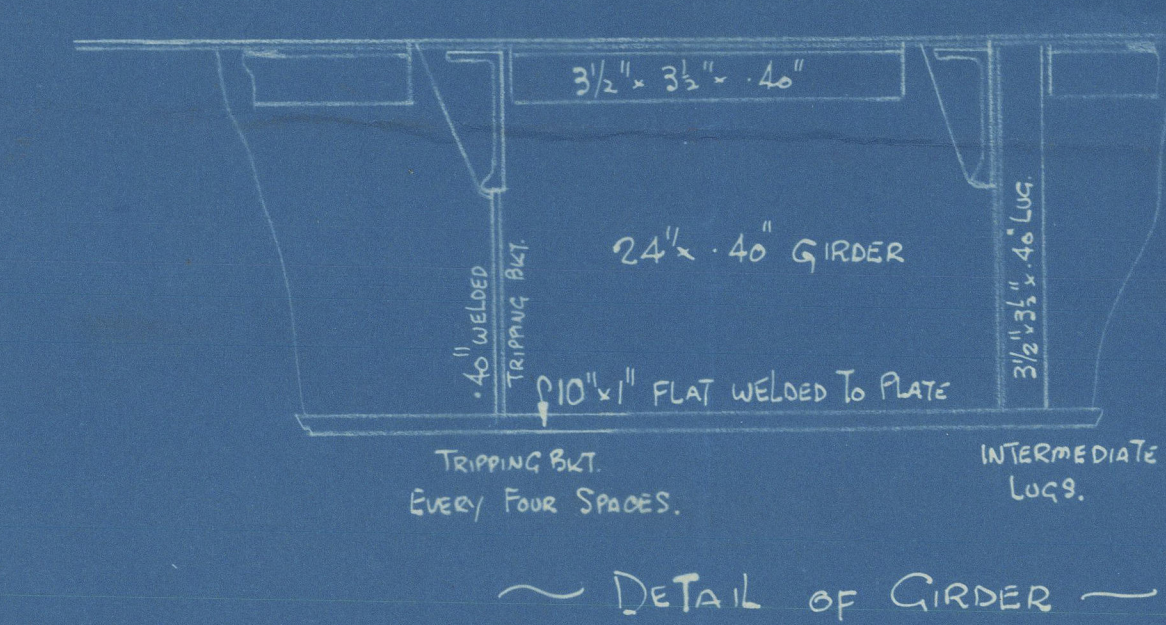
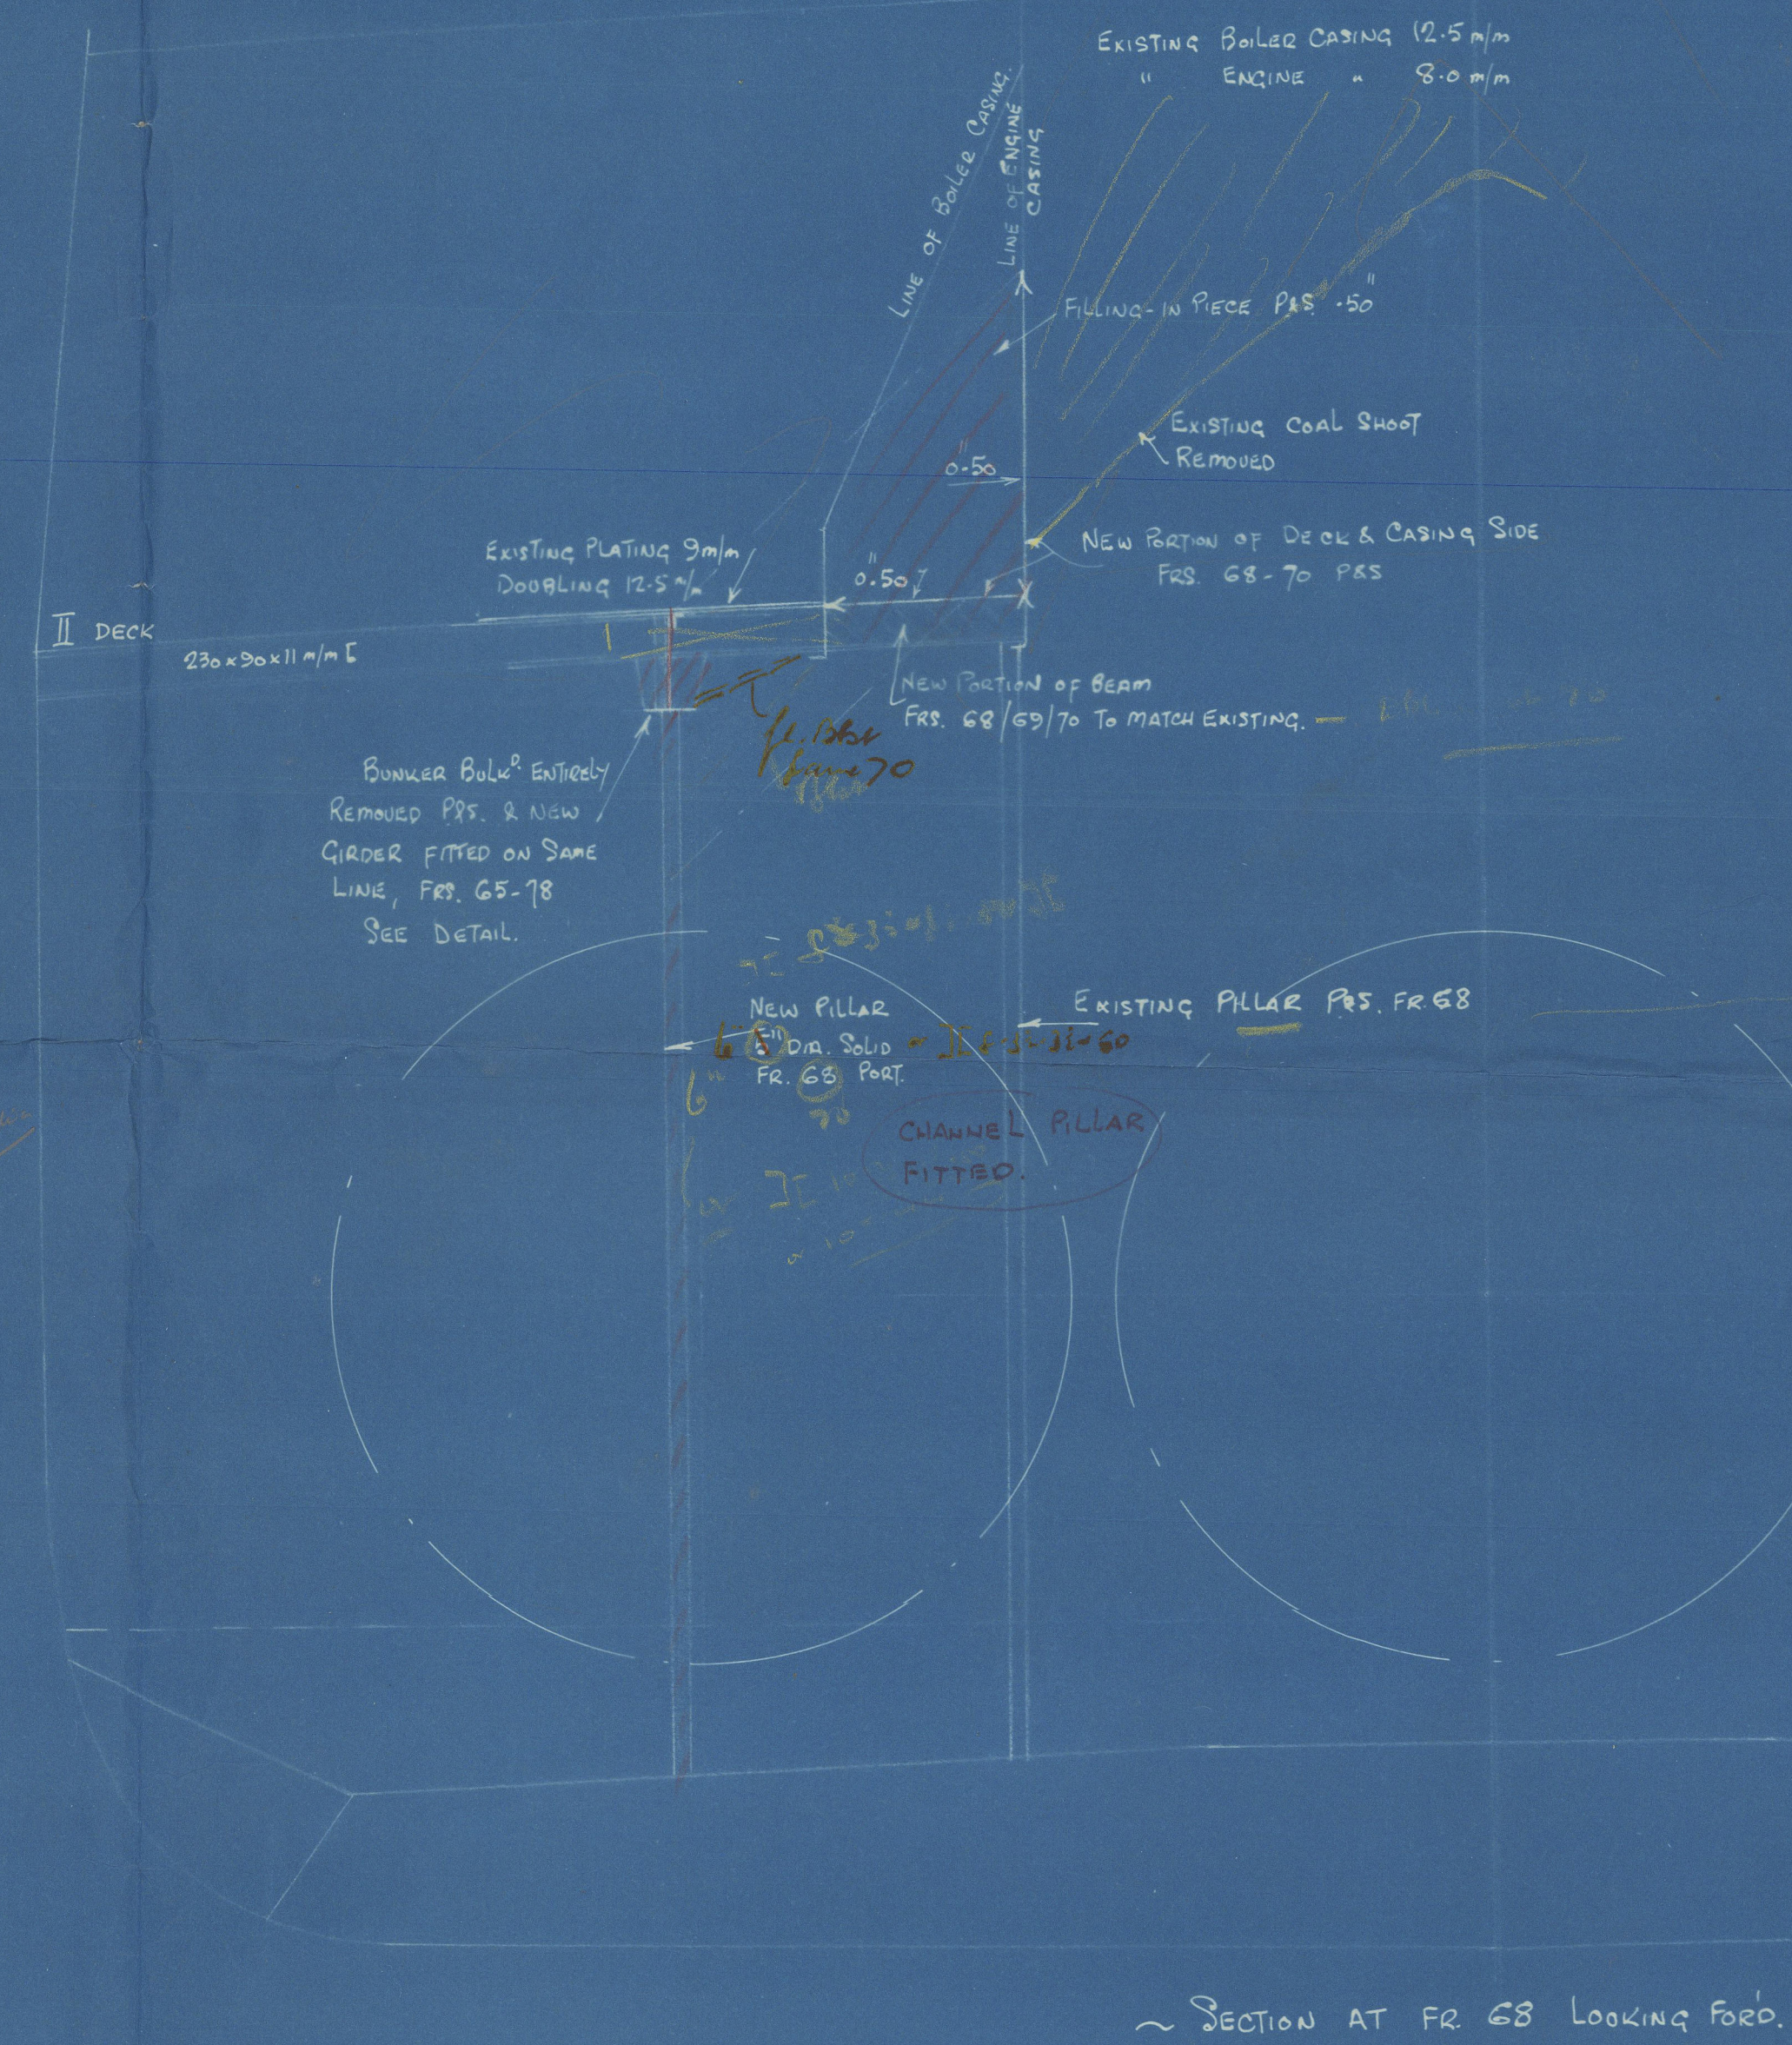


BENIN PALM

STRUCTURAL MODIFICATIONS DUE TO REMOVING BUNKER BULKHEAD

SCALE 1:40.

AS FITTED ITEMS
SHOWN IN BLUE INK
AND CIRCLED.

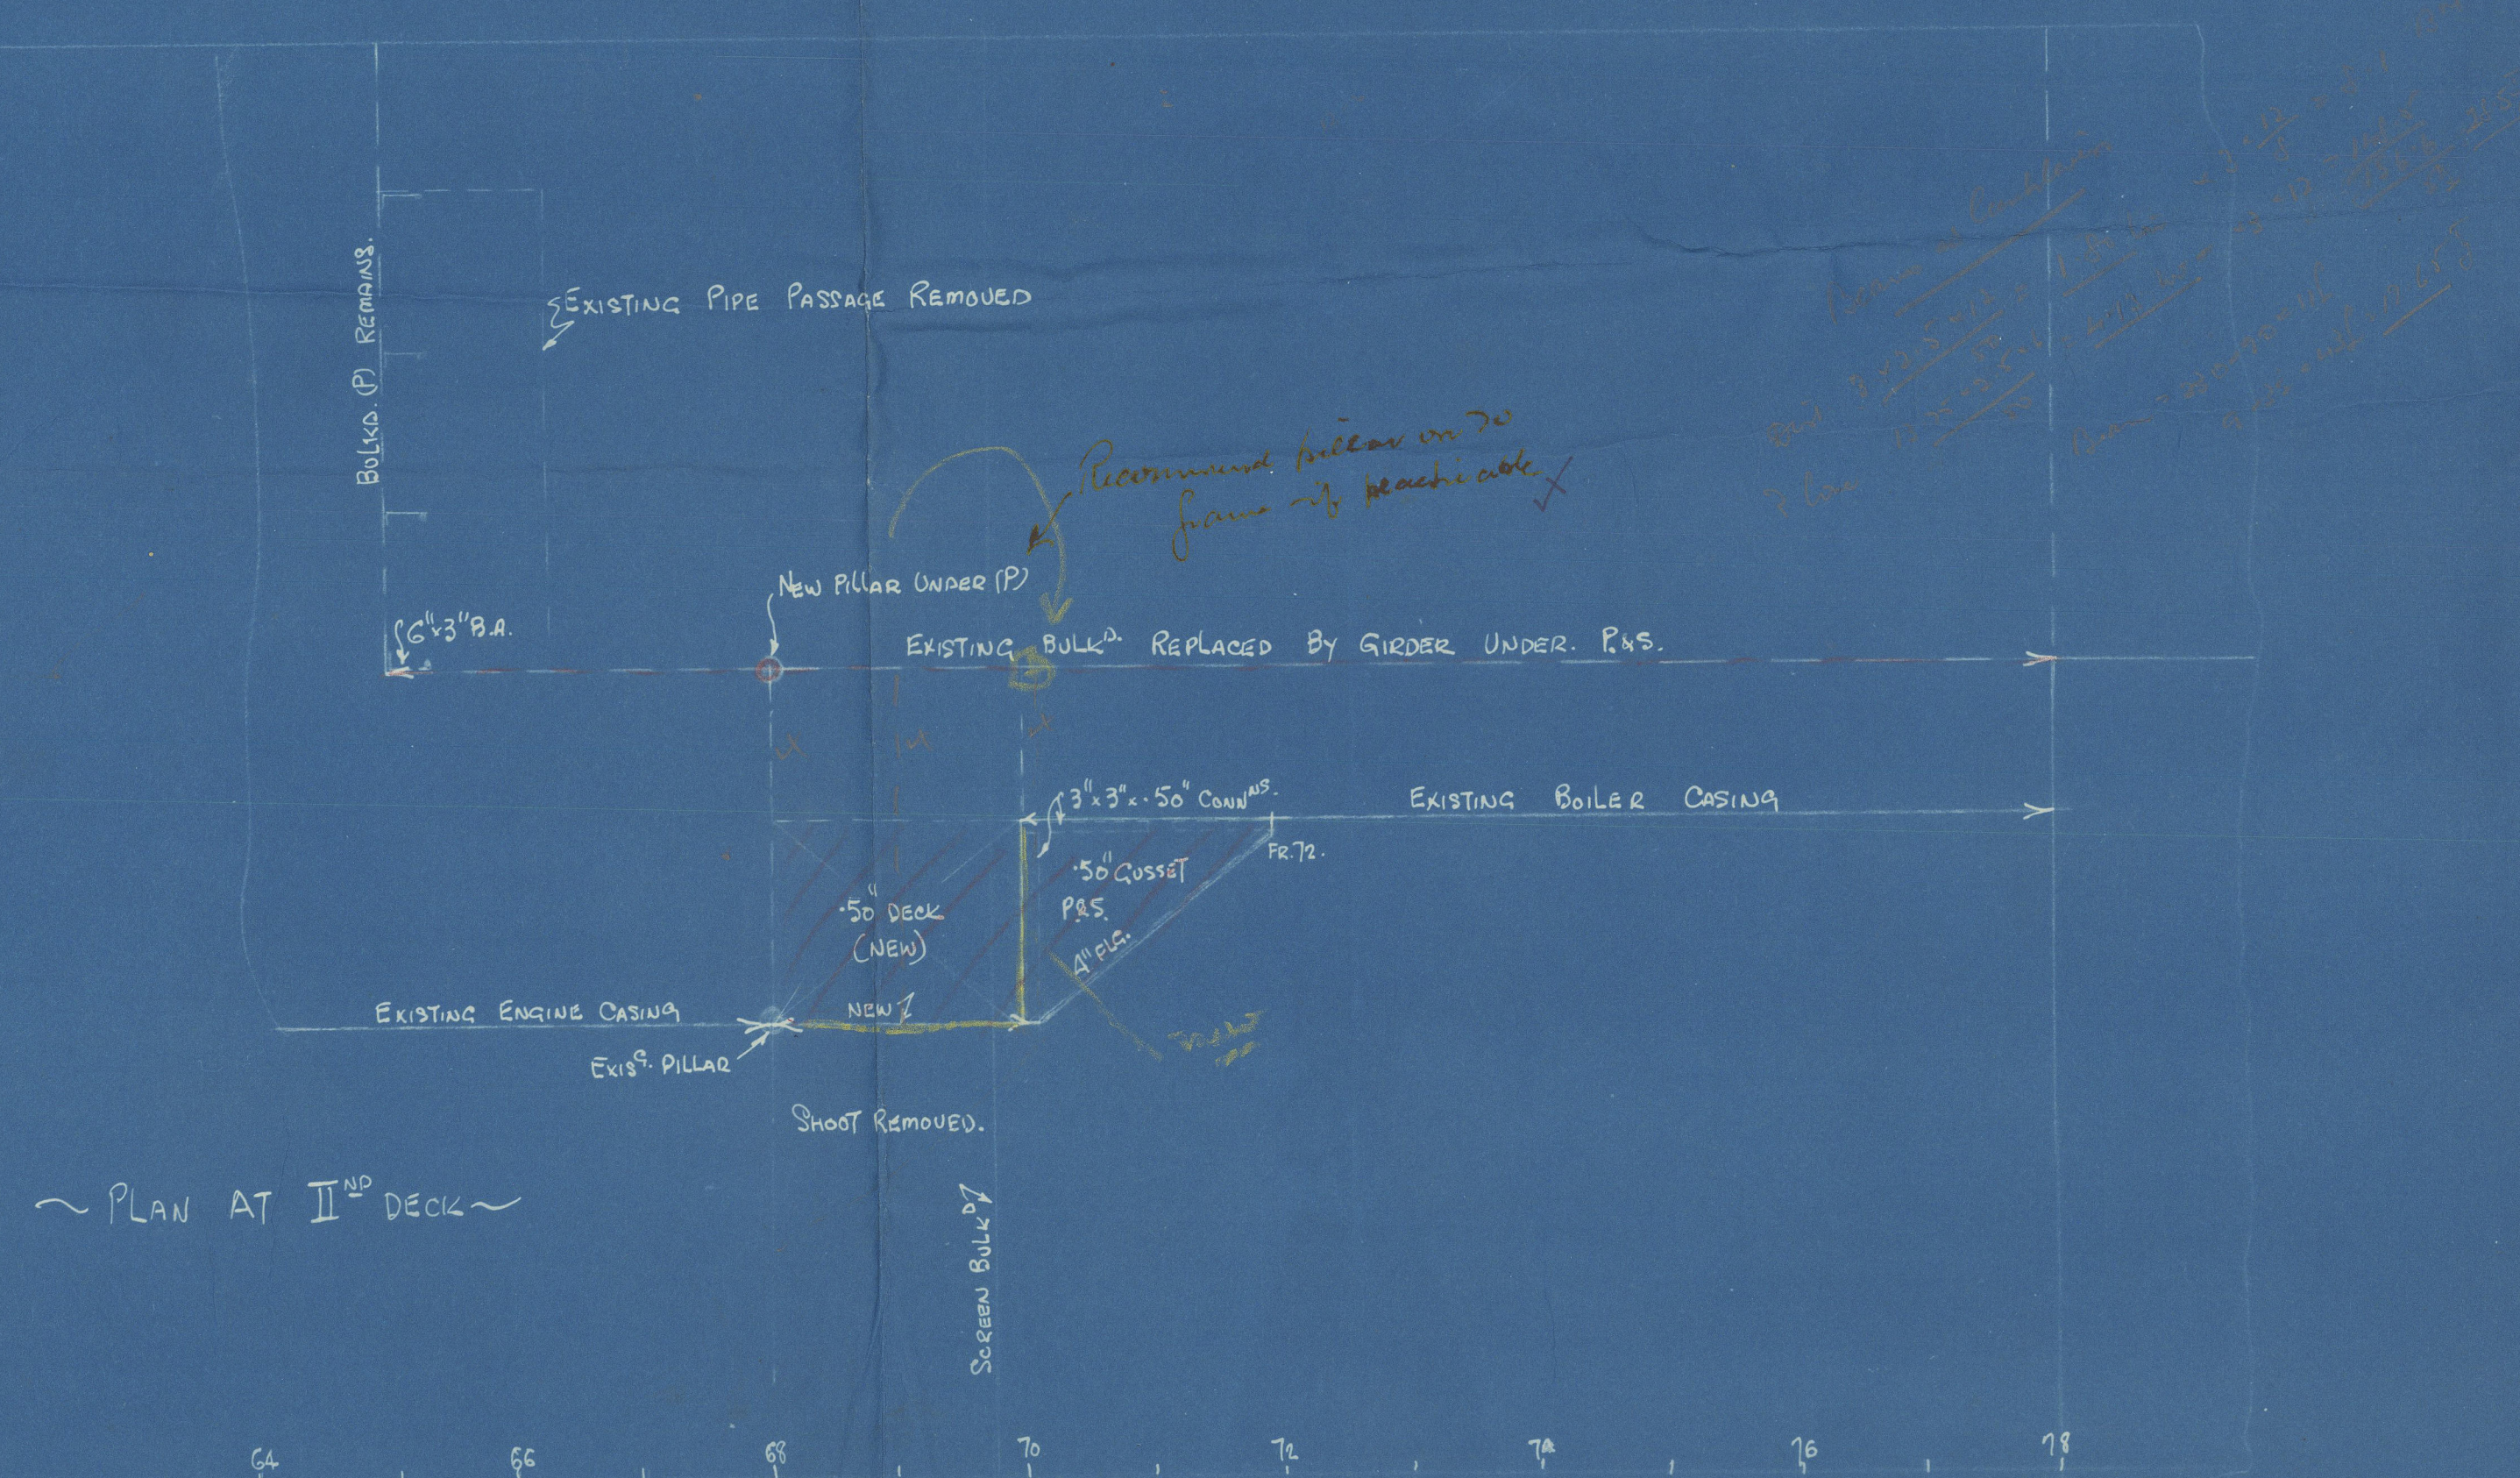

Open

11/1/2007
20.6.51
LLOYD'S REGISTER OF SHIPPING

16-0-91
3-9-8
12-13-9

$\frac{2}{3}$ Benin Palm

Structural Alterations in Wing
of Bunker Bho's.



© 2020

Lloyd's Register
Foundation

002543-002549-0207

'Beim Palm'

Rpt. No. Lic. 133944



© 2020

Lloyd's Register
Foundation