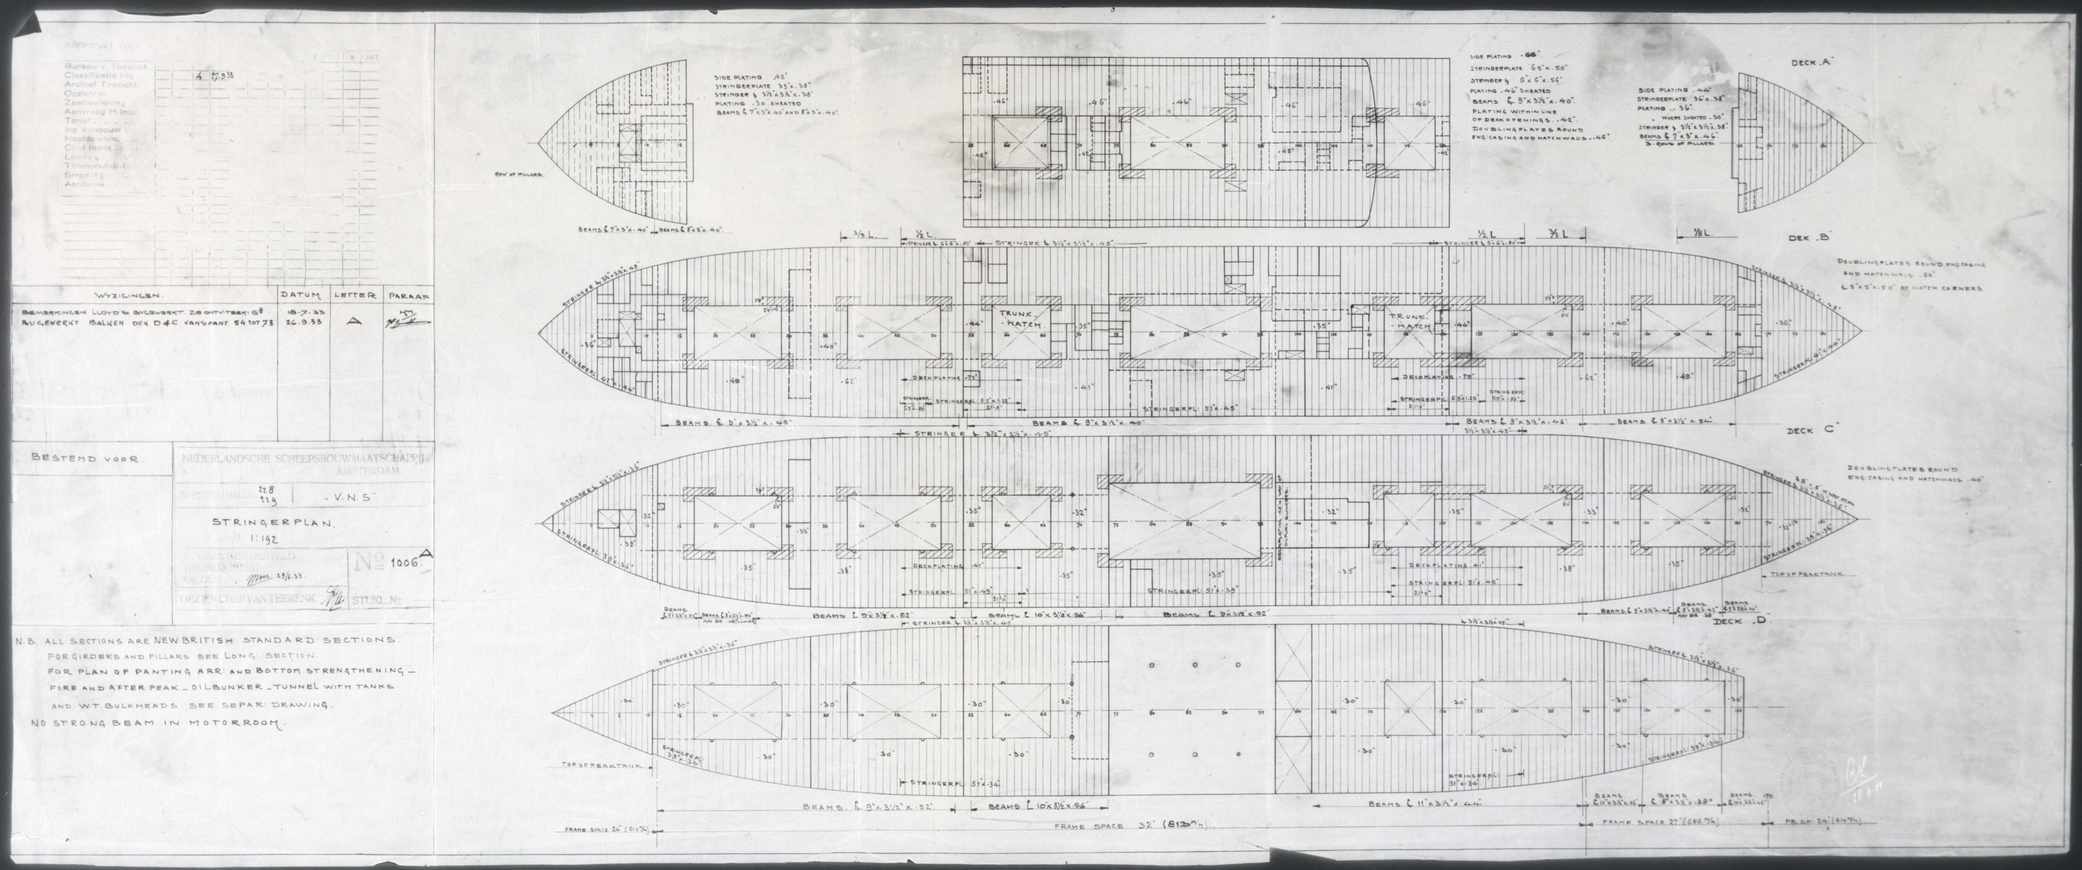

WYZIGINGEN.
DATUM
LETTER
PARAAF
BEMERKINGEN LLOYD'S GIVGEWERKT ZE ONTV'TEEK 8e AUGEWERKT BALKEN DEK D & C VANSPANT 54 TOT 78
18.7.33
26.9.33
BESTEMD VOOR
NEDERLANDSCHE SCHEEPSBOUWMAATSCHAPPIJ AMSTERDAM
- V.N.S.
STRINGERPLAN.
1:192
No 1006
N.B. ALL SECTIONS ARE NEW BRITISH STANDARD SECTIONS.
FOR GIRDERS AND PILLARS SEE LONG: SECTION.
FOR PLAN OF PANTING ARR: AND BOTTOM STRENGTHENING -
FORE AND AFTER PEAK - OILBUNKER - TUNNEL WITH TANKS
AND W.T. BULKHEADS SEE SEPAR: DRAWING.
NO STRONG BEAM IN MOTORROOM.
DECK A
DECK B
DECK C
DECK D
TRUNK HATCH
TRUNK HATCH
FRAME SPACE 32" (812 m/m)