

# NUMERALS

L x D ----- 2482  
L x (B + D) ----- 7034

## EQUIPMENT

1" BOWER ANCHOR 10 1/4 CWTs STOCKLESS.  
2" " " 9 1/2 " " "  
KEDGE ANCHOR 4 " " EX STOCK.  
150 FMS. 1/8" STUD LINK CABLE.  
60 " 6" HAWSER  
60 " 5 1/2" WARP.

# MIDSHIP SECTION. STEEL SCREW TRAWLERS

N<sup>OS</sup> 1175-1176 & 1177.

165'-6" B.P. x 27'-6" MLD x 15'-0" MLD.

TO CLASS X 100 A.I. STM TRAWLERS.

## RIVETING.


ALL LANDING EDGES TO BE DOUBLE RIVETED  
EXCEPT TOP EDGE OF SHEERSTRAKE WHICH IS  
TO BE SINGLE RIVETED.

BUTTS OF GARBOARD AND SHEERSTRAKE  
STRAPPED AND TREBLE RIVETED FOR 1/2 LENGTH.  
STRAPPED AND DOUBLE RIVETED AT ENDS.

BUTTS OF E & F STRAKES OVERLAPPED AND  
TREBLE RIVETED FOR 1/2 LENGTH, OVERLAPPED  
AND DOUBLE RIVETED AT ENDS.

REMAINDER OF BUTTS OVERLAPPED AND DOUBLE  
RIVETED ALL FORE AND AFT.

SHELL RIVETS TO BE STEEL - REMAINDER IRON.

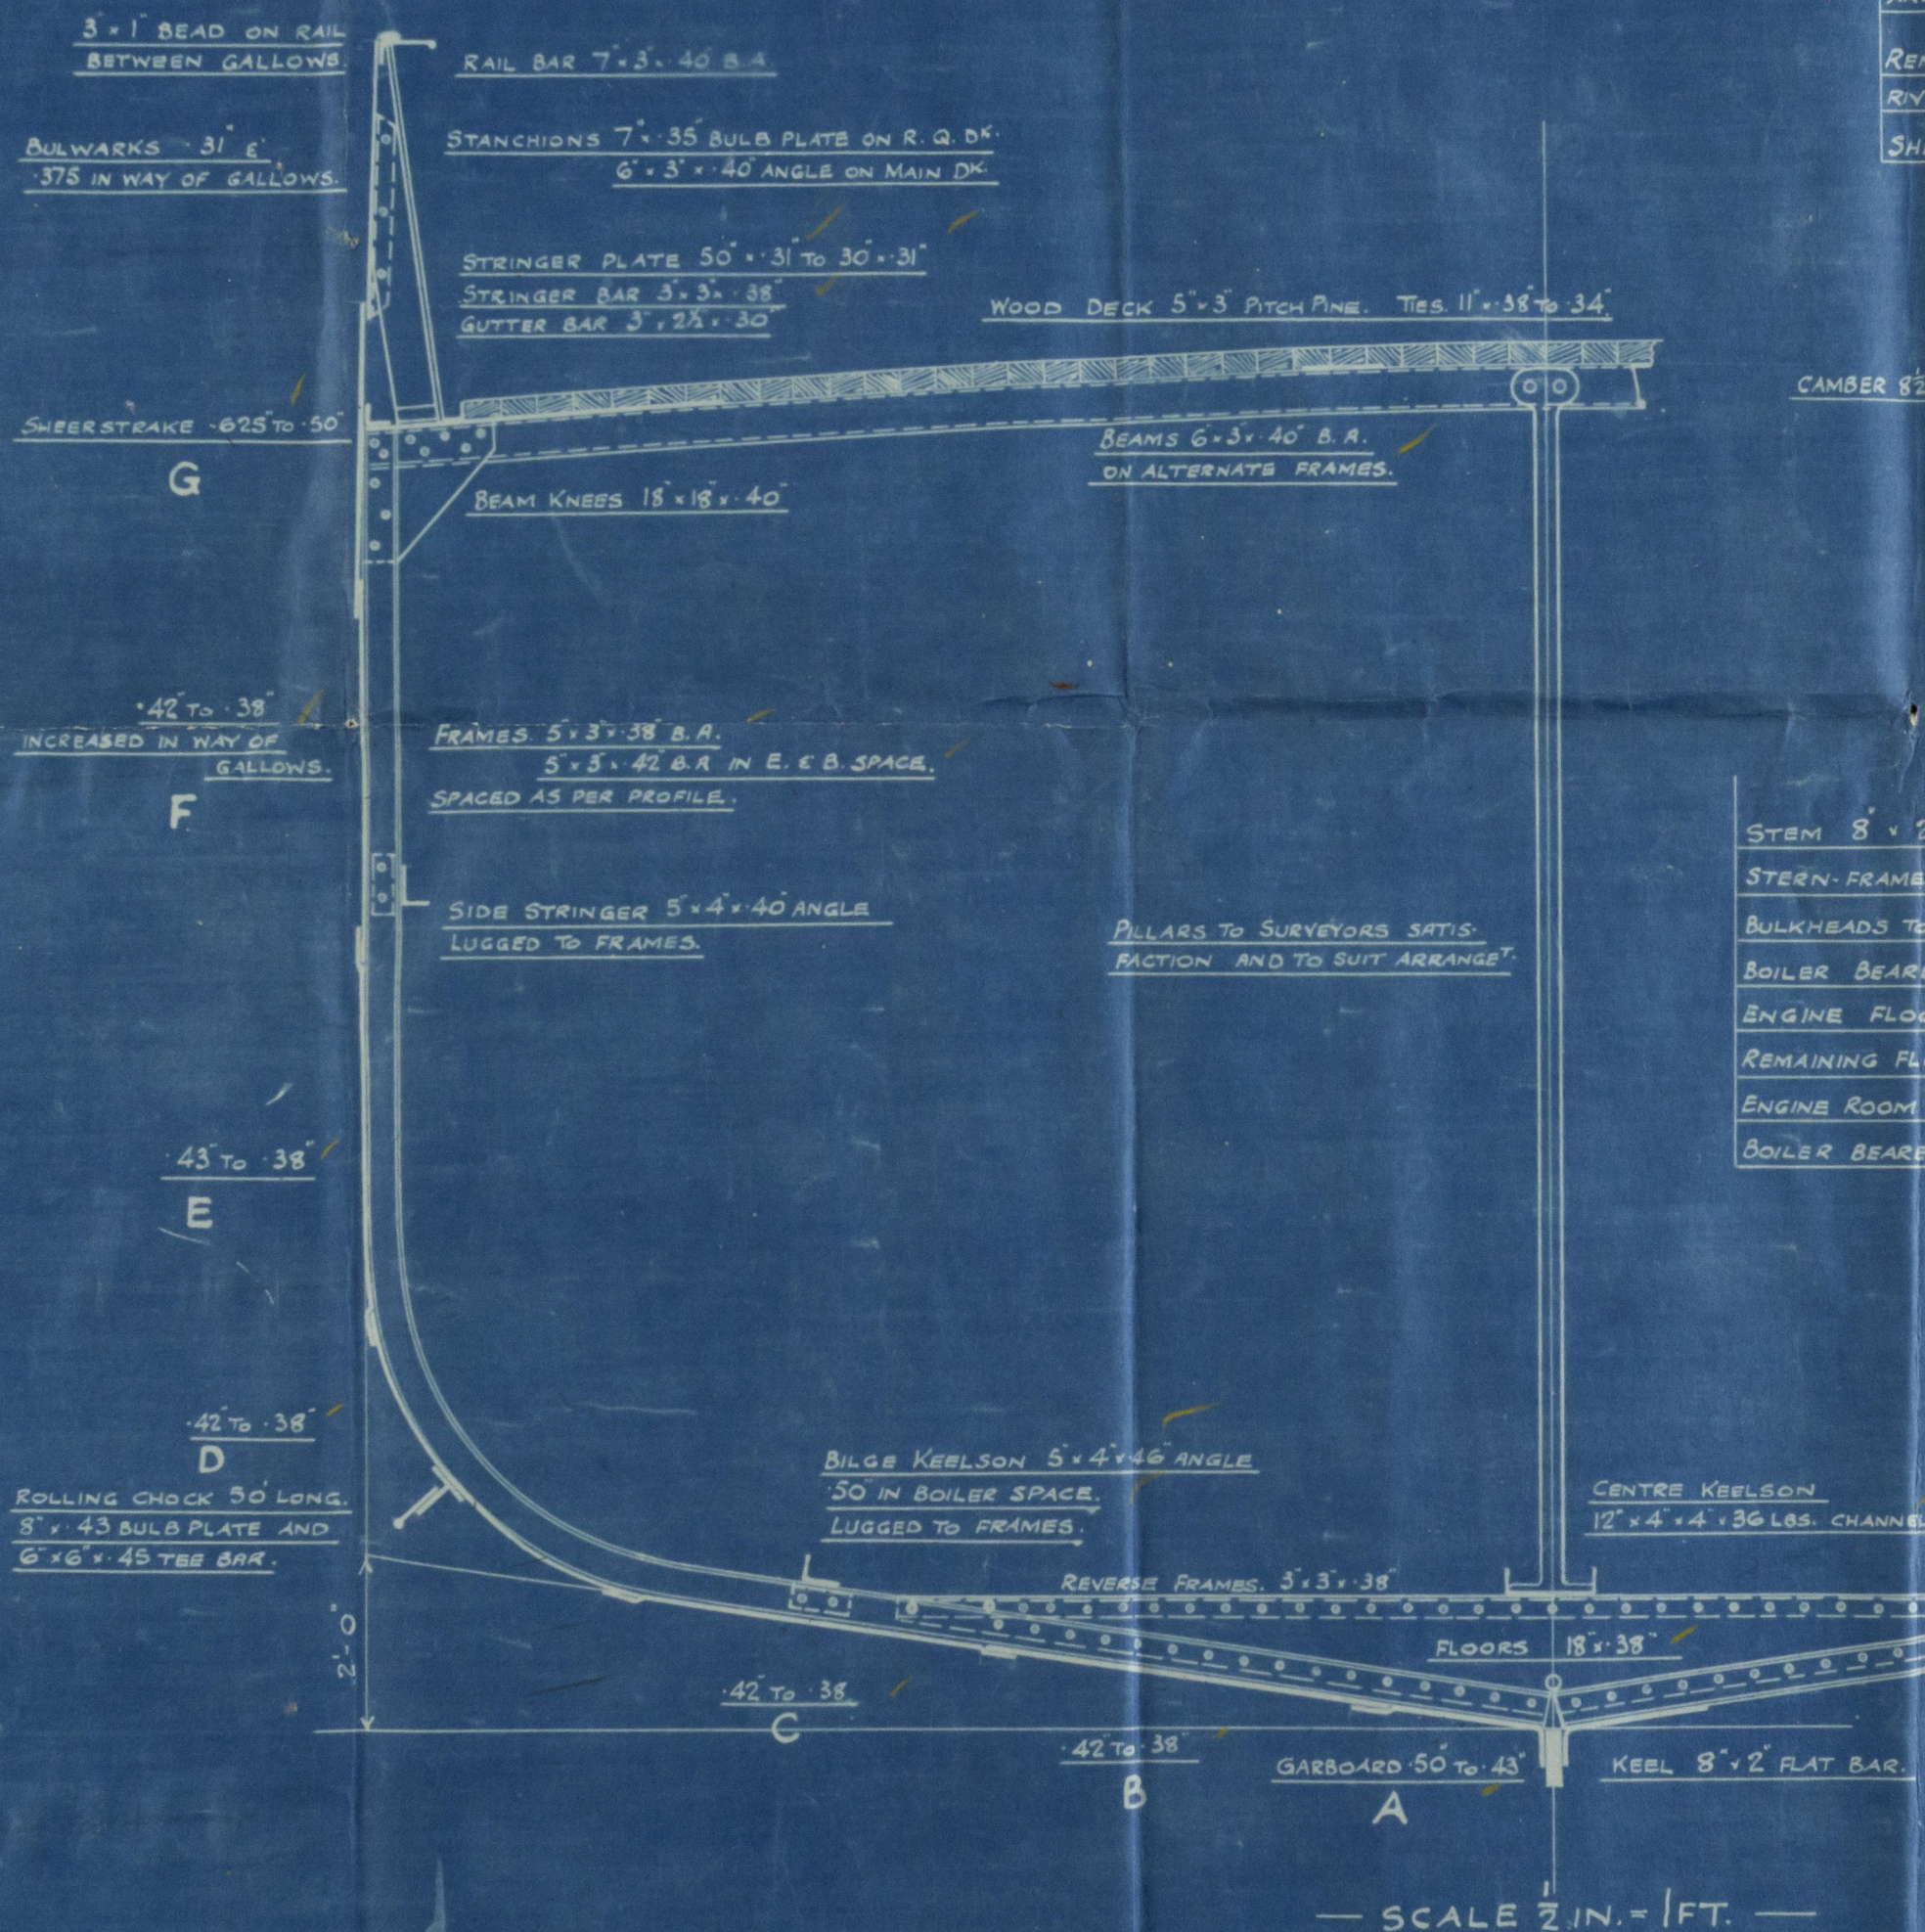

SCALE 1/2 IN. = 1 FT.



Lloyd's Register  
Foundation

002577-002582-0053



No 1177

Midship Section (as built)

Coolmanes Lane Rd.

ARCTIC VIKING X.

U.S. Arctic Pioneer

NO. 1177

47686

~~W. H. D. 373~~



© 2021

Lloyd's Register  
Foundation

002577-002582-0053



PLAN No. 204  
FOR ENCLOSURE TO  
*Lloyds Register of*  
*Shipping* Hull FROM  
COCHRANE & SONS, LTD.  
SHIPBUILDERS, SELBY.  
DATE *10/3/37*

002577-002582-0053



© 2021

Lloyd's Register  
Foundation