

Lloyd's Register of Shipping.


Ship's Name

ELMWORTH

Official No.

148102

Memorandum of alterations reported since ship was surveyed for assignment of Load Lines  
in MARCH 1934.

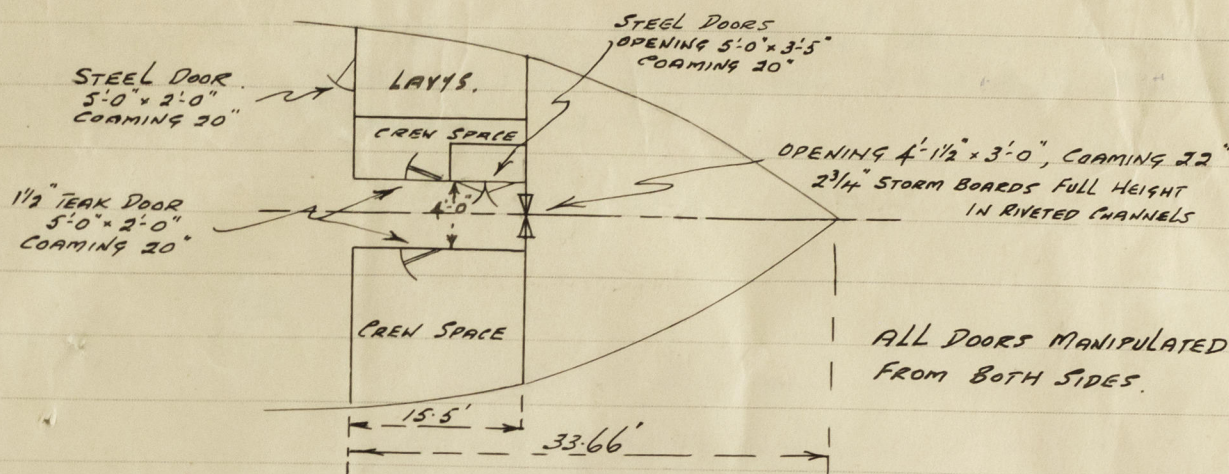

Barry. October, 1942.

The closing appliances for openings in the POOP bulkhead are two hinged steel doors, rubber jointed & framed, each secured by two steel clamps, operated from both sides. Size of openings 28" x 5'-5 1/2", sills 19."

In addition, on inside of these same openings are two hinged teak doors  $1\frac{3}{4}$ " thick operated from both sides.

J. G. Richardson.