

## LLOYD'S REGISTER OF SHIPPING

ATHOS II  
ALTERATIONS TO CONDITIONS OF ASSIGNMENT OF LOADLINES

Ship's Name "BARON HERRIES"

Official No. 163849


Port of Registry Ardrossan

This ship has been under survey at Falmouth

on 28th September, 1956 and the following alterations to the conditions of assignment of loadlines have now been effected/found:—

Exposed machinery casings on shelter deck.

Two openings (one each side) 5' 0" x 2' 0" with steel hinged doors, operated from both sides, 18" sill.

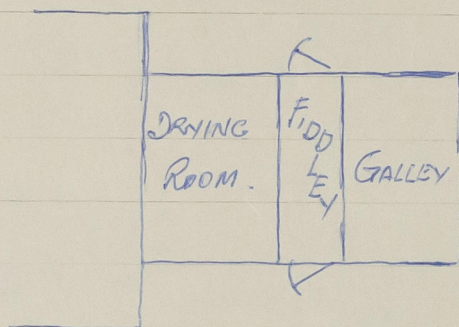

*Handwritten signature*  
Held  
Pwt.  
11.11.60