

TABLE FOR ELECTRIC WELDING.

	FULL WELD SINGLE CONTINUOUS	
	FULL WELD AROUND NOTCHES ETC.	
	BUTT WELDS CONTINUOUS	
	FULL WELD AROUND NOTCHES ETC.	
	FULL WELD AROUND NOTCHES ETC.	
DIMENSIONS	
LENGTH OVER ALL	532'-7 1/2" = 162.35 M.
BETWEEN PP	500'-0" = 152.40 M.
BREADTH MOULDED	64'-0" = 19.50 M.
DEPTH TO MAIN DECK	8'-3" = 2.51 M.
HEIGHT OF POOP	8'-0" = 2.44 M.
HEIGHT OF BRIDGE	11'-8" = 3.59 M.
FORECASTLE	8'-0" = 2.44 M.

CLASS
LLOYD'S REGISTER 100 A.1.
CARRYING PETROLEUM IN BULK.
SPECIAL NOTATION: LONGITUDINAL FRAMING
ELECTRICALLY WELDED.
LLOYD'S LENGTH 500'-0"

THE SCANTLING IS SUITABLE FOR A SUMMER MOULDED DRAUGHT OF ABOUT 29 1/2". THE MINIMUM FREEBOARD WILL, HOWEVER, BE DETERMINED ON COMPLETION OF THE SHIP BY THE REGULATIONS OF THE LOAD LINE CONVENTION.






GOTHENBURG FIRST ENTRY REPORT NO. 19535

By Order of the
Superintendent of the
Göteborgs 9.1.53
M. Larsson

UDDEVALLAVARVET A.B.
No 126
LONGITUDINAL
SECTION AND PLANS


SCALE 1:100
RITADAV
KALK AV
GRAVSKAD AV

126/3

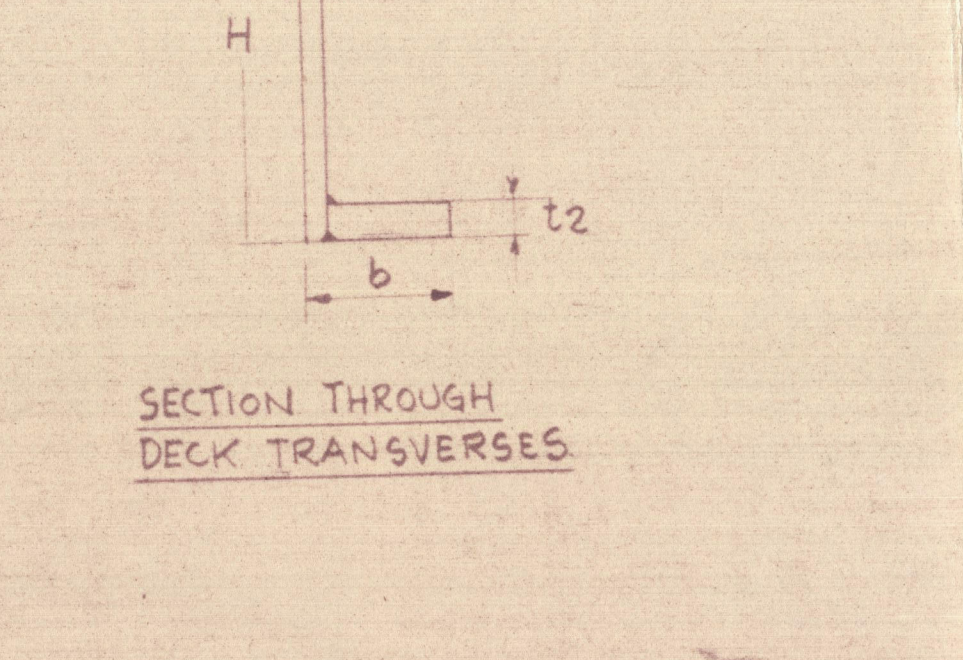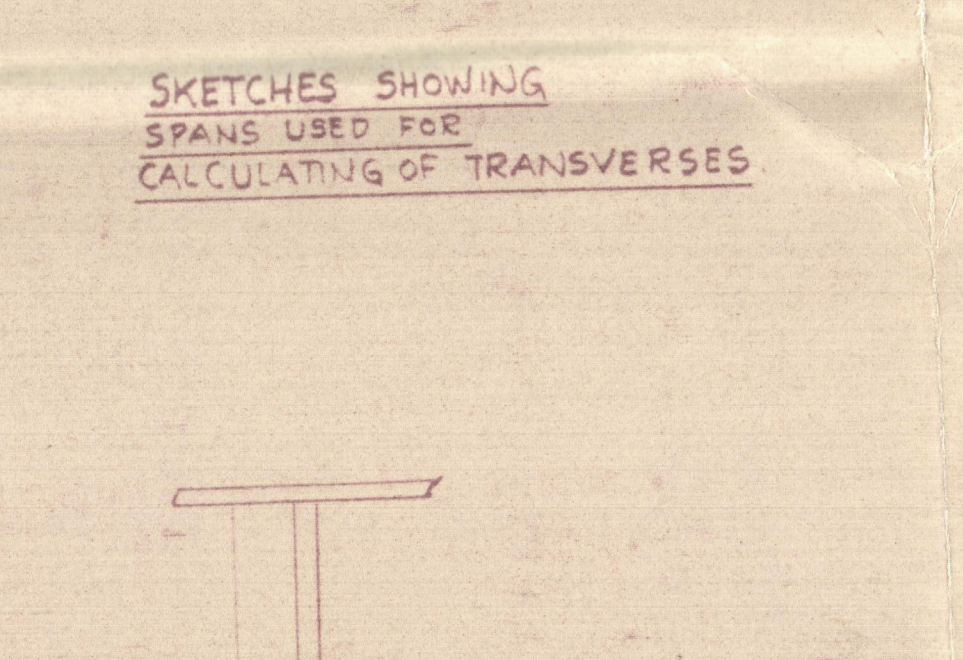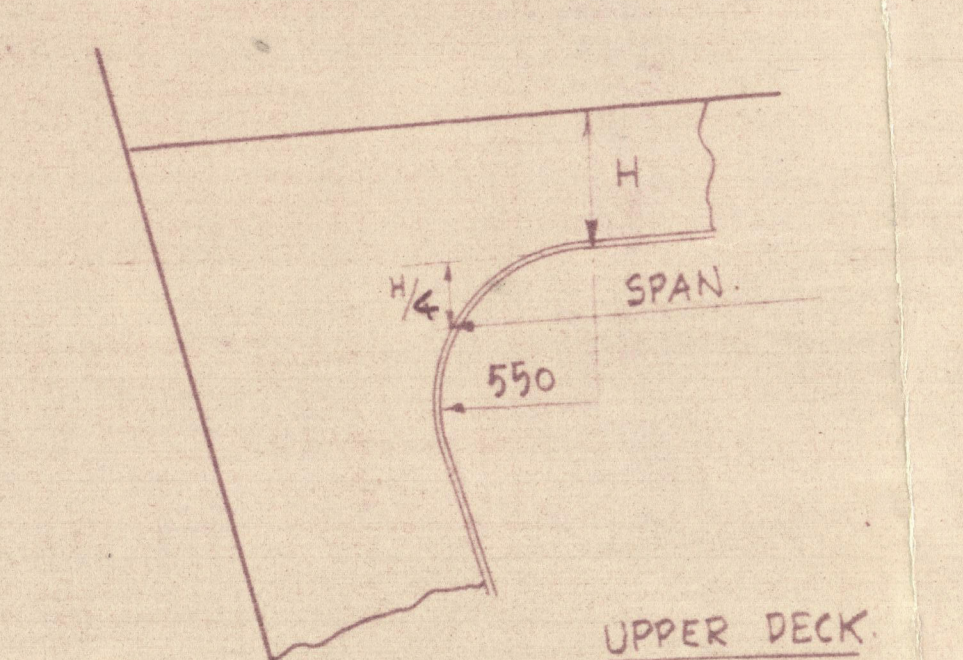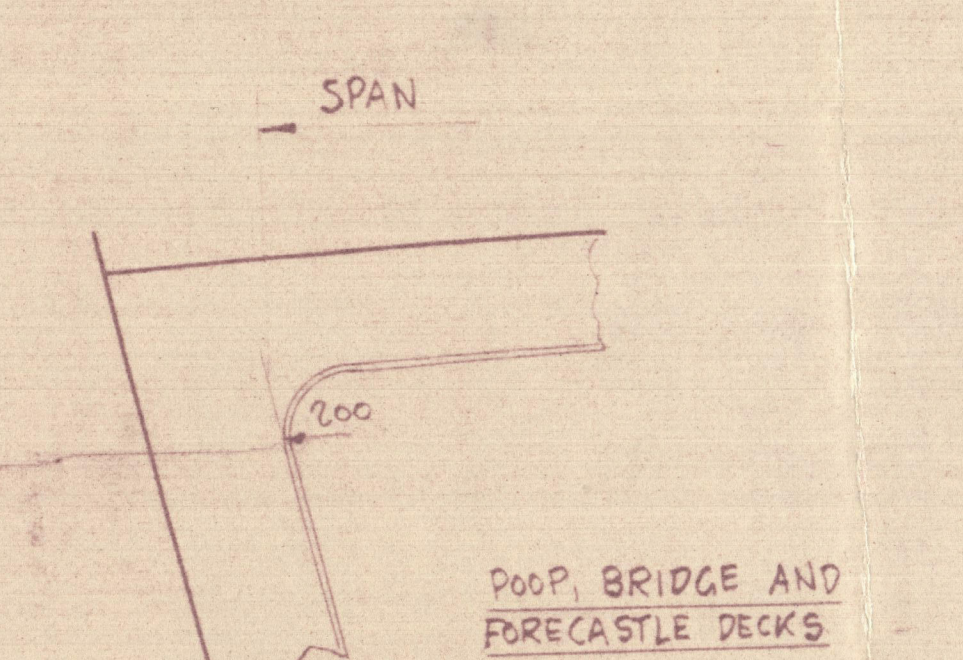 

RECORDS DEPT.
LONDON

Aslaug Form ★
Profile & Becks (as fitted)

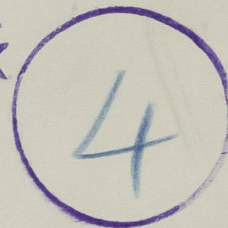

43863



© 2021

Lloyd's Register
Foundation

002602-002610-0001