



NOTE — RUDDER IS CONSTANT IN SECTION

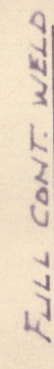


BRITISH CORPORATION

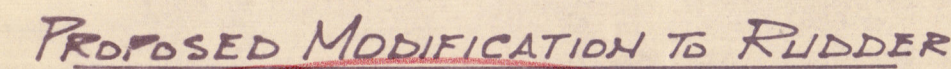

NOTE — PLATING AND STIFFENERS AS SHOWN
ARE TO BE FITTED TO EXISTING RUDDER STOCK & ARMS
(ORIGINALLY A SINGLE PLATE RUDDER.)

INSIDE OF RUDDER TO BE WELL COATED WITH RED LEAD.

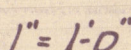

RUDDER.

7/11/46

A.E.

NOTE — INTERMITTENT WELDS WHERE SHOWN
ARE TO BE $\frac{3}{16}$ " x 3" LONG, 12" C'S., ON ALTERNATE SIDES.
FOR 2D.4* PLATES USE STOCK PLATES 9C & 10C.

002602-002610-0046