


YARD No. 57-58.77 PROFILE AND DECK PLANS. SCALE 1:100.

 

DIMENSIONS.

LENGTH BETWEEN RA	480'-0"	146.800 MTR.
BREADTH MOULDED	65'-3"	19.888
DEPTH MOULDED (TO UPPERDECK)	35'-11" (35'4")	10.947 (10.902)
HEIGHT OF POOP	7'-8"	2.337
BRIDGE	7'-6"	2.286
FORECASTLE	7'-6"	2.286

NUMERALS.

FIRST LONGITUDINAL NUMBER L-D = 480-35.0 = 16800
 SECOND " " L-(B+D) = 480-(65.3+35.4) = 48120
 PROPORTION $\frac{L}{D} = \frac{480}{35.4} = 13.56$
 EXACTED ORBT 98 FIDELINE
 LLOYD'S CLASS No. A.I. CARRYING PETROLEUM IN BULK
 LONGITUDINAL FRAMES IN CENTERTANKS, TRANSVERSE FRAMES IN SBTANKS.
 DOUBLE BOTTOM, WINGTANKS AFT AND DEFTANK FORWARD ARRANGED FOR OIL FILL.
 ALL BULBRANGLES ARE BASED ON 1934 STANDARDS.

ms. "LUCELLUM"


- Yard no. 77 -

Mens. Odense Staalskibverft

Midship Section
as built.

Exp. Report No. 10769.

Astoria

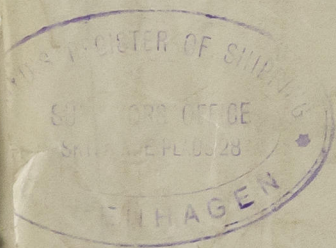

© 2021

Lloyd's Register
Foundation

002602-002610-0087