

YARD Nos. ~~57 & 58~~ 77 PROFILE AND DECK PLANS. SCALE 1:100.

m-s. "LUCELLUM"


~~# ASTURIA #~~

- Yard no. 77 -

Mem. Odense Staalskibs værft.

Profile and decks as
built.

Spec. Report no. 10769.

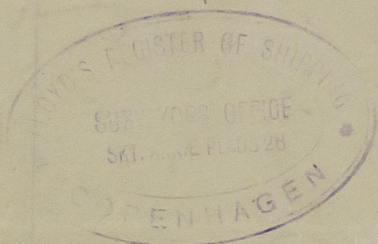

© 2021

Lloyd's Register
Foundation

002602-002610-0088