

ARNESEN,

CHRISTENSEN &amp; CO. A/S,

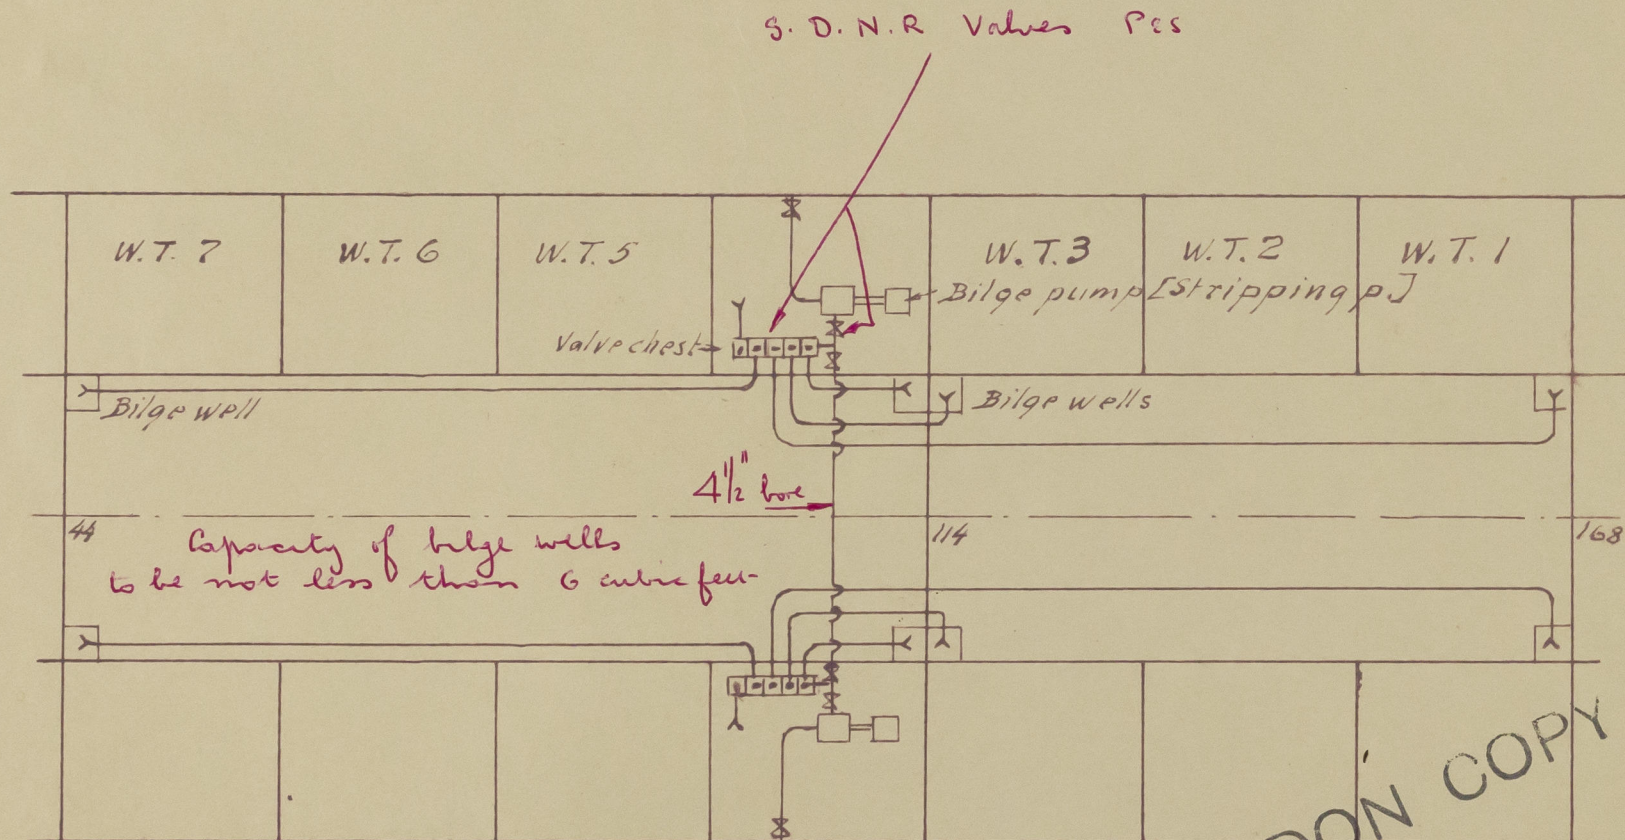
OSLO

TEGN.  
KFR.

SKALA:

Bilge piping arrangement in cargo space

M/S. LUGELUND &amp; M/S. HUMILITAS

DATO:  
17-8-55  
TEGN. NR. 3136/305.

all bilge suctions to be 3" bore.

Provision to be made for sounding holds

The remaining requirements of the Rules for Pumping and Piping to be complied with so far as they are applicable.

13/9/55  
Lloyd's Register Foundation

002602-002610-0131