


S. S. CARCO STEAMER. S.S. "RUNNELSTONE"
 190' B.P. x 30'-0" x 14'-6" M.L.D.
 STEEL ARRANGEMENT.

SCALE: 1/4" = 1 FOOT.
 TO CLASS + 100 A.I. LLOYDS.

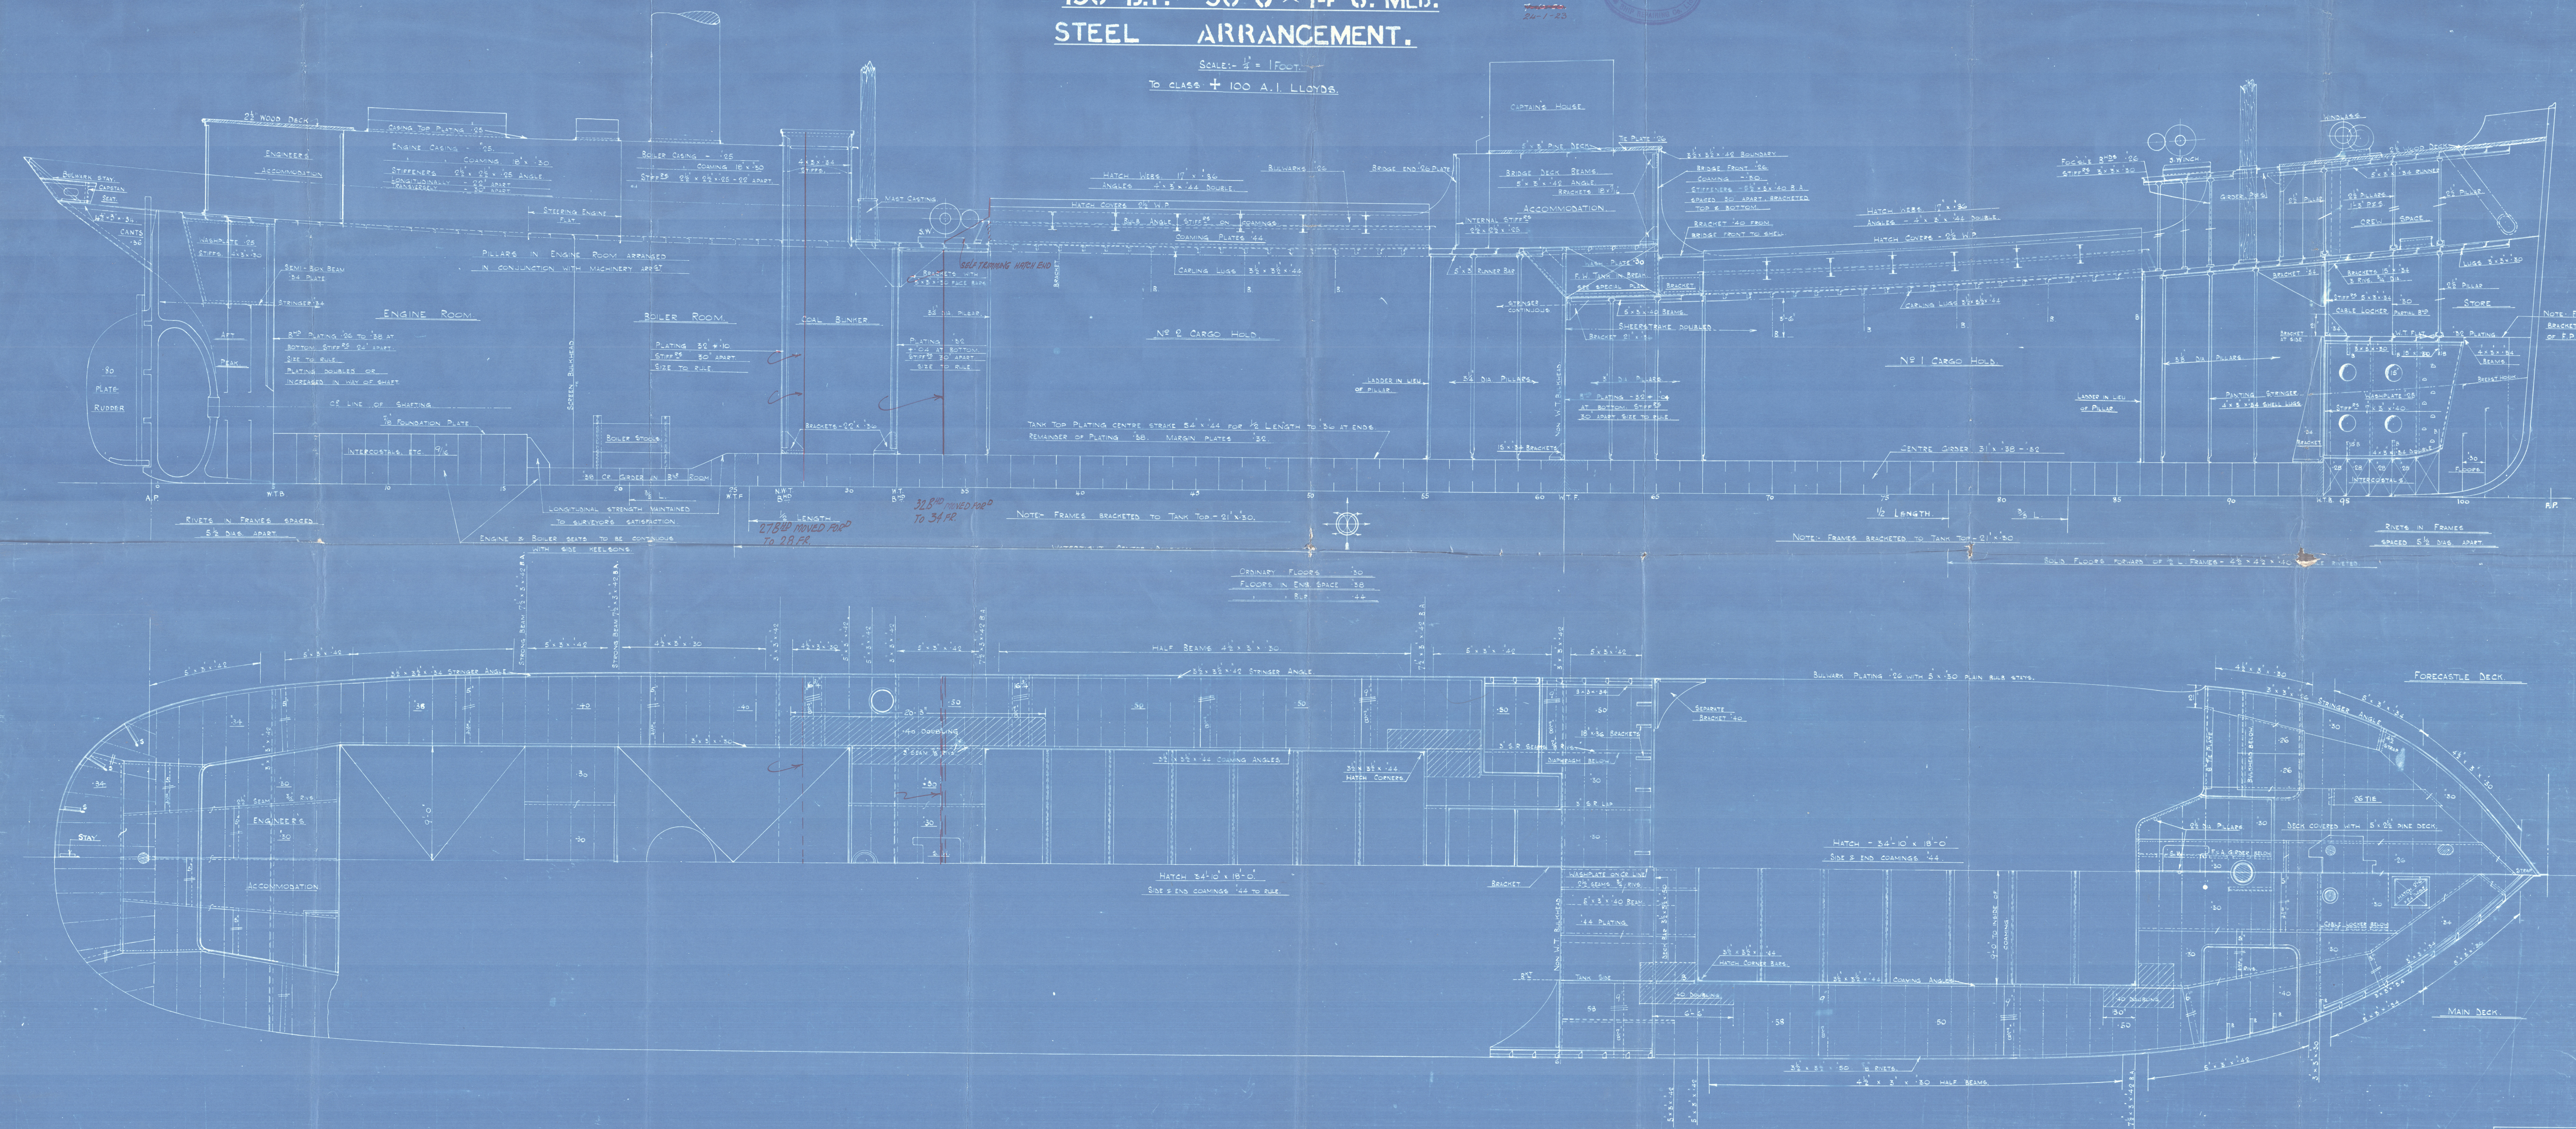

n/n ~ FOAMVILLE

Profile of each

St. "Funnelstone"

appledore 32bs.



© 2021

Lloyd's Register
Foundation

002602-002610-0222