


25.9.11


T. S. S. No 452.
STERN FRAME PLAN.
SCALE 1" = 1 FT

ALFRED STEPHEN & SONS, LTD.
SHIPBUILDERS & ENGINEERS
GLASCOW
PLAN No 7
DATE 25.9.11
SHIPYARD DEPARTMENT

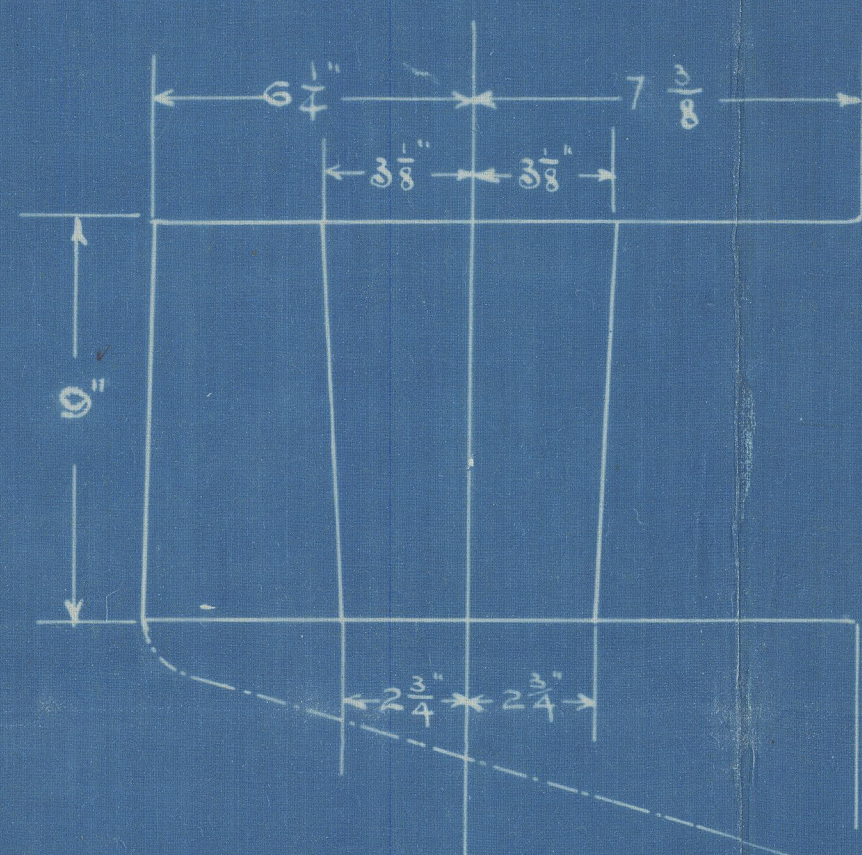

SECTION OF GUDGEONS
FOR LAVSON'S PATENT

Gudgeons to be in accordance with the Rule
diameters of Rudder head.

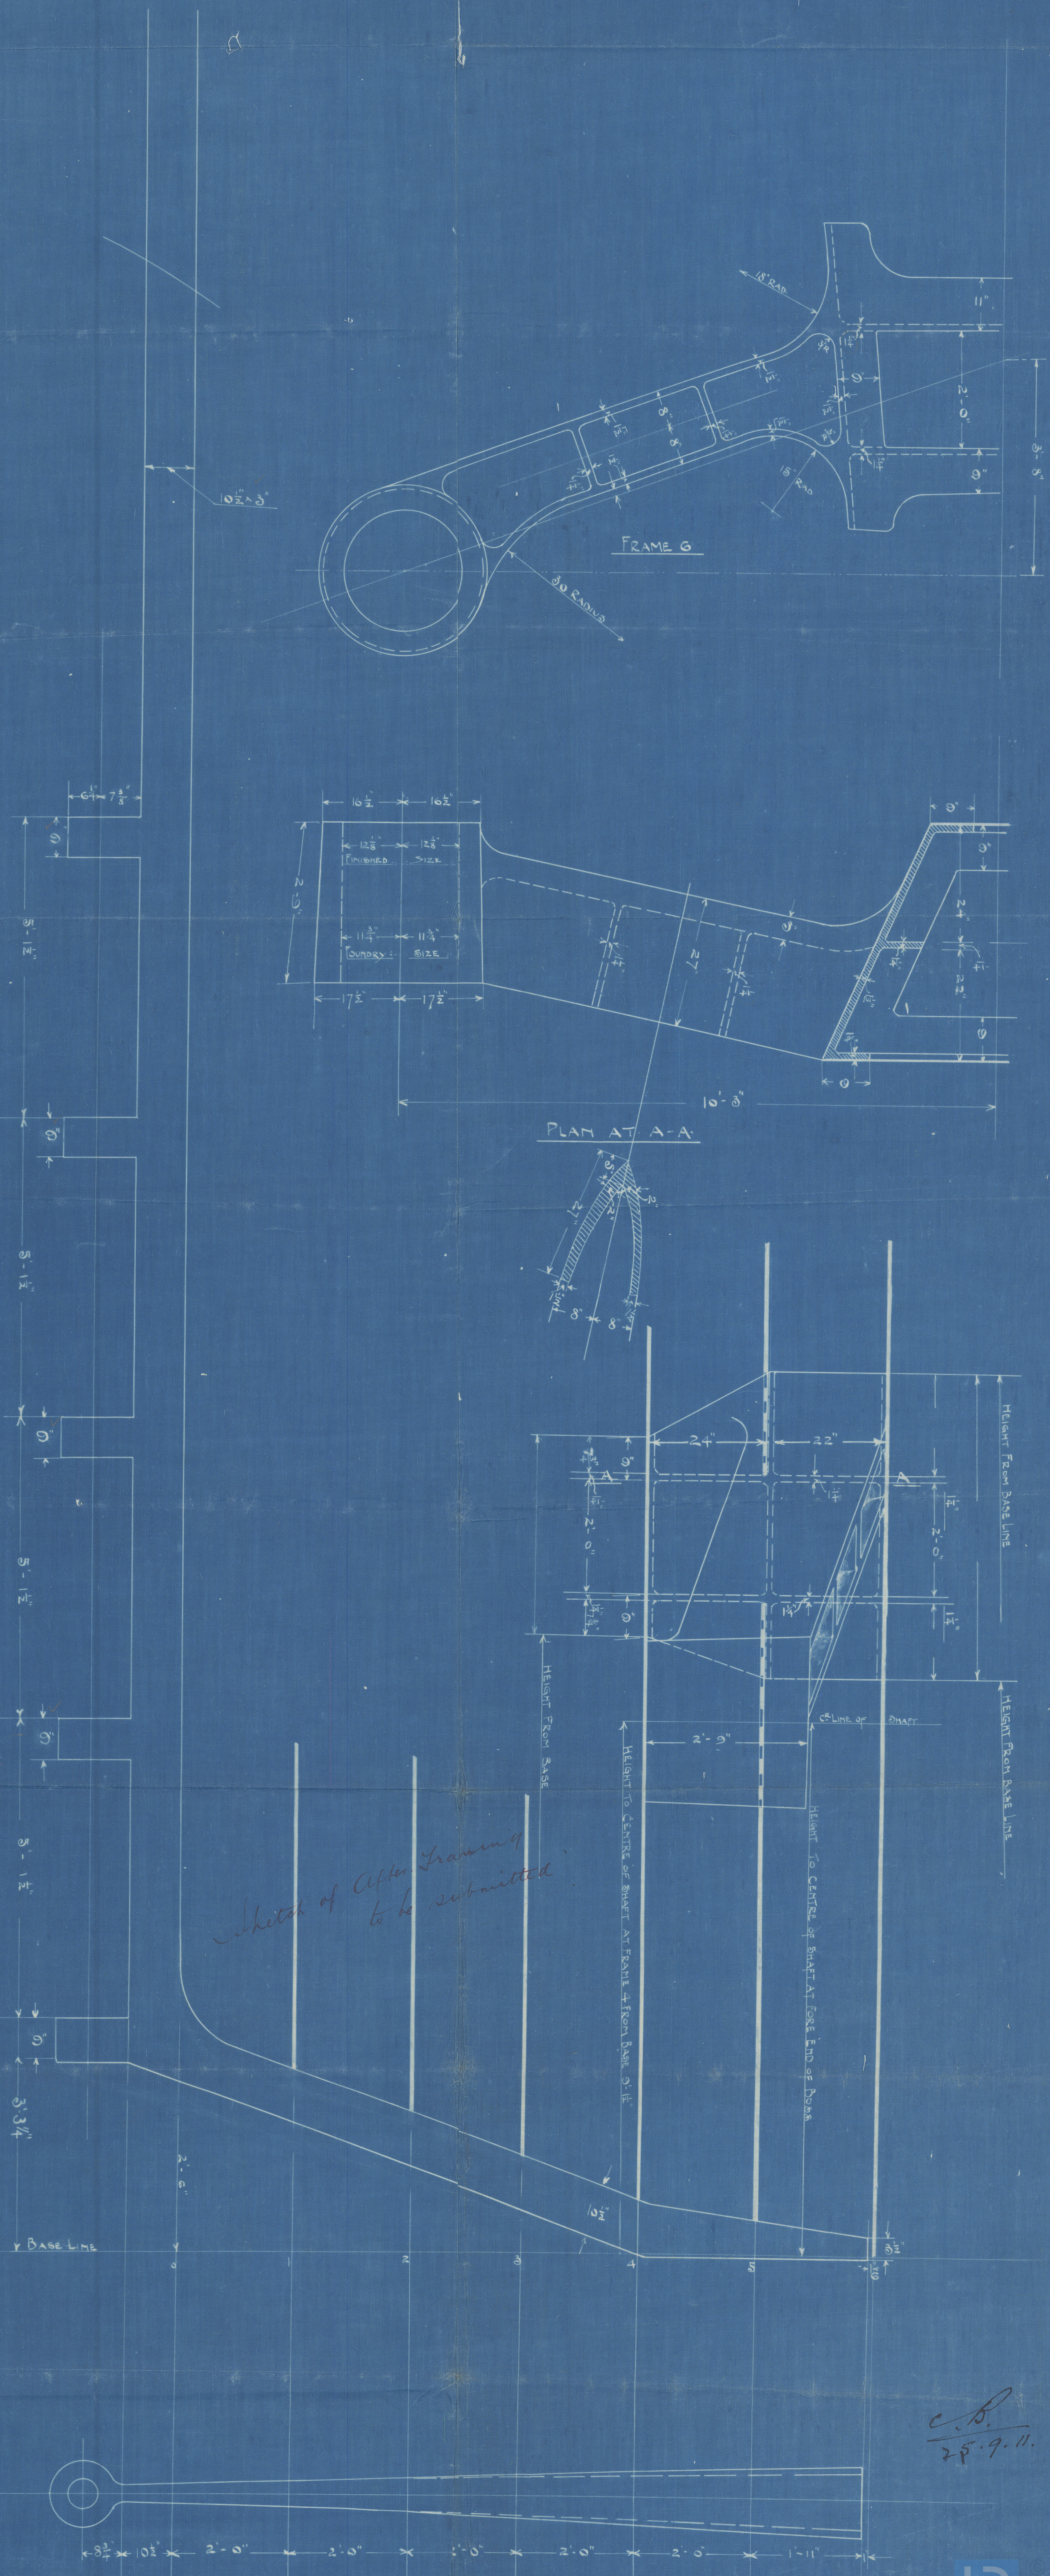

Long 32671

Sketch of After Framing
to be submitted

C.B.
25.9.11.


A Stephen Hows
Stern Frame &
Shaft Brackets

N^o 452 TS/S



s/s "Canberra"

GLASGOW REPORT No. 32433.

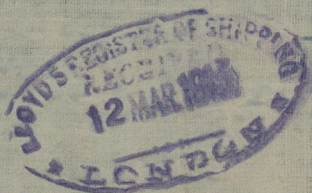

002611-002614-0035

© 2020

Foundation