


9.9.11
2.10.11
26.1.12
29.1.12

T. S. S. No 452
PROFILE & DECK PLANS.
DIMENSIONS- 410'-0" x 57'-0" x 41'-6" TO SHADE DECK.



 


ALIX STEPHEN & SONS
ENGINEERS & ARCHITECTS
GLASGOW
SHIP NO. 112 DEPART 1911

C.F.
9.9.11


C.B.
9.9.11

ESPAÑA

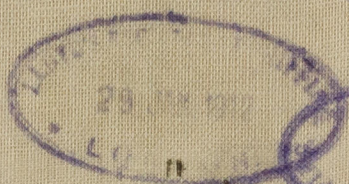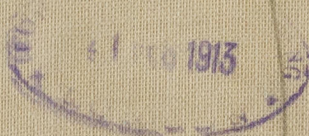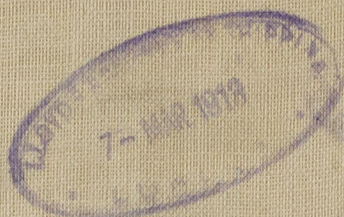

S. S. CANBERRA

Gls 32733.

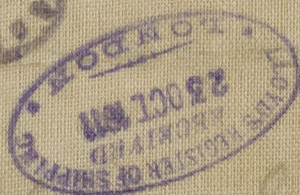

A Stephen Sours

Profile of the Plan



© 2020

Lloyd's Register
Foundation

002611-002619-0037