

14 JAN 1948


Index No.

Lloyd's Register of Shipping.

Ship's Name M.V. "ETREMA"

Official No.

Memorandum of alterations reported since ship was surveyed for assignment of Load Lines in APRIL 1936.

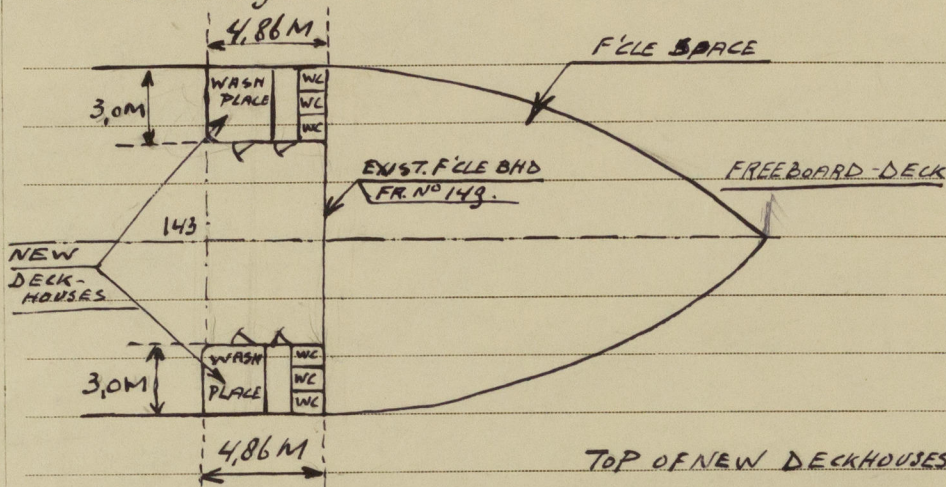

S.B. & P. SIDE, EACH SIDE 2 DISCHARGES, STEEL PIPES ϕ 5" FROM WASHPLACES AND W.C.'S, LED TO OVERBOARD THROUGH VESSEL'S SIDES 8'-0" BELOW THE FREEBOARD DECK. A.N.R. VALVE CHESTS OF SUBSTANTIAL CONSTRUCTION FITTED BETWEEN PIPES AND SHELL. THE DECKHOUSES ARE OF STEEL, STRONGLY CONSTRUCTED. A NEW RISING PLATE, FROM BULWARK TO FOLE SIDE PLATING HAS BEEN FITTED ON BOTH SIDES OF SIMILAR CONSTRUCTION AS PREVIOUS ARRANGEMENT.

Amsterdam, 10th of January 1948.

C.H. Meenwin.

Noted
4h
19.1.48

4.86
14.71
19.57

11.85 x 2 13.66