

Nº 868.

MIDSHIP SECTION.

DIMENSIONS 206'-0" P.P. x 33'-6" EXT x 21'-6" ML<sup>2</sup>

TO CLASS 100 A.I. AT LLOYDS.

SCALE  $\frac{1}{2}" = 1 \text{ FOOT.}$


UNDER DECK TONNAGE = 937. APPROX.

EQUIPMENT N° 11867

3 BOWER ANCHORS	STOCKLESS	24 <sup>1</sup> / <sub>2</sub> CENTS EACH.	COLL. W. 73 CENTS.
1 STREAM	"	EX. STOCK	6 <sup>1</sup> / <sub>2</sub> CENTS.
1 KEDGE	"	"	3 <sup>1</sup> / <sub>2</sub> "
210 FATHOMS	1 <sup>3</sup> / <sub>16</sub> " DIAS	STUD CHAIN CABLE	
75 "	3 <sup>1</sup> / <sub>2</sub> "	STEEL WIRE STREAM	
90 "	3 <sup>3</sup> / <sub>4</sub> "	"	TOWLINE.
90 "	2 <sup>1</sup> / <sub>4</sub> "	"	<i>Brown's Patent to Steel wire.</i>
90 "	5"	MANILLA.	HAWSERS & WARPS.

## NUMERALS.

BEAM 33.33  
DEPTH 21.5  
54.83 1<sup>ST</sup> NO  
LENGTH AS PER RULE 206.  
11294 2<sup>ND</sup> NO  
9.5 DEPTH.

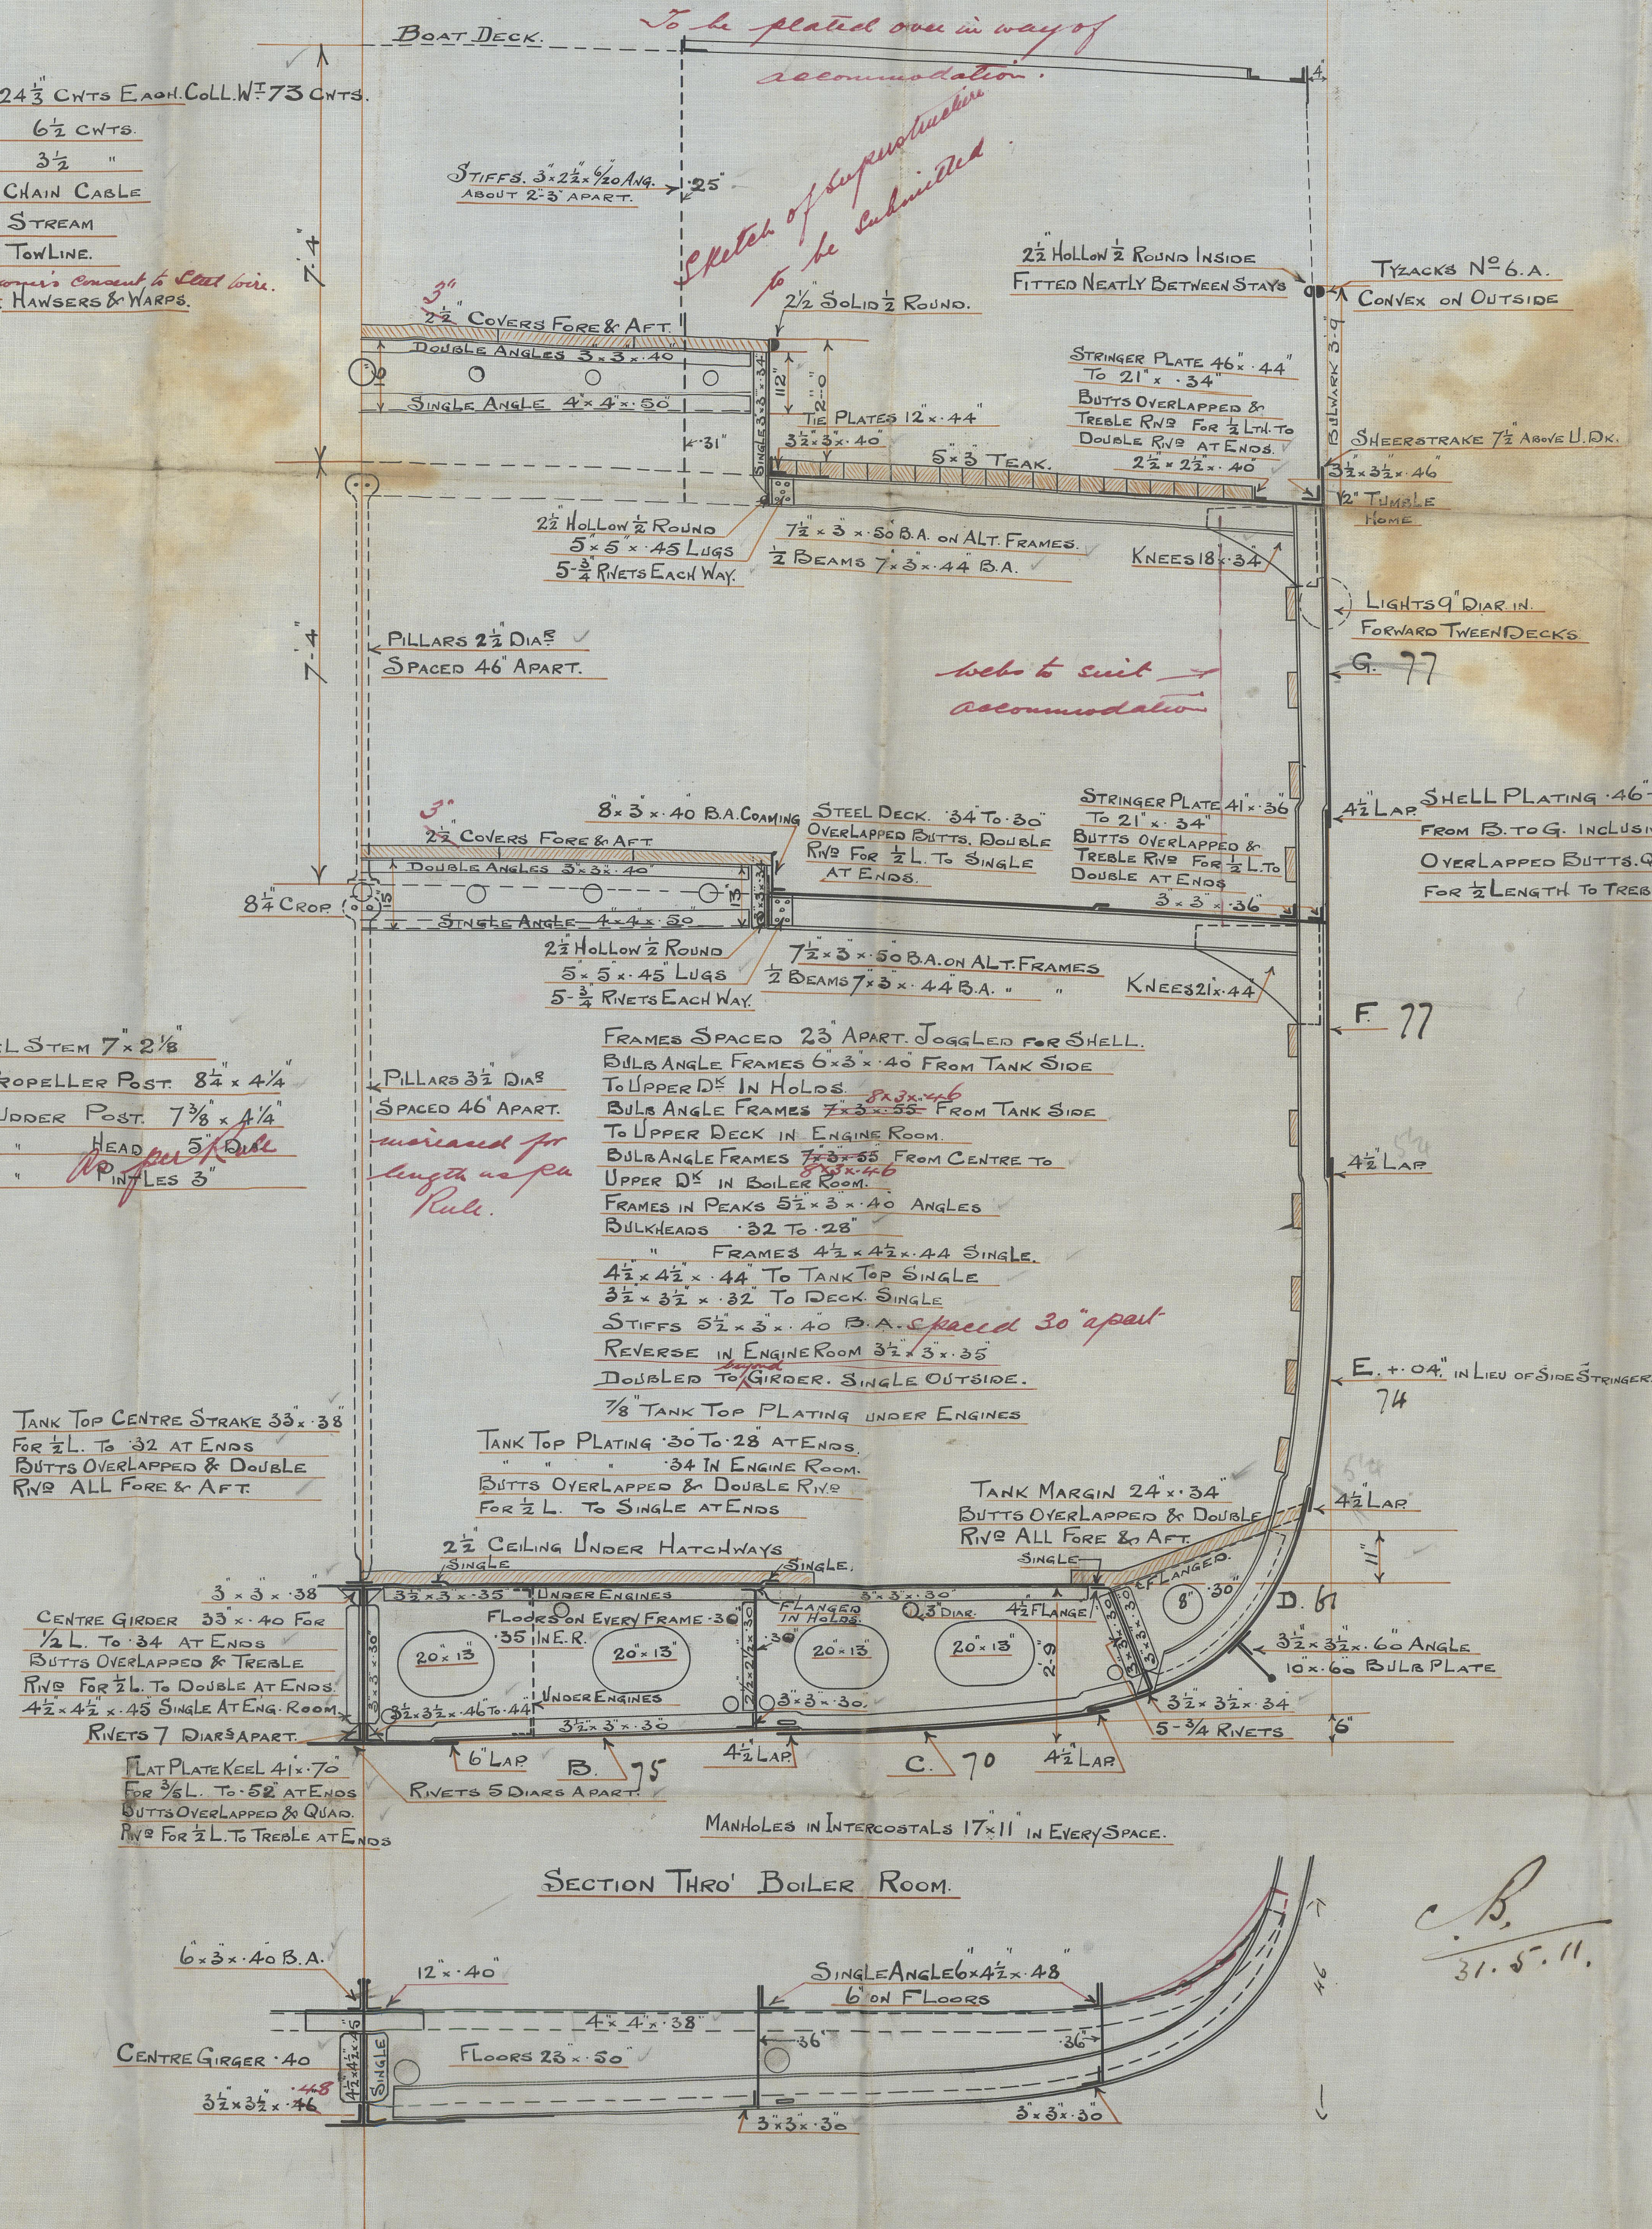

No 5680

SWAN, HUNTER, & WIGHAM RICHARDSON LTD.  
SHIPPING DEPARTMENTS  
25<sup>th</sup> May 1911  
NEPTUNE WORKS  
WALSLEY  
NEWCASTLE-ON-TYNE

C.B.  
31.5.11.



Mess<sup>rs</sup> Swan Hunter &  
Wyham Richardson Ltd

S. S. 868

Midship Section

S.S. 'ACAJOTLA'

NEWCASTLE - ON - TYNE

REPORT NO 61217

Marathon



© 2020

Lloyd's Register  
Foundation

002620-002630-0259