

S.S. SELF UNLOADING COAL BARGE
FOR THE
CANADA STEAMSHIP LINES LTD.
RUDDER & STERN FRAME

SCALE: $\frac{1}{4}$ = 1 FOOT



AREA AHEAD CR OF STOCK = 79.54 FEET
TOTAL AREA OF RUDDER = 98. "

TO BRITISH CORPORATION REQUIREMENTS FOR
SERVICE ON THE CANADIAN LAKES, CANALS &
RIVER ST LAWRENCE

STERN FRAME CAST STEEL
RUDDER FRAME FORGED STEEL
SPEED ABOUT 9 KNOTS
MIN² FOR RULE: 11 KNOTS

2 DEC 1923

Approved *[Signature]*
See Letter 21.12.23

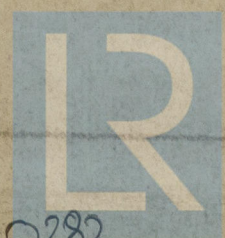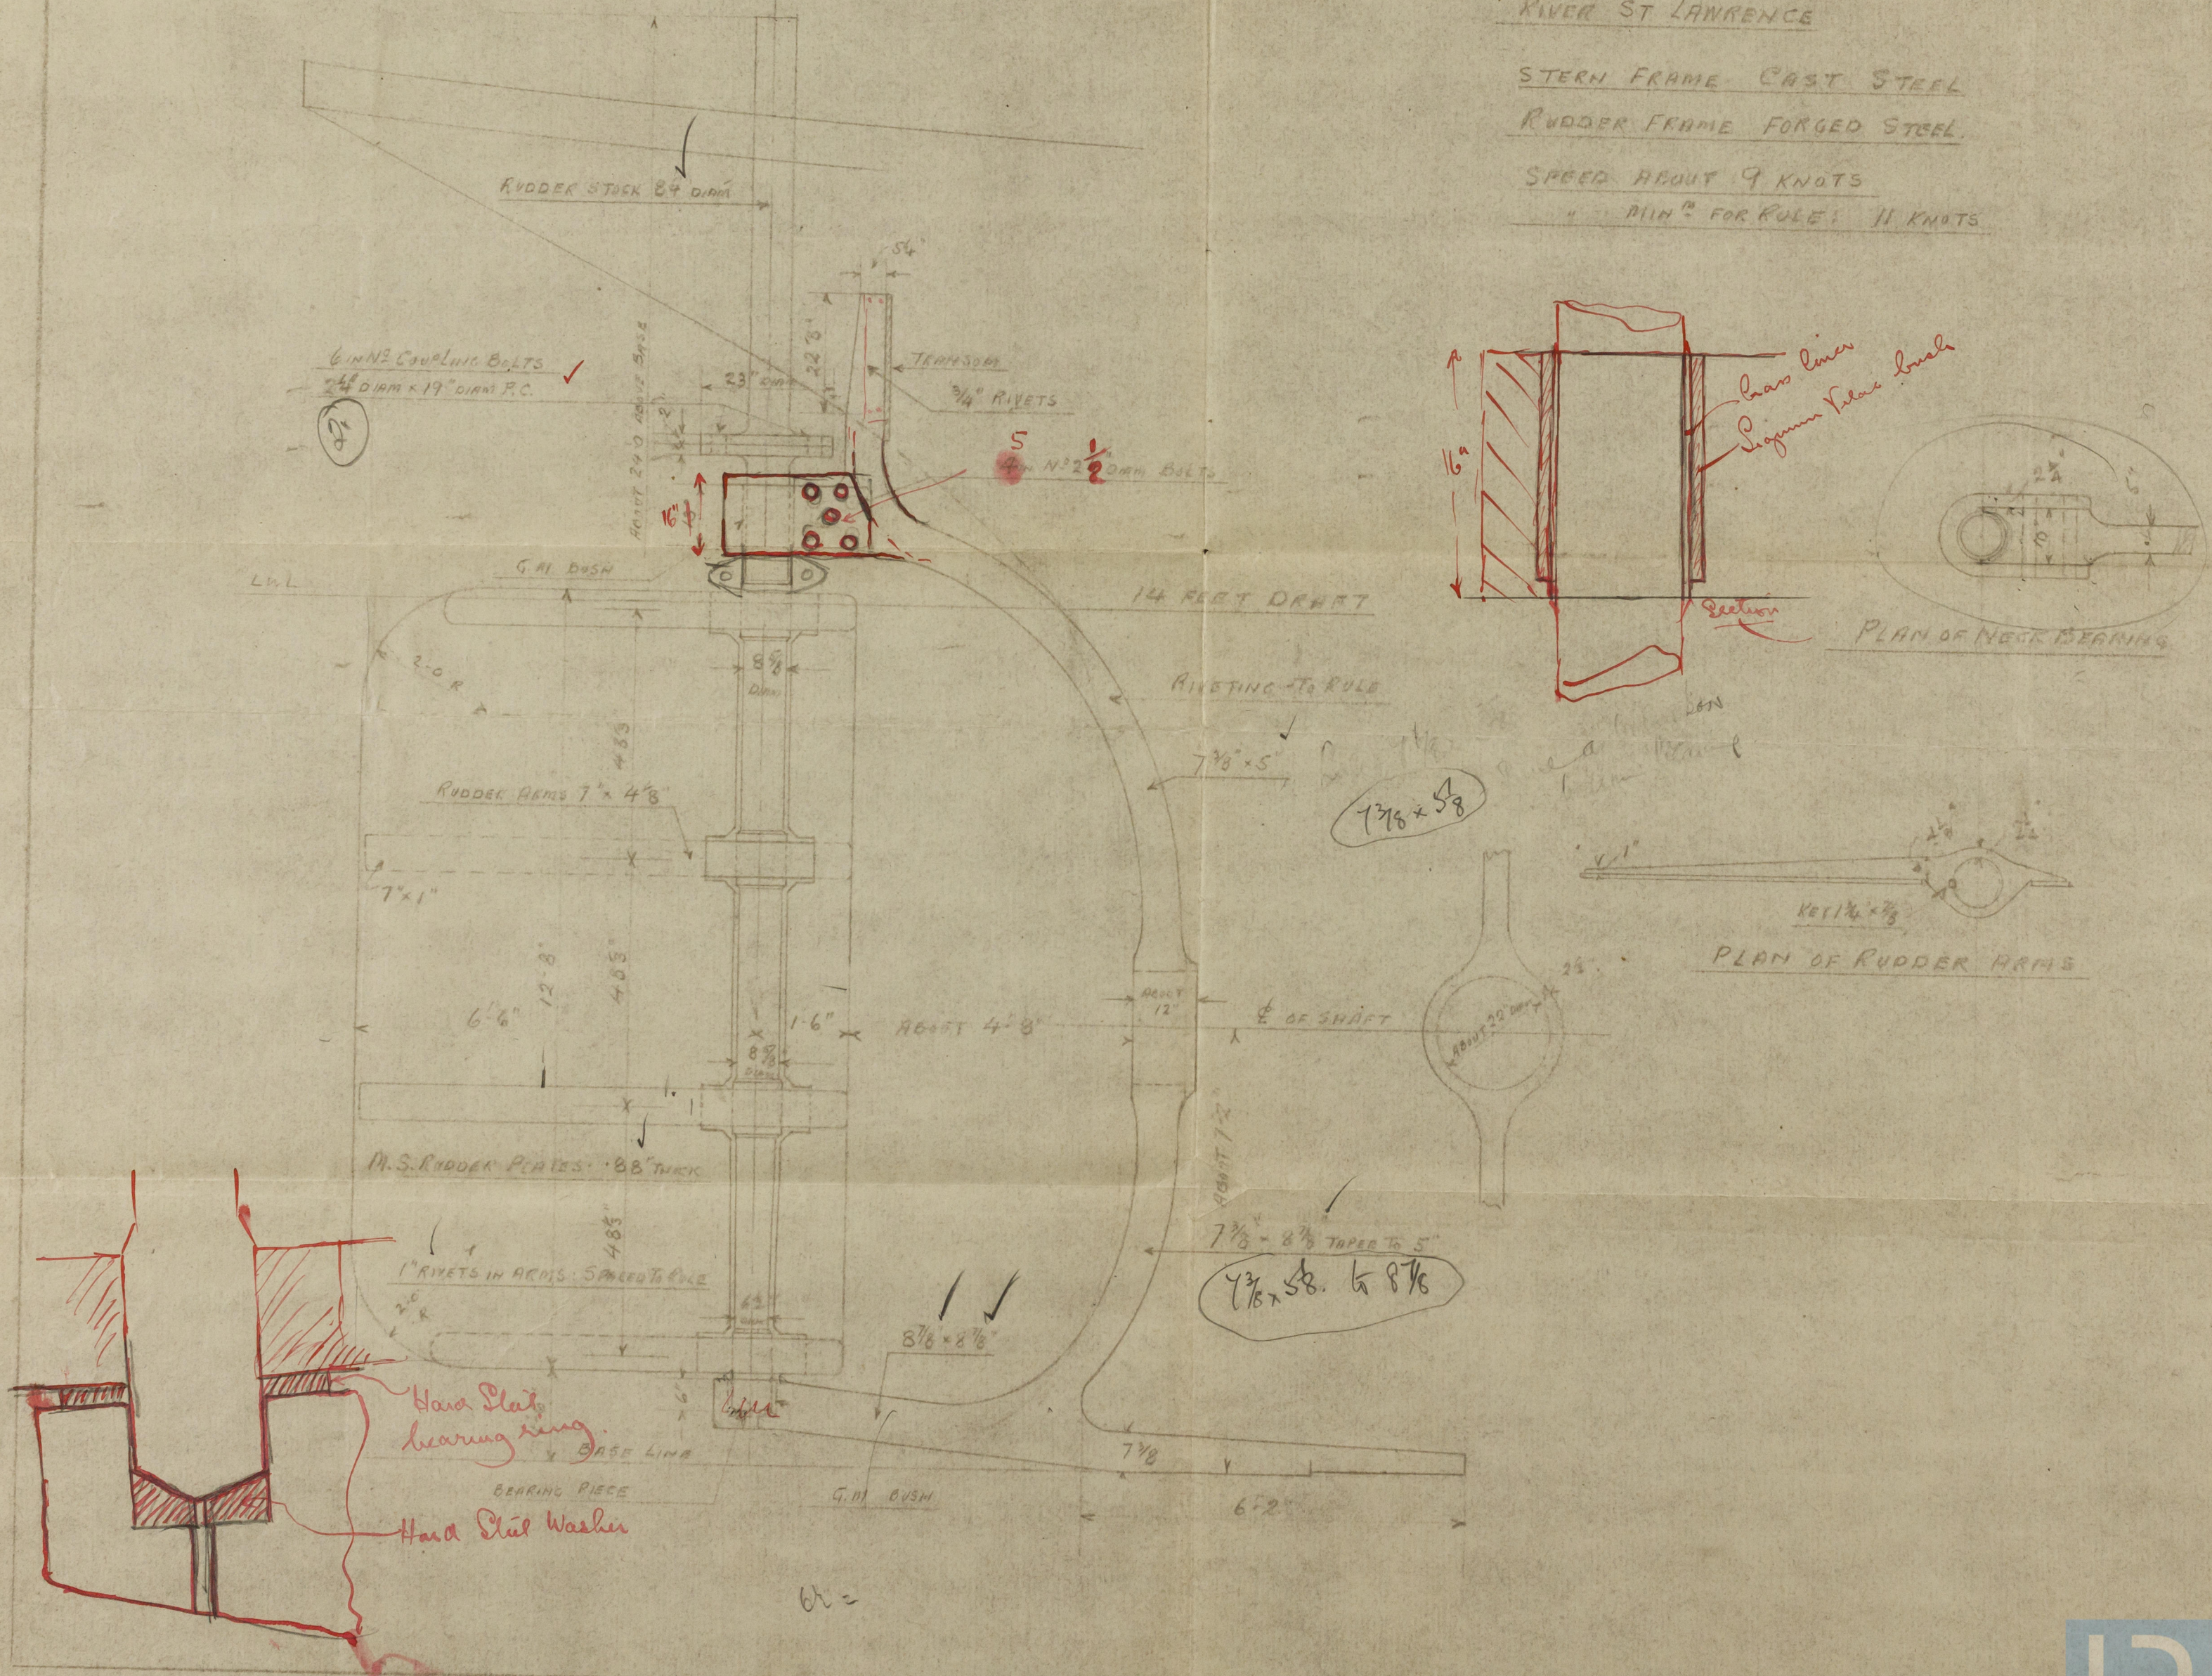

© 2020


Lloyd's Register
Foundation

002639-002646-0282

bas.

610
Vickers N°-610

Rudder + Stern frame

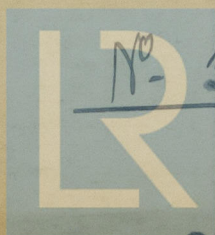

© 2020

Lloyd's Register
Foundation

002639-002646-0282