



S.S. SELF UNLOADING COAL BARGE. COLLIER FOR CANADA STEAMSHIP LINES LTD.

PROFILE & DECK PLANS

Scale 1/8 INCH = ONE FOOT.

To CLASS: BRITISH CORPORATION.

B.S. (~~14-0~~) DRAFT OF 14-0.

FOR SERVICE ON THE GREAT LAKES, CANALS
AND RIVER ST. LAWRENCE

DIMENSIONS:-

LENGTH B.P. = 250-0



BREADTH M² = 43-0

DEPTH M² = 20-0

Load @ Berth X 16 tons oil
Load @ Berth = 36 tons S.
20 tons P.

$$\frac{74 \times 32 \times 2.5}{36} = 16.5$$

Approved *[Signature]*
22.11.22

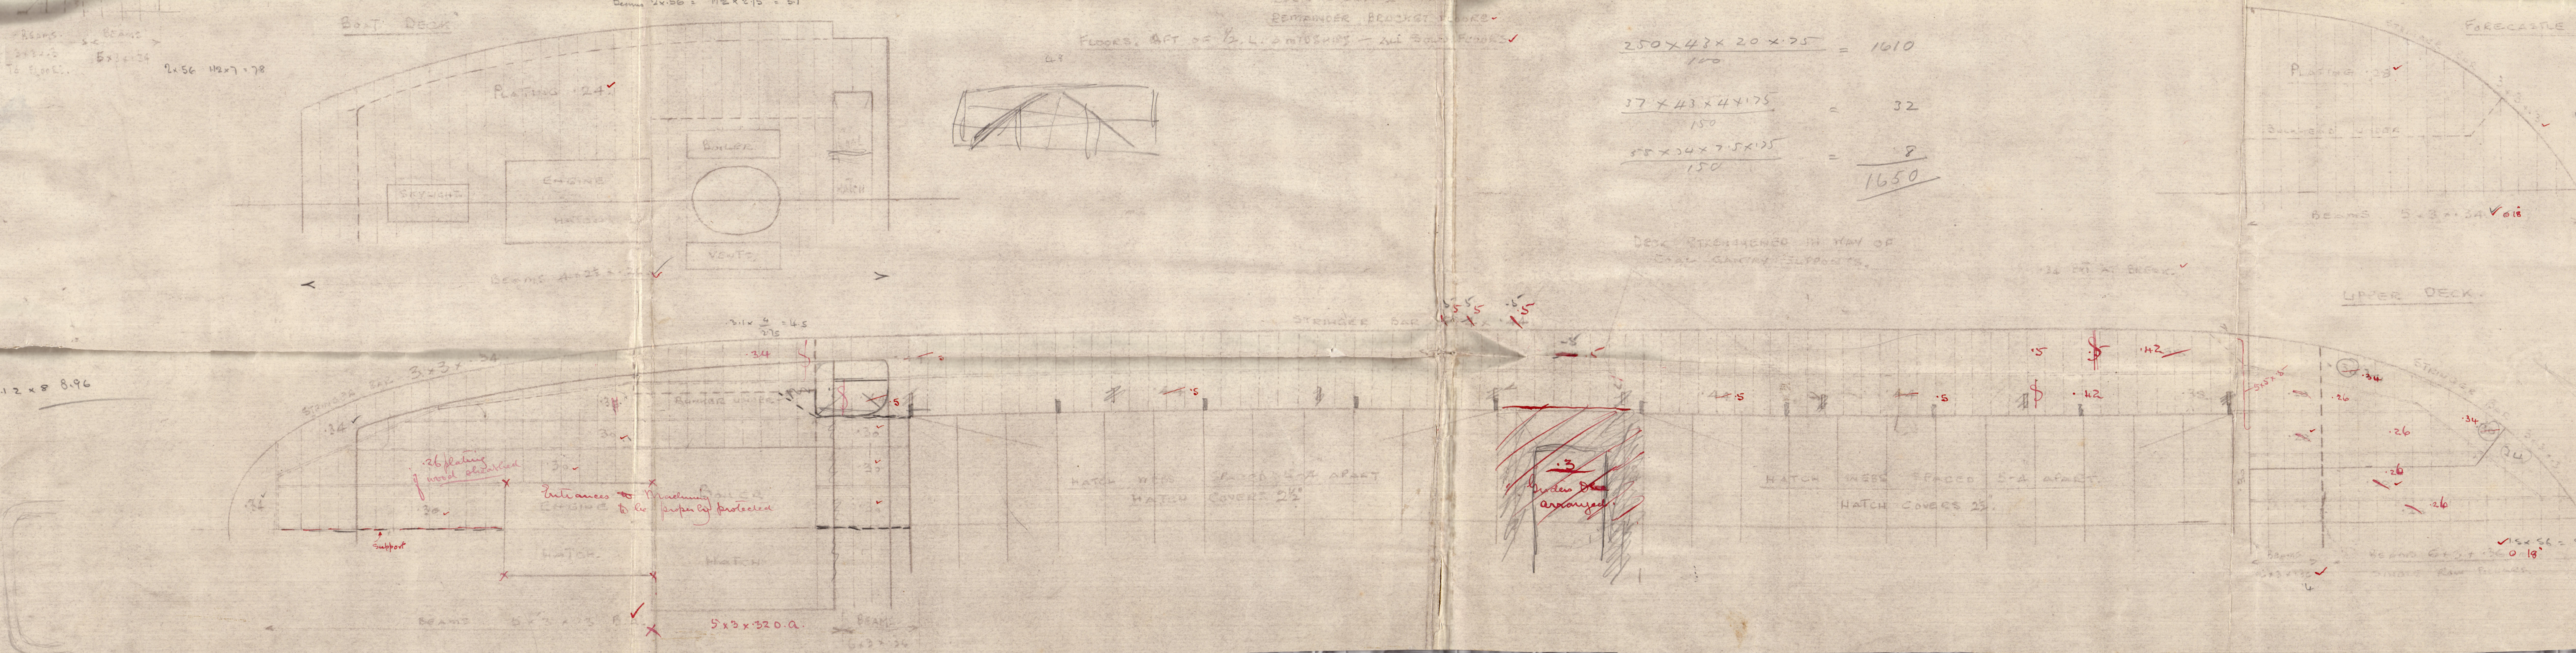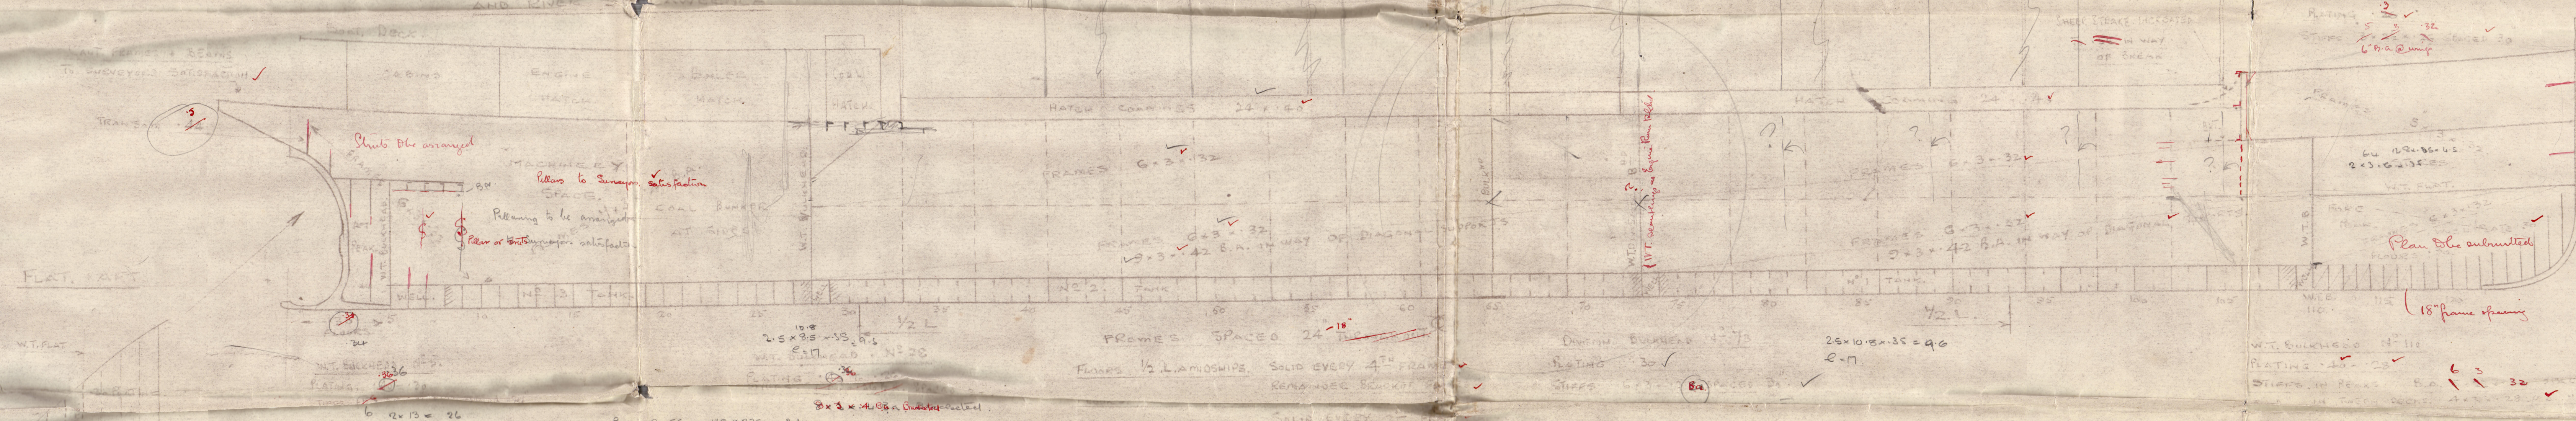

COLLIER

Bag.

T.C. 20/2/24

"Collier"

Vickers N^o 610

250' x 43' x 20'

Profile + Decks.

2. © 2020

002639-002646-0283

Lloyd's Register
Foundation