

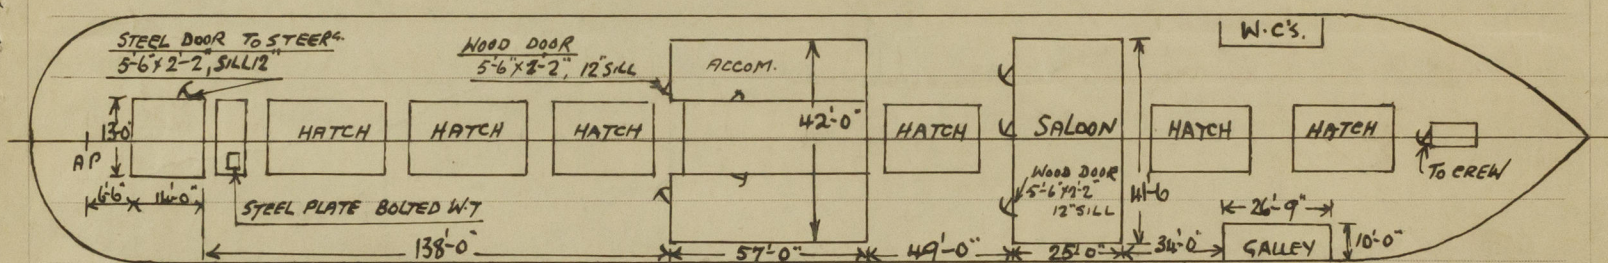
Lloyd's Register of Shipping.

6 SEP 1941

Ship's Name CLYDEBANKOfficial No. 144943

Memorandum of alterations reported since ship was surveyed for assignment of Load Lines
in May, 1941. CALCUTTA.

- (1) Tonnage opening in the shelter deck aft plated over.
- (2) opening to tonnage hatch 5'-6" x 3'-0". closed by bolted steel W.T. plate.
- (3) Freeing ports in tonnage well permanently closed.
- (4) overboard scuppers from shelter tween decks permanently closed by fitting steel plate on ship side. Two scuppers P/S in way of Engine Room led to bulges.
- (5) Sanitary discharge pipe in tonnage well fitted with screw down non return valve controlled from shelter deck.
- (6) Lifelines fitted fore & aft.

Noted *[Signature]*

6/9/41

H. M. Queen