

— FORGED IRON STERN & RUDDER FRAME. —


— S. S. N<sup>o</sup> 168. —

- SCALE  $\frac{1}{2}" = 1 \text{ FT.}$  -


— SPEED UNDER 10 KNOTS. —

NUMERAL: A-D = 155.

— DETAILS SCALE 1" = 1 FT. —

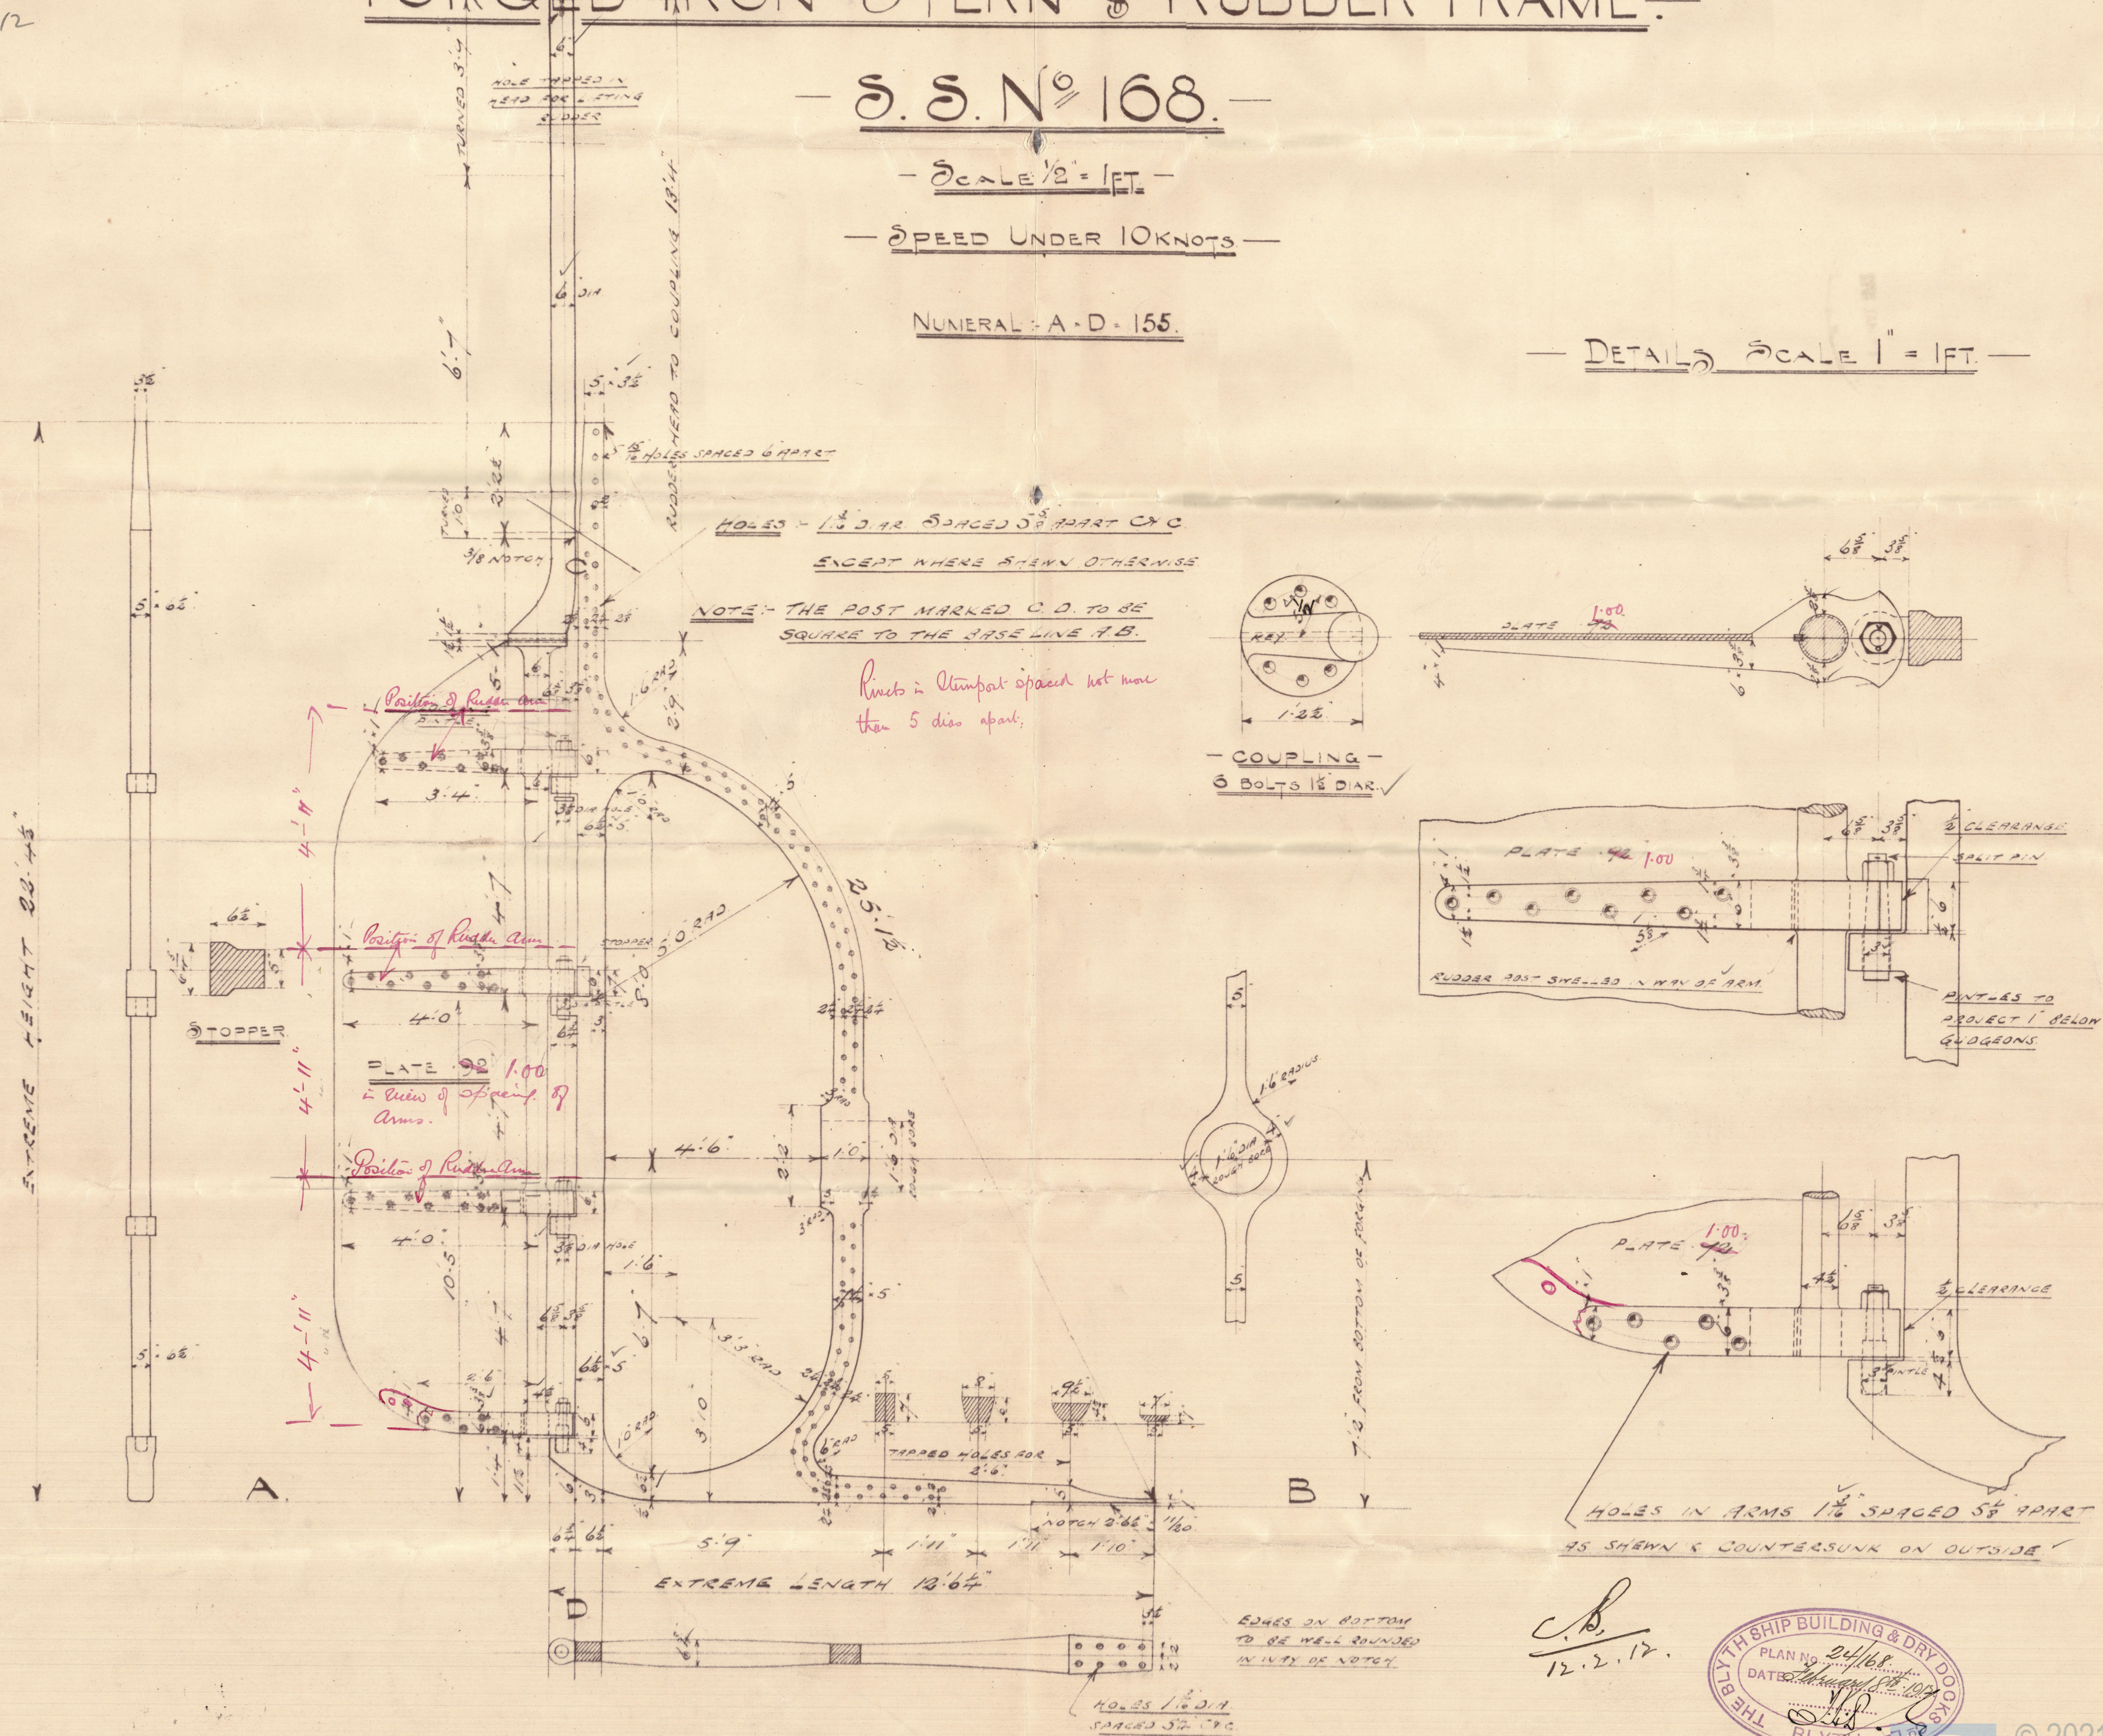

C. D.  
12.2.12

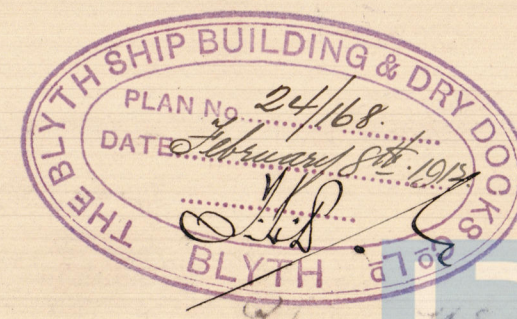

© 2021

Lloyd's Register  
Foundation


002647-002652-0096



BLYTH.

S.S. No 168.

Steer frame & Rudder

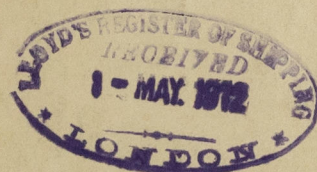

" IRENE. M "

Empire Condensation

~~Discharge 141~~

S/S " THYRA MENIER "

NEWCASTLE-ON-TYNE.

Report No. 63005



© 2021

Lloyd's Register  
Foundation

007647-007652-0096