



Elsmore Nos. 193-4
Alternative Fore End Stiffening
no Shell Connections

19-2-29

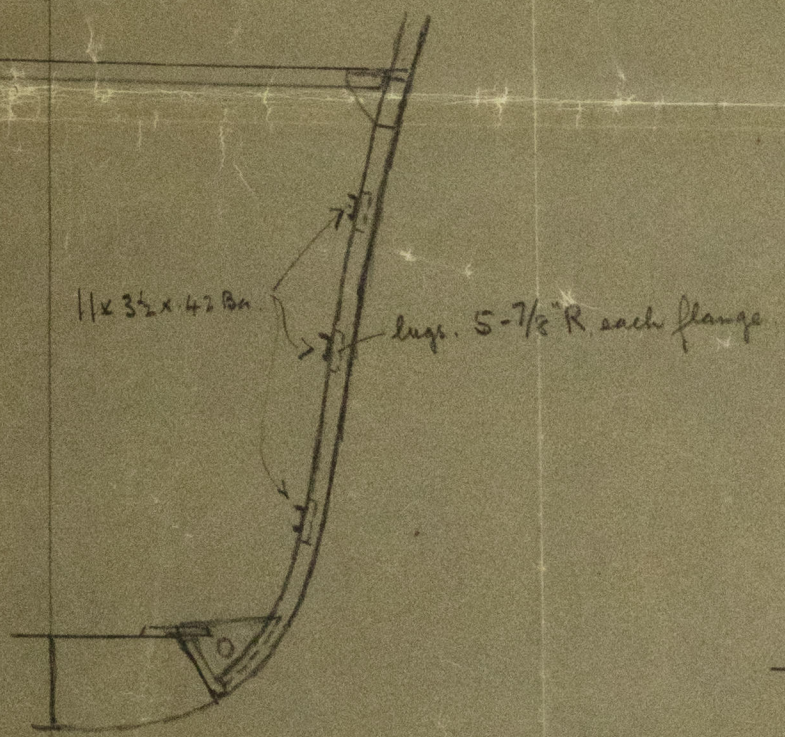


Section in
 No 1 Hold

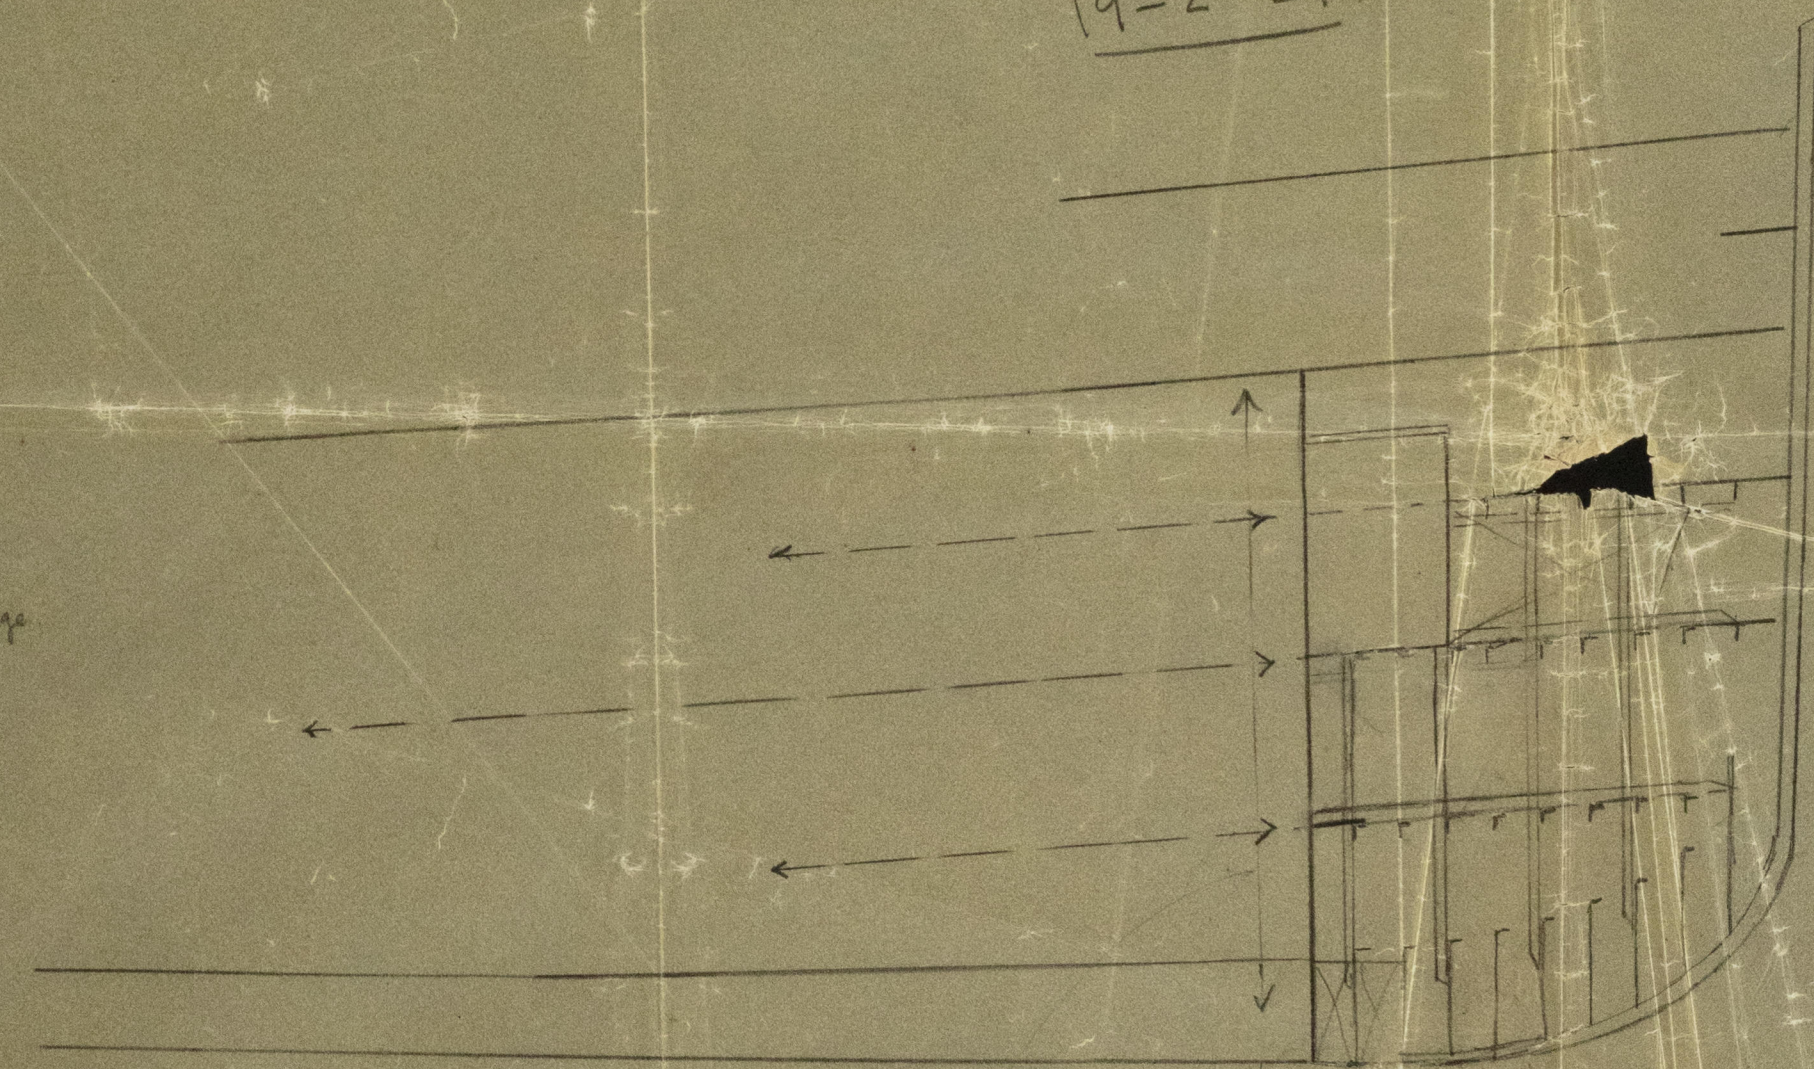


147

6 x 6 x 42 Reverse
 on frame 147

B.A. Stingers
 not attached
 to Collision Bld.

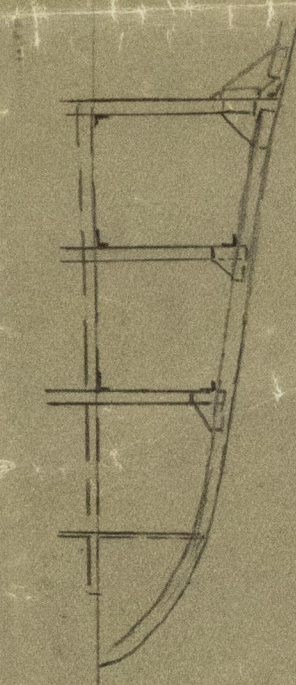

Section Thru
 Peak Tank

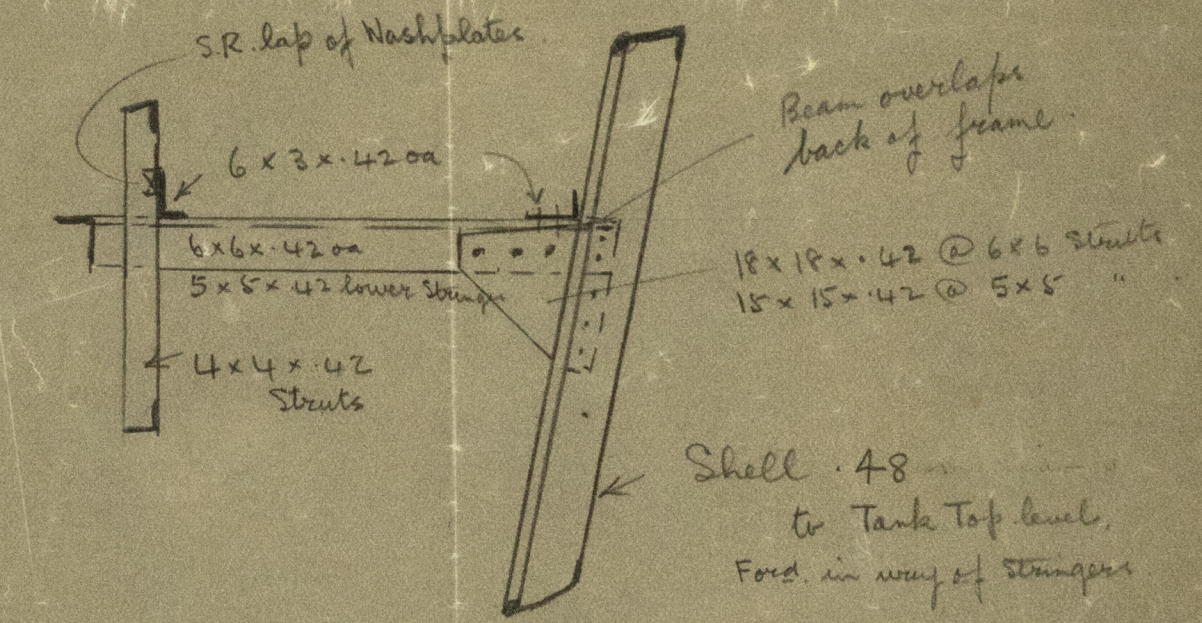

Adopted
 See Prep on Book

002647-002652-0166



© 2021
 Lloyd's Register
 Foundation