

17.2.13

MIDSHIP SECTION

S. S. N° 249

SCALE 1/2" = ONE FOOT

TO CLASS 100A1

DIMENSIONS 180 FT. x 29 FT. x 13 FT. MLD.

BRIDGE DECK

BEAMS	5 1/2" x 3" x 34 ON ALT FRAMES
STRINGER BAR	3" x 3" x 26
" PLATE	31" x 26
TIE PLATES	7" x 26
SIDE PLATING	26
WOOD DECK	5" x 2 1/2"

FORECASTLE DECK

BEAMS	5 1/2" x 3" x 40 ON ALT FRAMES
STRINGER BAR	3 1/2" x 2 1/2" x 26
STRINGER PLATE	16" x 26
PLATED IN WAY OF WINDLASS	
SIDE PLATING	26
WOOD DECK	5" x 3"

SECTION IN WAY OF QUARTER DECK

SECTION IN WAY OF MAIN DECK

NUMERALS

TRANS N° = B + D - 29 + 13 = 42

LONG N° = 180 x 42 = 7560

L MAIN DECK = 13.84


L QUARTER DECK = 10.58

EQUIPMENT N° 8378.59 J

2 BOWER ANCHORS	16 1/2 CWT STOCKLES
1 BOWER	14 1/2
1 STREAM	4 1/2 EX STOCK
1 KEDGE	2 1/2
210 FTMS	1 1/2 STUD CHAIN CABLE
60 FTMS	3 STEEL WIRE
75	8 WIRE OR 2 1/2 STEEL WIRE
90	6 WIRE OR 2 1/2
90	4 WIRE OR 2

SECTION IN WAY OF BOILER SPACE

FRAMES	5 1/2" x 3" x 86 B. ANGLE SPACED 22" APART
REV. FRAMES	3" x 3" x 82 DOUBLE
FLOORS	16 1/2" x 42

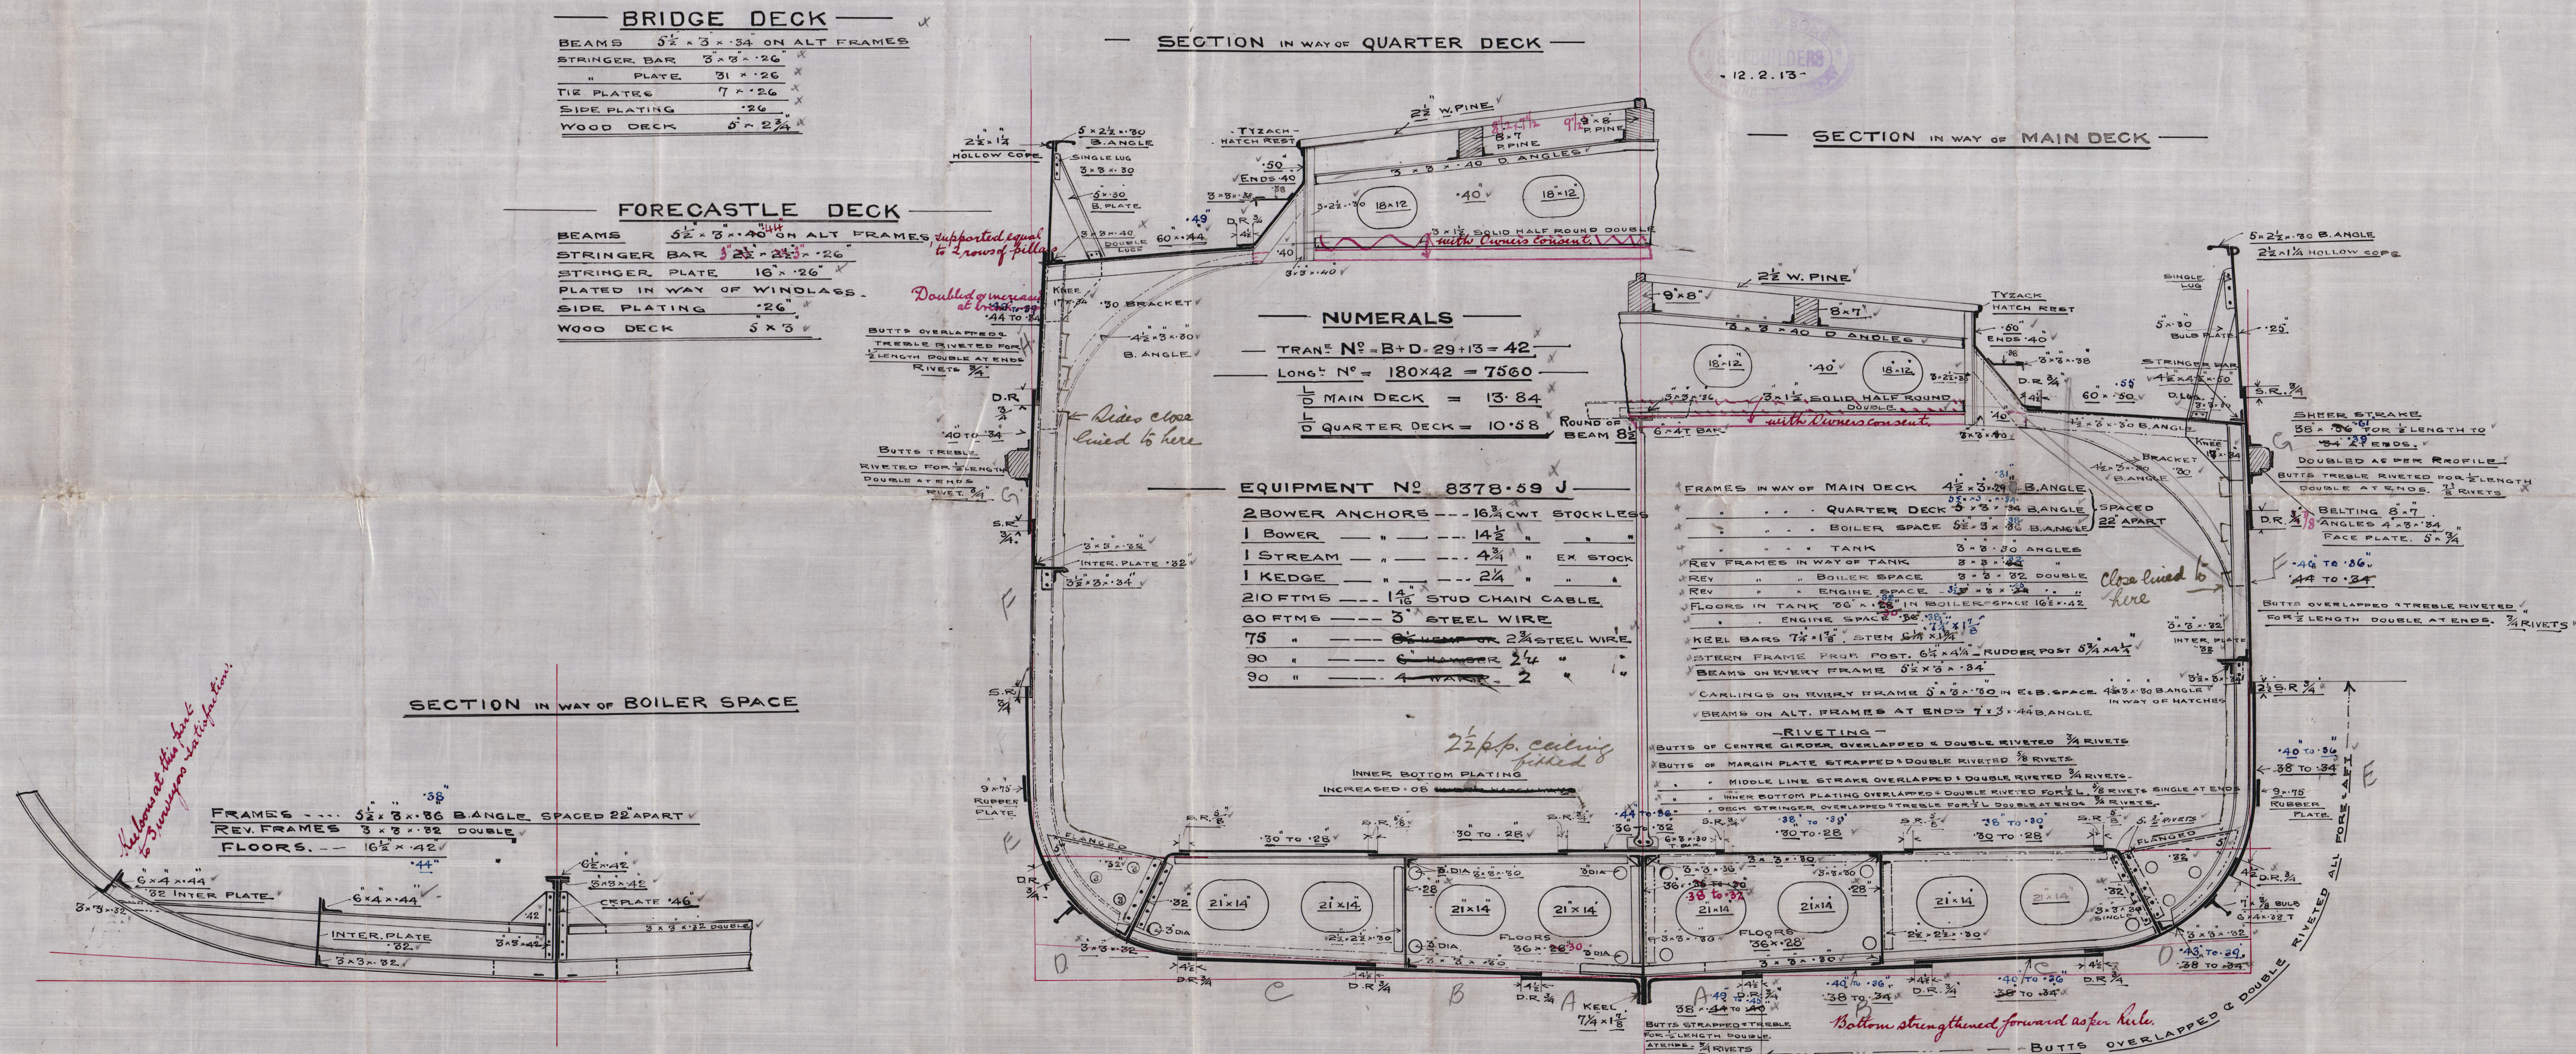

17.2.13

-12.2.13-

Scott & Sons
No 249
Midship Section

"Barrowdore"

GLASGOW REPORT No. 33658



© 2020

Lloyd's Register
Foundation

002667-002673-0111