


Lloyd's Register of Shipping.

Ship's Name "CARROWDORE" Official No. 132047

Memorandum of alterations reported since ship was surveyed for assignment of Load Lines in _____

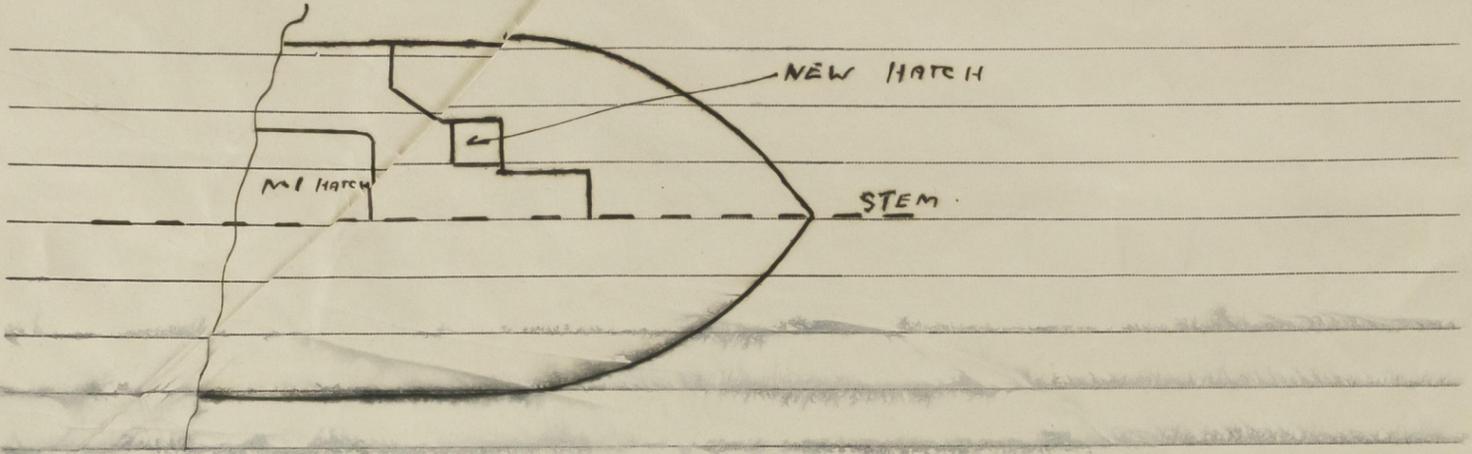

Small escape hatch to No. 1 Hold

2'6 1/2" x 2'0" Height 3'0 3/8" coaming plate 5/16"

electric welded to deck, with a ladder down to the hold.

Efficiently covered by steel hinged watertight steel plate

secured in place by toggles

1.1/16" x 1.1/16" x 5/16" angles round top of hatch.

C.H.W.

C.H.W.
28 DEC 1950

