

30.12.99
29.8.00

D. To L. = 12.15
R. To L. = 6.00

Twin Screw Hopper Barges N^o 37788.



To Class A1 Steel Hopper Barge.

Scale $\frac{1}{8}$ inch = One foot.

Length as per Rule	165.0
Breadth moulded	27.5
Depth Do	13.0
Do as per Rule	13.58

Numeral's.

$\frac{1}{2}$ Girth	25.29.
$\frac{1}{4}$ Breadth	13.75
Depth	13.68
	52.62.1 $\frac{1}{2}$
Length	165
	8682.30.2 $\frac{1}{2}$

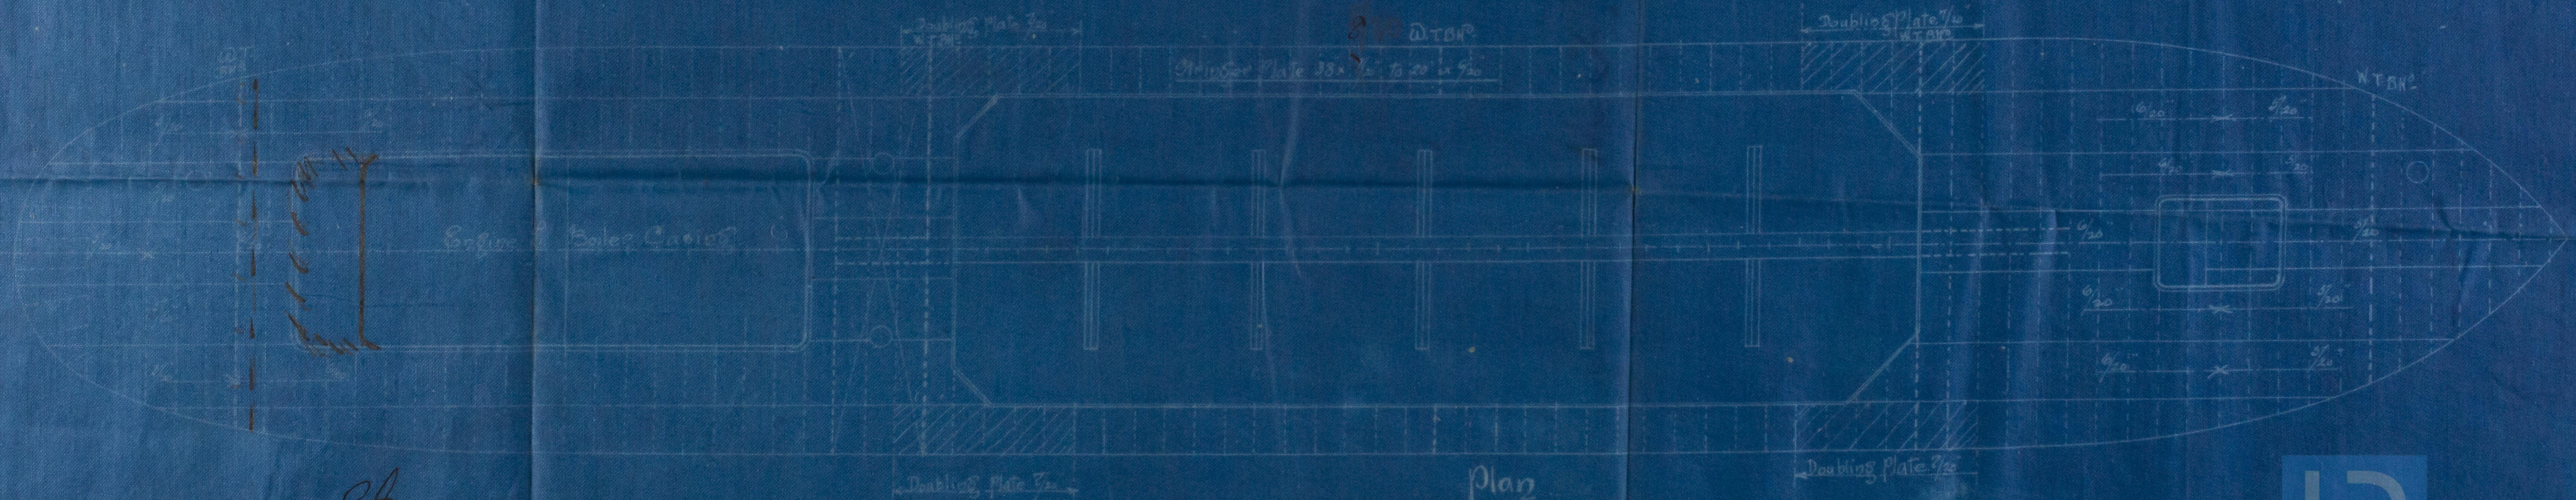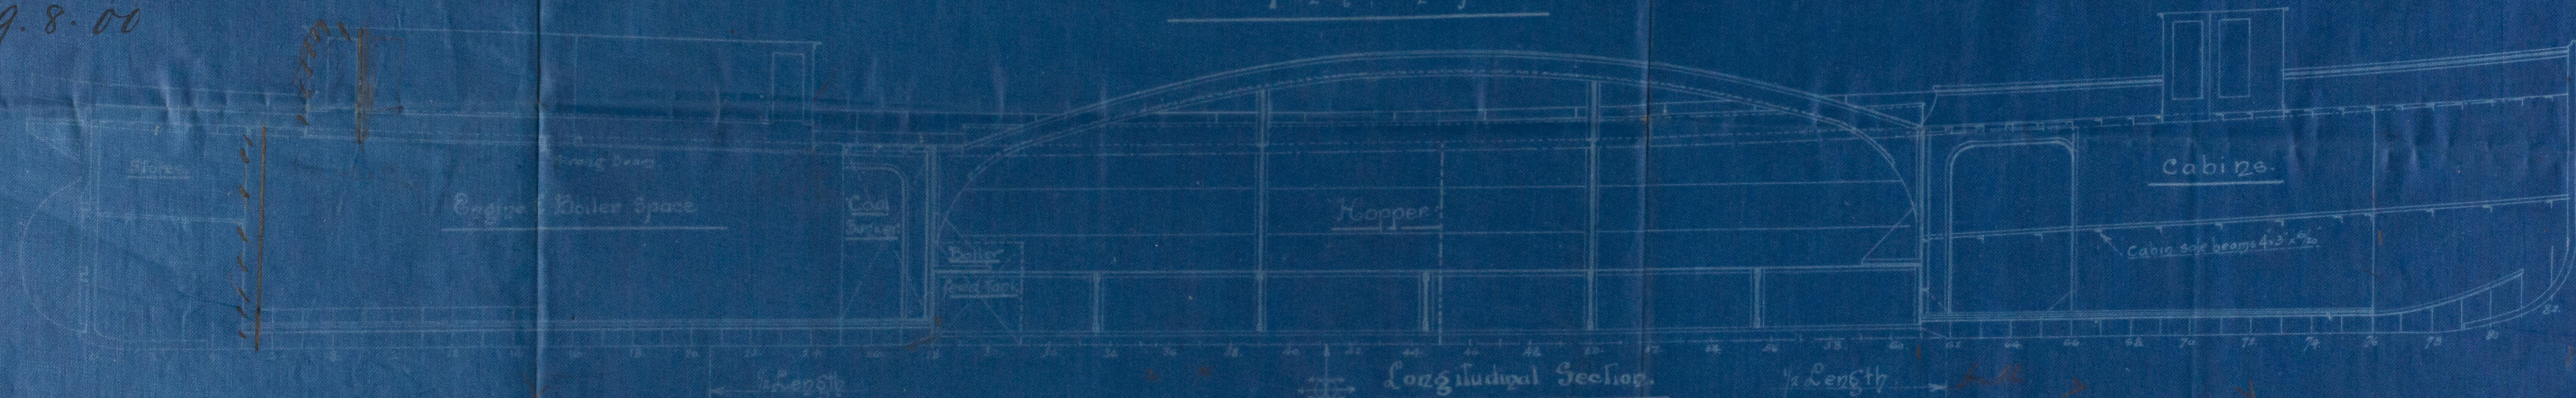


98
19.12.99



W. Simmons & Co

N^o 377 + 8

Profile + Deck Plan

N^o 377  FROME

Glo rpt N^o 18418

N^o 378 AVON

Glo rpt N^o 18423



© 2021

Lloyd's Register
Foundation

002690-002702-0362