


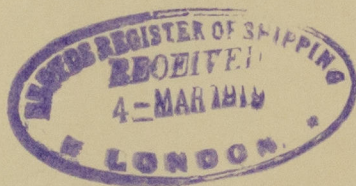



S.S. "Grim", Rockums Yard No. 128.  
Brakms 54.

Midship section.  
(Vessel as built.)



© 2020

Lloyd's Register  
Foundation

002701-002710-0058