

21 JUN 1944


Lloyd's Register of Shipping.

Ship's Name S/S "GRIM"

Official No. 6064

Memorandum of alterations reported since ship was surveyed for assignment of Load Lines

in

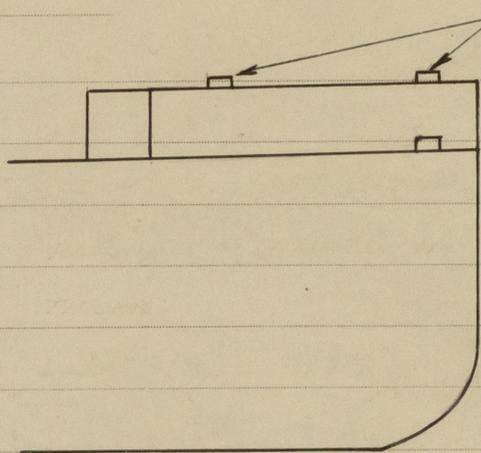

DIM. 550x550 MM


HEIGHT OF COAM. 260 MM

THICKN. " " 10 MM

COVER HINGED STEEL PLATE W.T.

THICKN. 8 MM. CAPABL. OF BEING

MANIPULATED FROM BOTH SIDES.

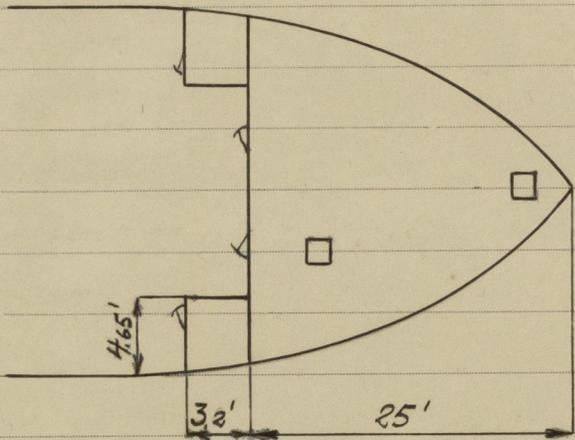

SIZE OF OPENINGS IN FORECASTLE

BULKHEAD 59x23"

HEIGHT OF SILLS 17" ABOVE ST. D.

HINGED STEEL DOORS CAPABL.

OF BEING MANIPULATED FROM

BOTH SIDES.

FORECASTLE AMENDED AS PER SKETCH ABOVE.

*Malmö, 1st June 1944.
A. Börning*

