

Lloyd's Register of Shipping.



Ship's Name

S/S "GRIM"

Official No. 6064

Memorandum of alterations reported since ship was surveyed for assignment of Load Lines

in

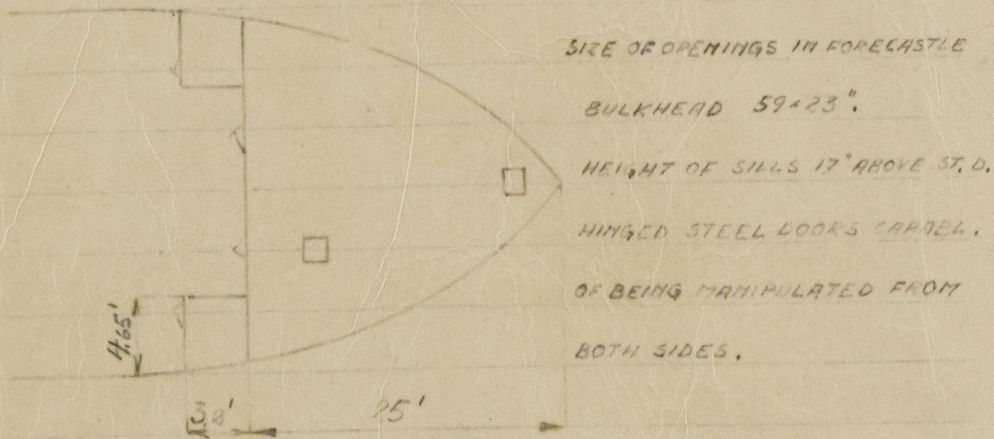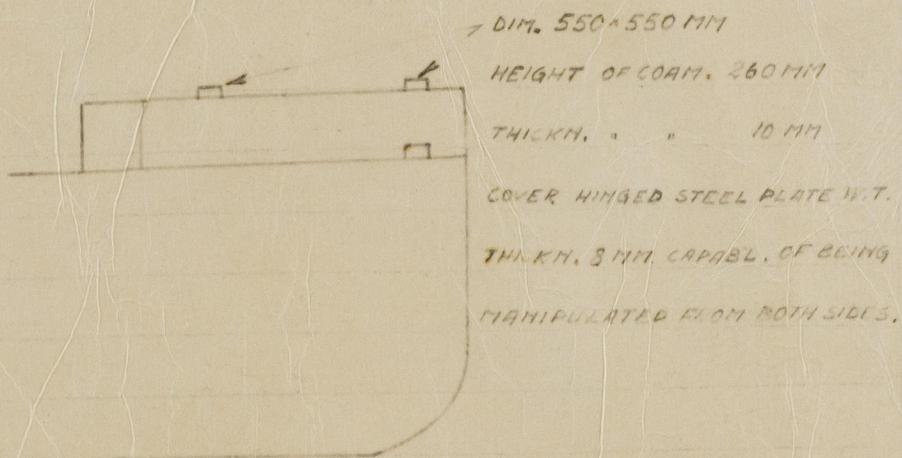

FORECASTLE AMENDED AS PER SKETCH ABOVE

Malmö, 1st June 1944.
 A. Barring



© 2020

Lloyd's Register
Foundation

002701-002710-0063