

32	2	17	0
32	2	18	9
32	2	19	10
37	2	21	14
38	2	21	14

# S.S. "EMPIRE CONFORTH" Ex: "ERNA"

## MIDSHIP SECTION

SCALE  $\frac{3}{4}'' = 1 \text{ FOOT}$


CLASS GERM: LLOYD  $\star$  100A [E]

LENGTH B.P. 194'-0"

BREADTH M<sup>LD</sup> 32'-9"

DEPTH M<sup>LD</sup> TO MAIN DK 16'-0 $\frac{1}{2}$ "

" " TO R.Q. DK 20'-0 $\frac{1}{2}$ "

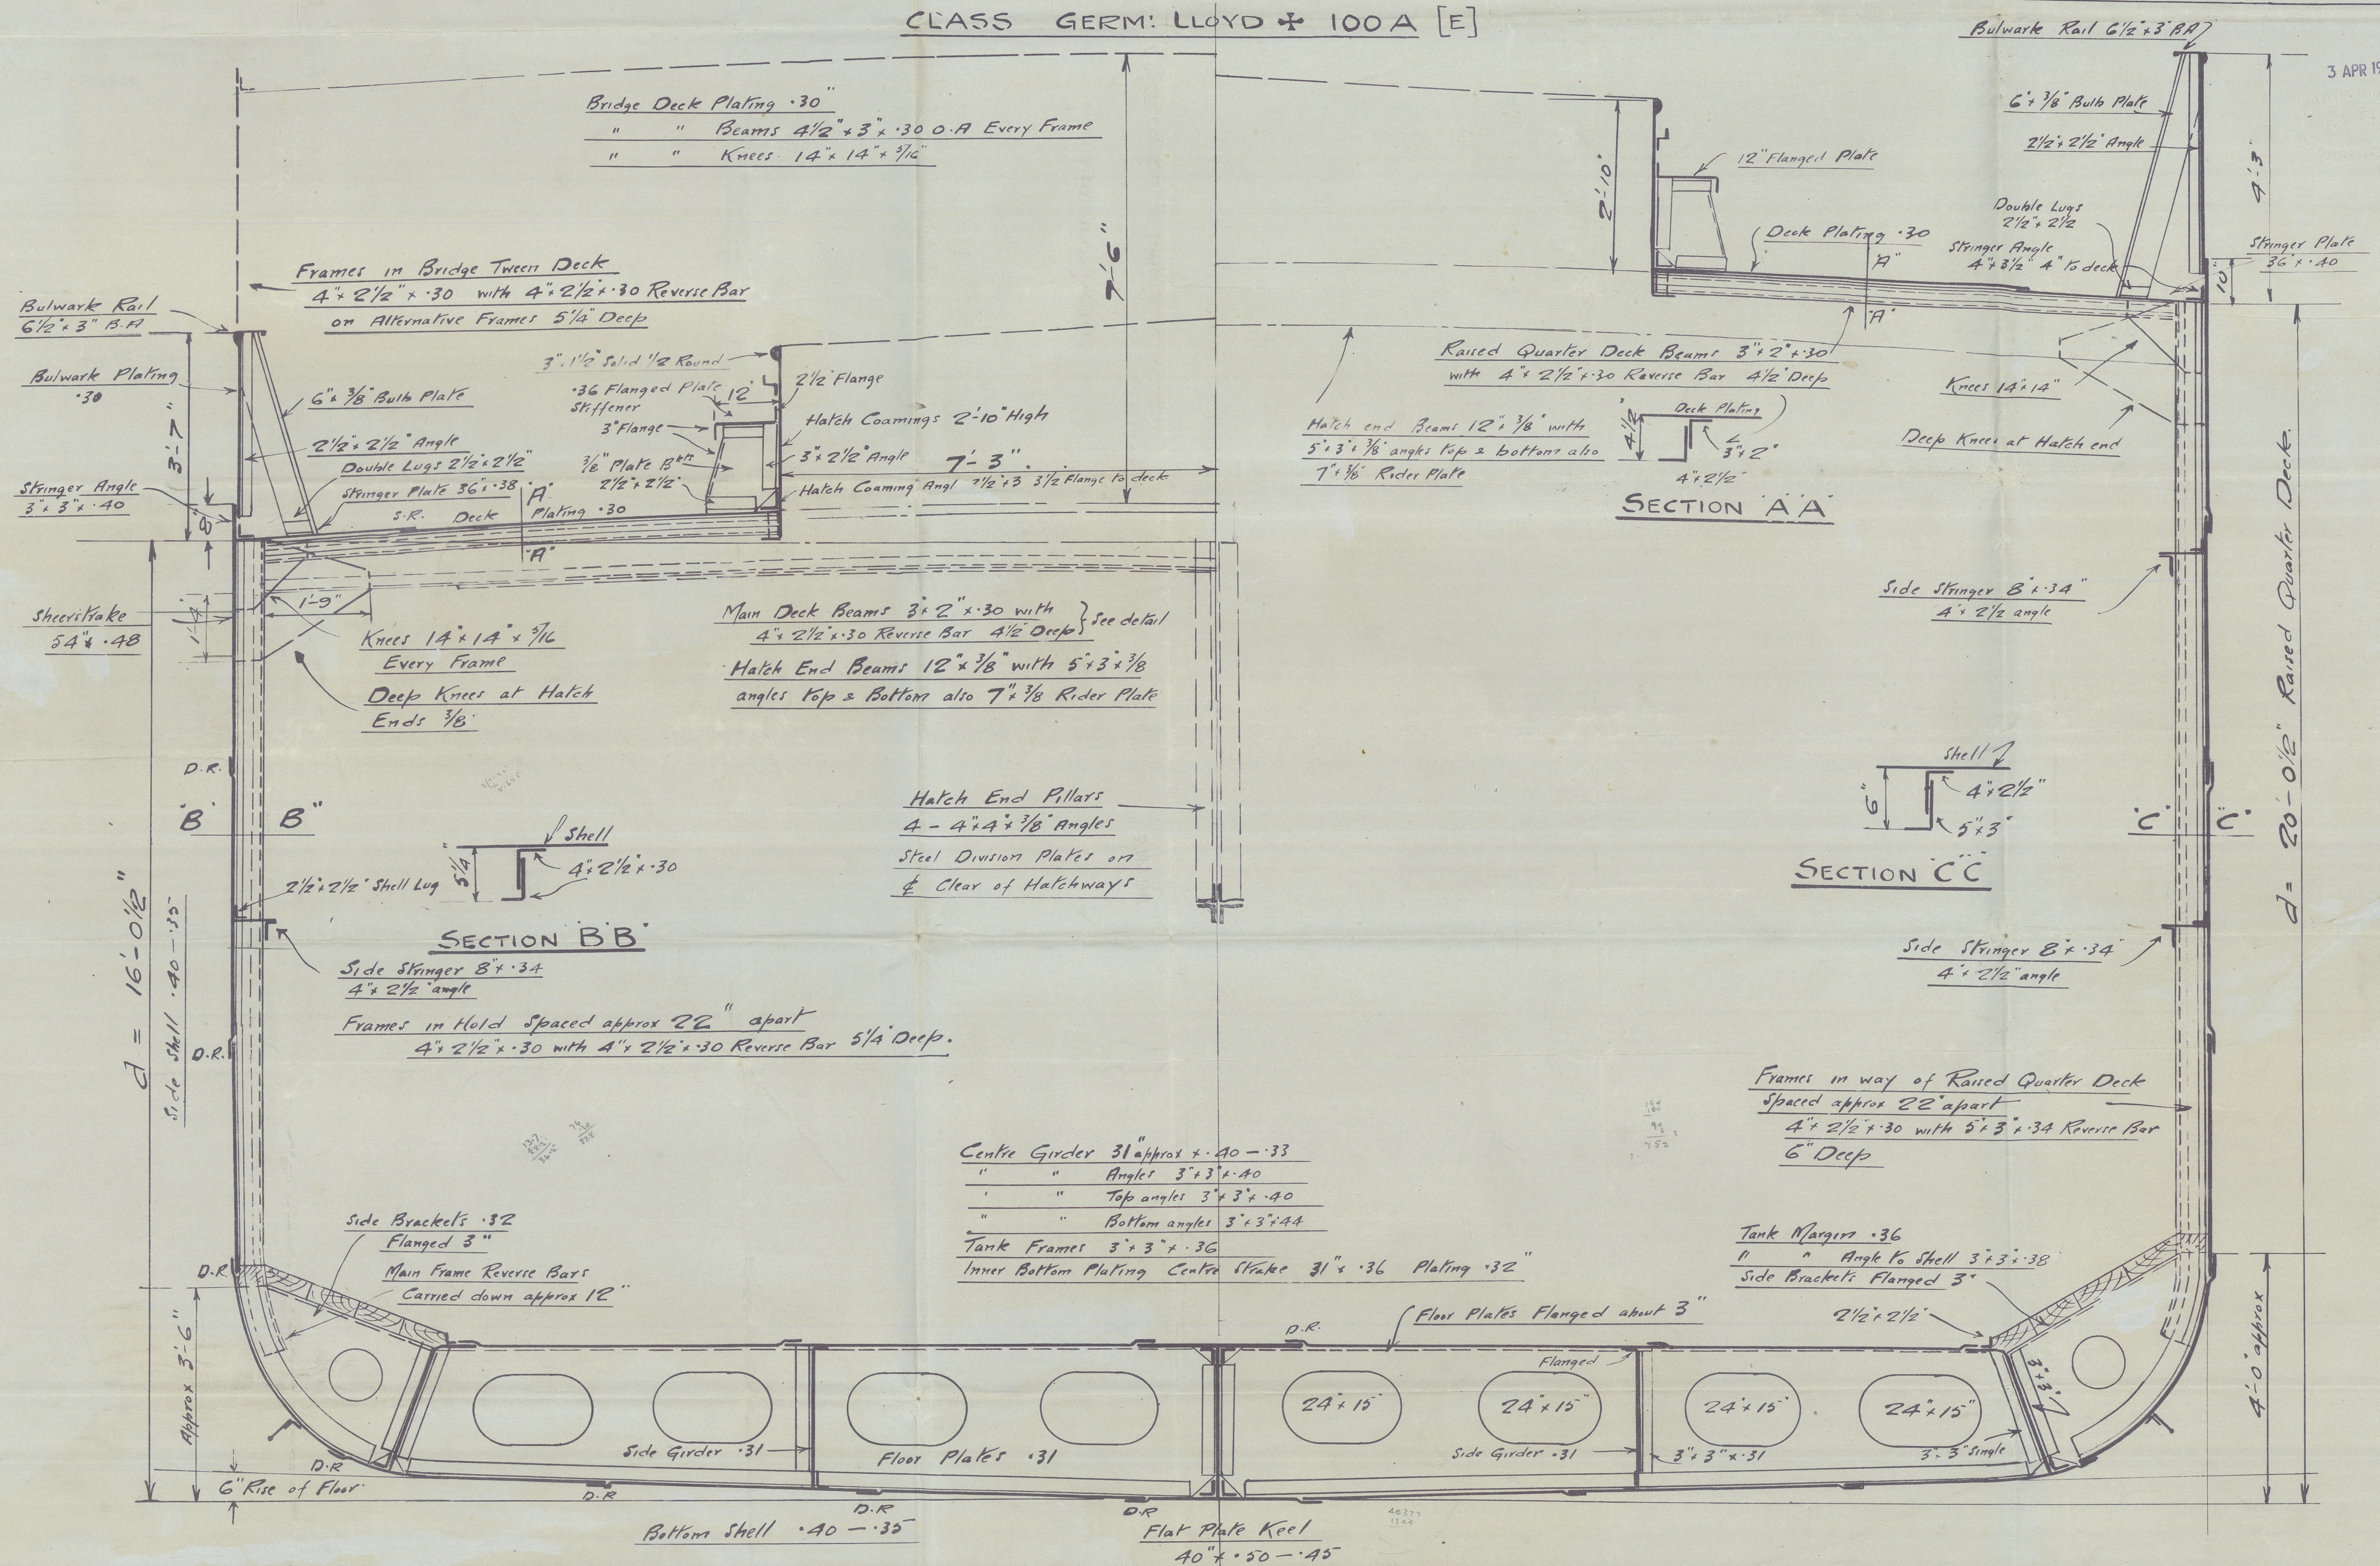



1  
Midship Section

S/S TROODOS ex EMPIRE CONFORTH.

N.N. BURICA

Hull 3.4.47.

Midship Section

S/S EMPIRE CONFORTH ex ERNA

3 APR 1947

Bay



© 2021

Lloyd's Register  
Foundation