

Midship Section
Vessel as built

N^o. 522


Don Henderson.

Glasgow No. 39753.

" BALZAC "

GLASGOW REPORT No. 39524

s/s Balfe*

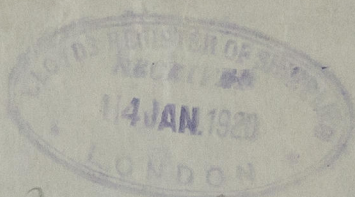

~~Wm. Balfe~~



© 2020

Lloyd's Register
Foundation

002743-002749-0018