

N^o 636 PROFILE FOR FRAMING



M^{LD} DIM^S 425'-0" x 58'-0" x 37'-9" TO SHELTER D^K

SCALE 1/8" = 1 FOOT

SHEER: 10'-6" F. 5'-0" A.

approved for framing only. The numbers and position of W.T. bulkheads to be installed when these have been definitely determined.

all hull angles measured 1924 standard

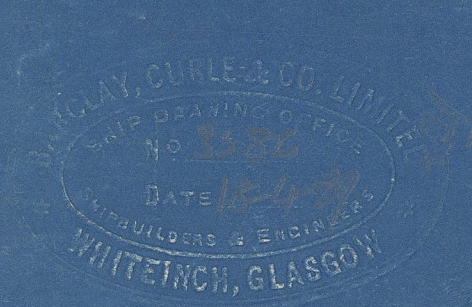 

Barclay, Cuth & Co. Ltd.

No. 636

Profile plan.

"City of Barcelona"

GLASGOW REPORT No. 50356



© 2020

Lloyd's Register
Foundation

002150-002153-0003