

## GENERAL ARRANGEMENT

SCHAAL 1 : 200

## CARGO CAPACITY

HOLD	HOLD UNDER LOWER DECK	54 174	CUBIC FEET
I	UPPER THWEN DECKS	43 445	
	I	UPPER THWEN DECKS	3 536
HOLD II	HOLD UNDER LOWER DECK	73 303	
	I	UPPER THWEN DECKS	50 820
III	UPPER THWEN DECKS	57 276	
HOLD III	HOLD UNDER LOWER DECK	43 420	
	I	UPPER THWEN DECKS	30 785
HOLD IV	HOLD UNDER LOWER DECK	65 445	
	I	UPPER THWEN DECKS	44 503
	II	UPPER THWEN DECKS	37 004
HOLD V	HOLD UNDER LOWER DECK	43 088	
	I	UPPER THWEN DECKS	40 659
	V	UPPER THWEN DECKS	22 553
TOTAL		640 011	640 011 CF
BUNKER	UNDER LOWER DECK	16 422	
	LOWER THWEN DECKS	11 534	
UPPER TANK	DWS SIDES & FURD END OF CASING	20880	
		57076	
DEEP TANK	UNDER LOWER DECK	3 232	
	LOWER THWEN DECKS	28 117	
TOTAL		53349	53349 CF
TOTAL CARGO CAPACITY			751336 CF

THE CARGO CAPACITY IS MEASURED TO INSIDE OF CEILING & TO UNDERSIDE OF DECK BEAMS

## BUNKER CAPACITY

BUNKER UNDER LOWER DECK	380	TONS
LOWER THIEEN DECKS	256	
LOWER THIEEN DECKS ALONGSIDE CASING (PORT)	288	
(STARB)	288	
UPPER THIEEN DECKS SIDES OF CASING & PORE END	688	
SIDE POCKET'S	31	

THE CAPACITY OF BUNKER IS CALCULATED TO THE UNDERSIDE OF BEAMS & TO HALF THE DEPTH OF THE FRAMES; 45 CUB. FT. = 1 TON  
OIL FUEL SETTLING TANKS 76 TONS TOTAL (33 C.F.T OIL FUEL = 1 TON OF 1016 KG)

## CAPACITY OF SUNDRY SPACES

CHAIN LOCKER	5167	CUB FEET
STORES IN HOLE	3772	
STORES IN AFT PEAK	4764	
FORECASTLE	3413	
PRESHOW STORES UPPER THIZEN DECKS	5451	
COWLING ROOM	603	
FREEDING ROOM	603	
WASHAGE ROOM	1203	
VALUABLE CARGO SPACE	1519	
MAIL ROOM	1356	

## TANKS FOR WATER/BALLAST OR OIL FUEL

DOUBLE BOTTOM TANK I WATER BALLAST OR OIL FUEL	918	TONS WATER	188	TONS OIL FUEL
" " " " " "	365	" "	336	" "
" " " " " "	365	" "	334	" "
" " " " " "	350	" "	292	" "
" " " " " "	250	" "	234	" "
" " " " " "	381	" "	253	" "
DEEP TANK LOWER THIEVEN CHECKS	688	" "	634	" "
DEEP TANK HOLD	983	" "	900	" "
FORE PEAK TANK	509	" "	418	" "
AFT PEAK TANK		" "		" "
COPPERDAM	13	" "		" "
TOTAL	5579	TONS WATER	3041	TONS OIL FUEL
DOUBLE BOTTOM TANK II FRESH WATER		" "	150	TONS
FRESH WATER TANKS IN UPPER THIEVEN DECK		" "	50	" "
TOTAL	417	TONS		" "

## DECK AREAS



WALD I LOWER DECK	3782	SQUARE FEET
WALD I UPPER DECK	3083	
WALD II LOWER DECK	4224	
WALD II UPPER DECK	0564	
WALD III LOWER DECK	2276	
SUNNER LOWER DECK	1033	
DEEP TANK LOWER DECK	1927	
WALD IV LOWER DECK	3075	
WALD IV UPPER DECK	4710	
WALD V LOWER DECK	5233	
WALD V UPPER DECK	2788	
TOTAL	37746	SQUARE FEET

## REMARKS

FORECASTLE DECK COVERED WITH TEAK	2 1/2" THICK
SHELTER DECK AFT IN WAY OF ACCOMM <sup>d</sup> COVERED WITH TEAK	2 1/2"
" " AMHSHIPS " " " " WHITE PINE	2 1/2"
" " UNDER POOLE " " " "	2 1/2"
" " CLEAR OF ACCOMMODATION OF STEEL	
UPPER DECK OF STEEL	
LOWER " " " "	

## DEADWEIGHT

EXCLUSIVE OF BUNKER COAL (1026 TONS)	PROVISIONS (20 TONS)	FRESH WATER (417 TONS)
WITH WINTER FREEBOARD ON A DRAFT OF 30' 9"		12622 TONS
• SUMMER	31-4	13137
• W. SUMMER	32-0	13652

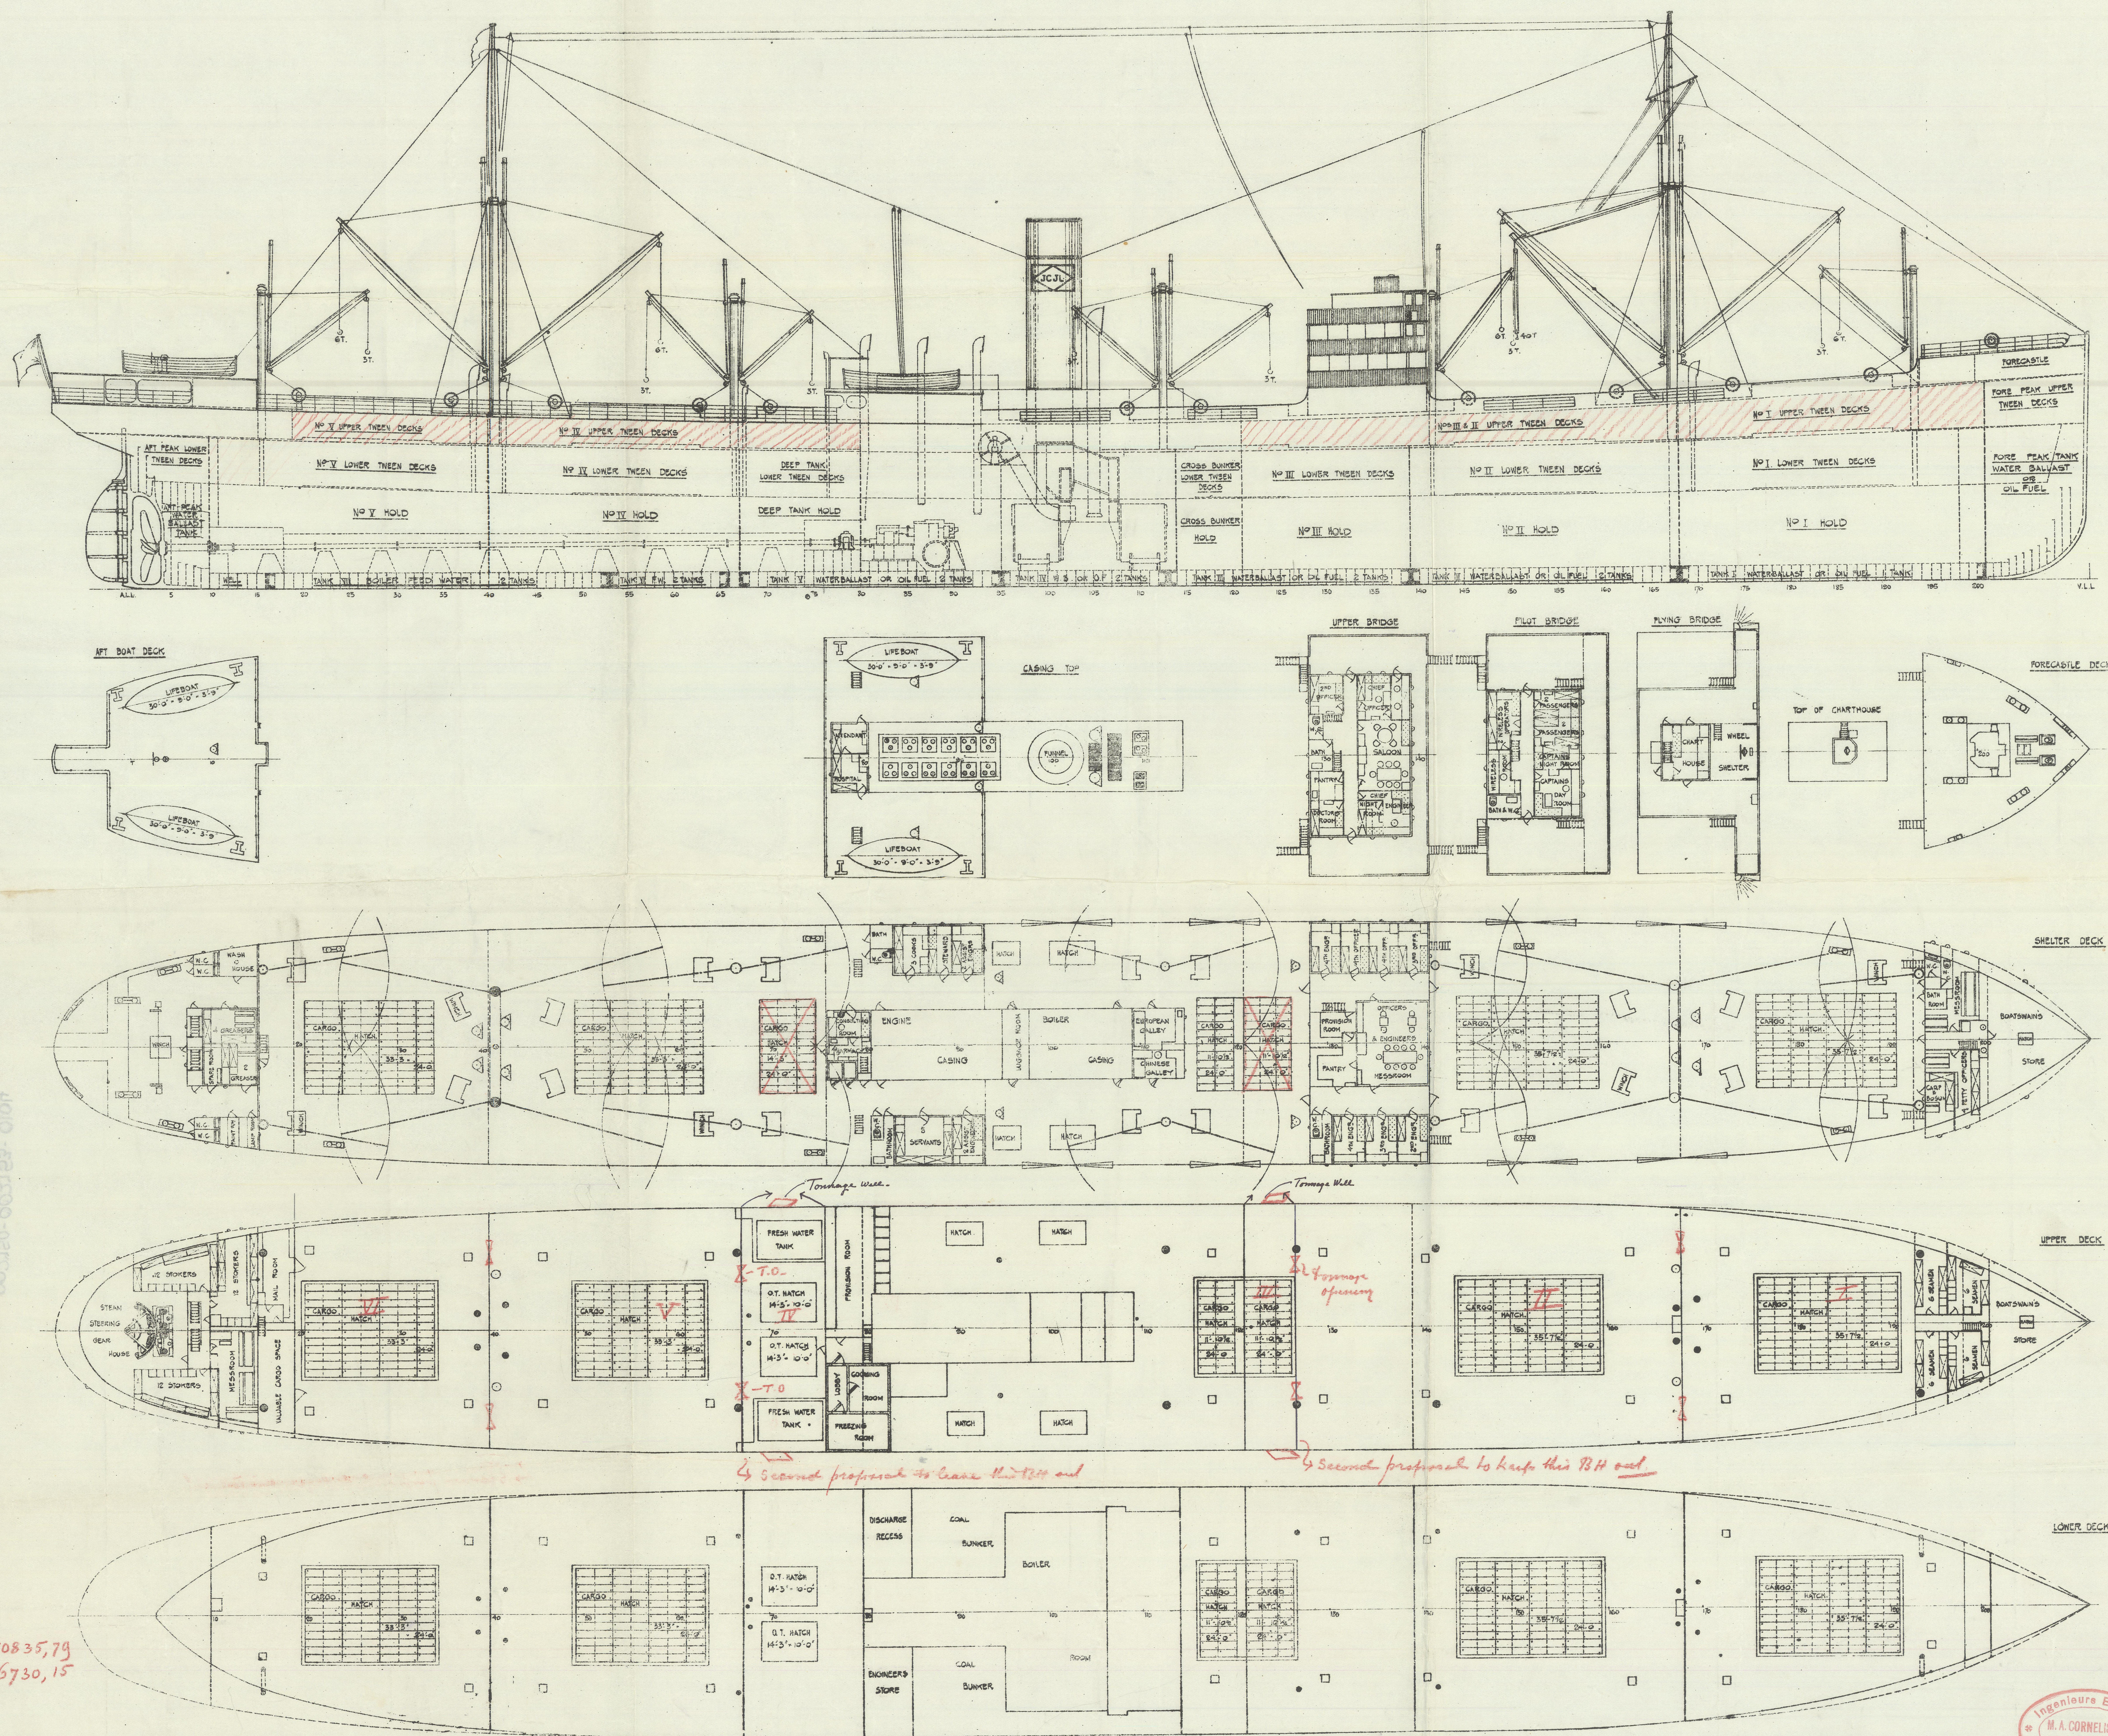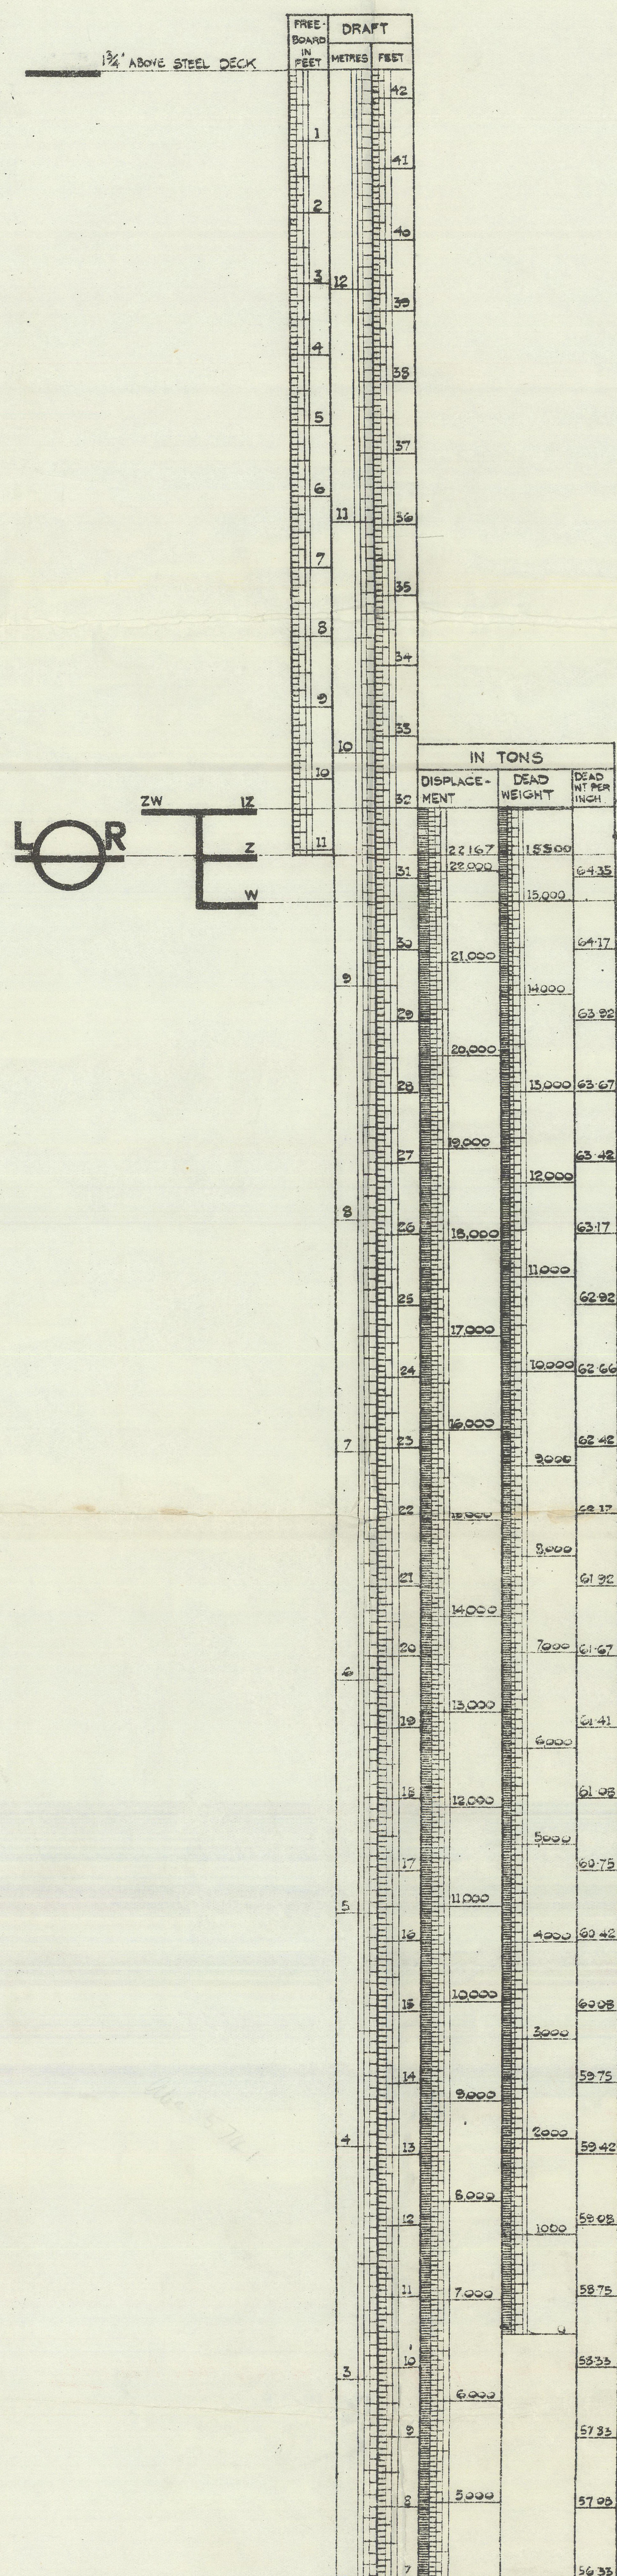

GRAND TOTAL	10835.79
NET REGISTER TONNAGE	6671.54