


Price

404.91
487.55
417.75
1160

1943
266
2610
40.9

all built angles are new German Standard
L. bars cutting, ends of longitudinal, varying 0.5 to 1.0
on approved drawings, 5.000 or 10.000 mm.

accepted 13th Nov. 1934

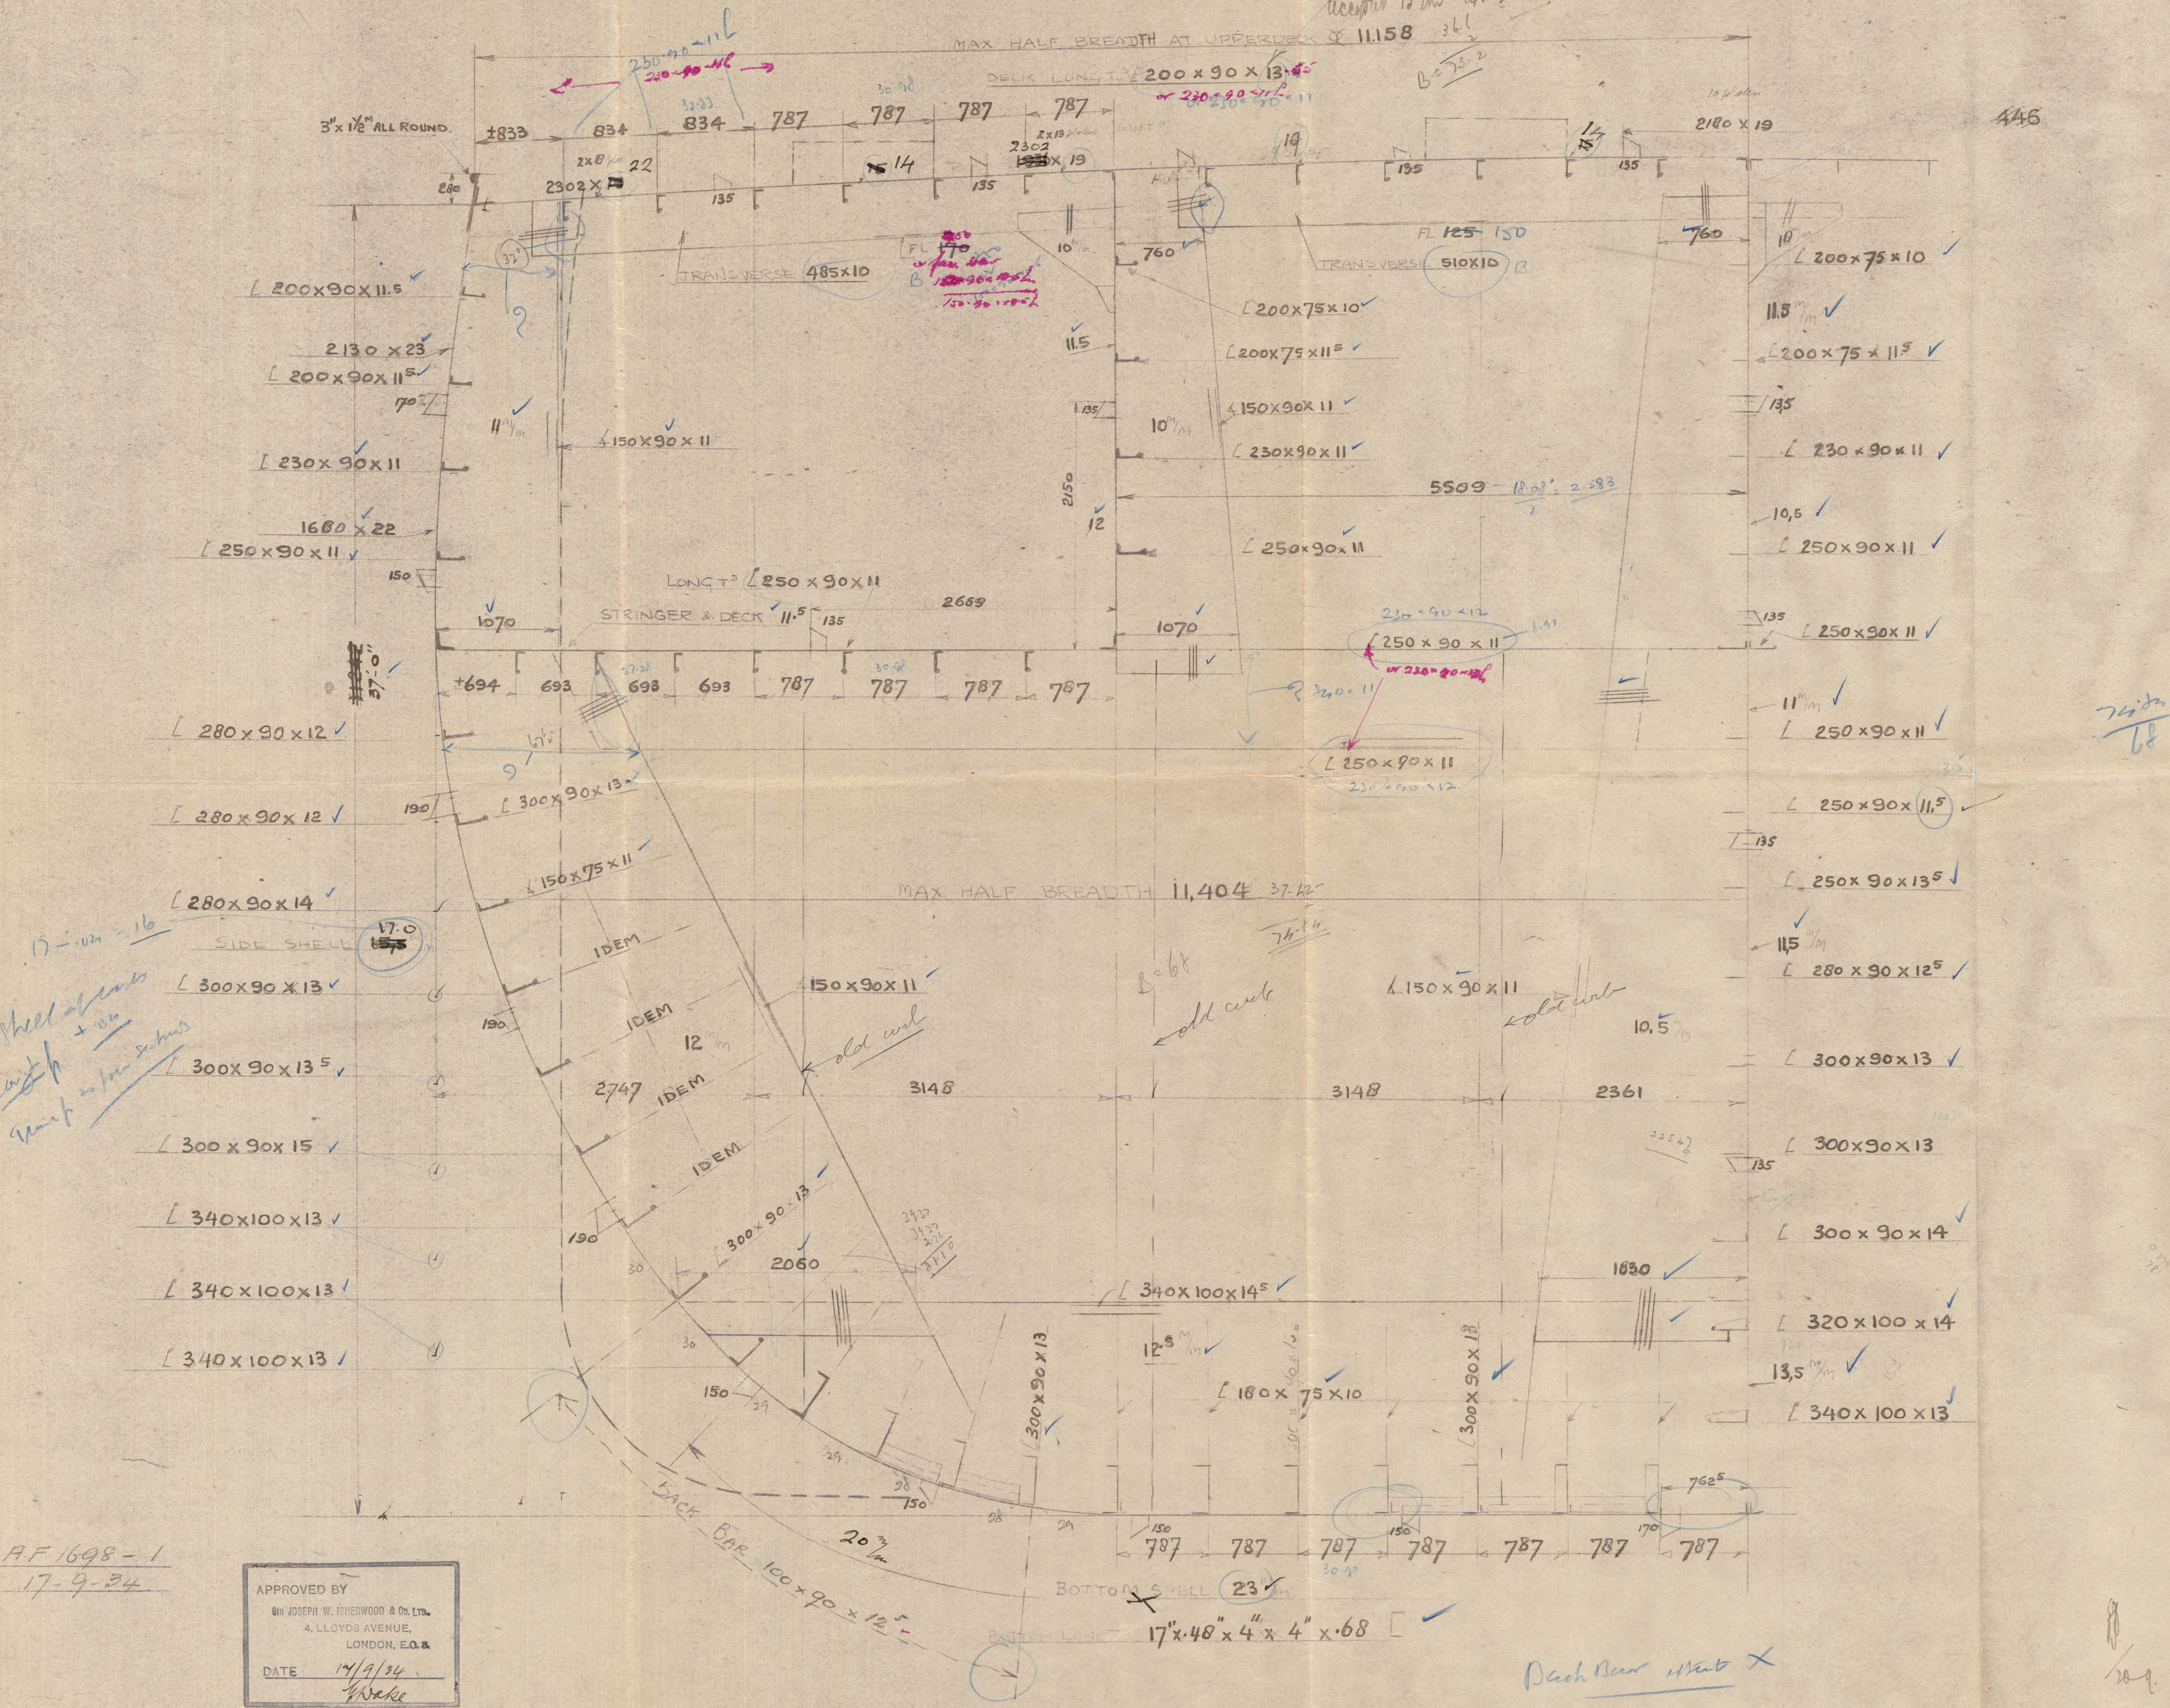

189
MIDSHIP SECTION
SCALE 1:25

R.D.M. - TEKENKAMER - S.

189025

© 2020 Lloyd's Register Foundation

GEN. BOX NO 504

Rotterdamse

26

RECORDS DEPT.
LONDON.

1

189

Midship section.

Revised

Circle form

//

J S Walden

//



Mr

MENARA

© 2020

Lloyd's Register
Foundation

002754-002761-0644
4490-197700-457100