





Malmö

Hockmors Mek. Verkstads Ab.


M/s No. 182 "Sagerfjell"

NN. INDUSTRIOUS

Midships Section of vessel as built.

(Malmö F.E. Report No. 1366)

002754-002761-0192

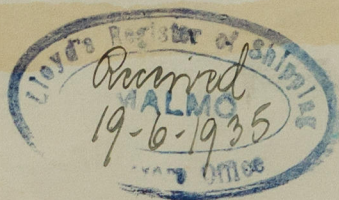

© 2020

Lloyd's Register  
Foundation