

14319
No 325 S.S.


PROPOSED TWEEN DECK.

SCALE 1/4" = 1 FOOT.

ALL BEAMS 8" x 3" x 44 B.A. ✓
1/2 BEAMS AT MATCHES 6 1/2" x 3" x 40 B.A. ✓
DECK PLATING 30" THROUGHOUT. ✓
DECK STRINGER 44" x 42" FOR 1/2 L TO 20" x 38" ✓
STRINGER AND CHOCK ANGLE 3 1/2" x 2 1/2" x 42" FOR 1/2 L TO 38" ✓
From angle only to 3 x 3 x 1/2" - 20" (See Deck Section)


RIVETING

BUTTS OF STRINGER OVERLAPPED AND DOUBLE RIVETED THROUGHOUT ✓
5 LAPS 3/4 RIVETS *Butts of deck plating may be single riveted* ✓
BUTTS OF DECK PLATING OVERLAPPED AND DOUBLE RIVETED FOR 1/2 L ✓
4 1/2 LAPS 5/8 RIVETS ✓
SINGLE RIVETED AT ENDS. 2 1/2 LAPS 5/8 RIVETS ✓
EDGES OF DECK PLATING SINGLE RIVETED 2 1/4" 5/8 RIVETS ✓
EDGE OF STRINGER & DECK PLATES SINGLE RIVETED 2 1/4" 3/4 RIVETS ✓

 


002762-002761-006

A. J. Ingham Ltd.
Tween Deep Plan
No 325

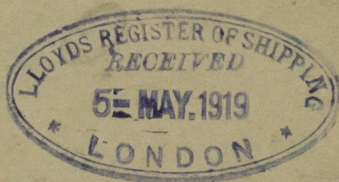

GLASCOW REPORT No. 39493

^{5/5} "Arana"

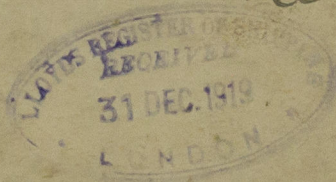

002762-002769-0076



© 2021

Lloyd's Register
Foundation