

PROFILE PLAN.

SCALE 1/8" = 1 FOOT.

PRINCIPAL DIMENSIONS.

LENGTH BETWEEN P.P. 460'-0"
BREADTH MOULDED 59'-0"
DEPTH MOULDED TO UPPER DECK 34'-0"

LLOYDS NUMBERS.

D. 34
L.D. 15640
L(B+D) 42780
L.D. 1352

*Detail
Plan 6th
subordinate*

8-10-11

P.V. = 10







10-11-12





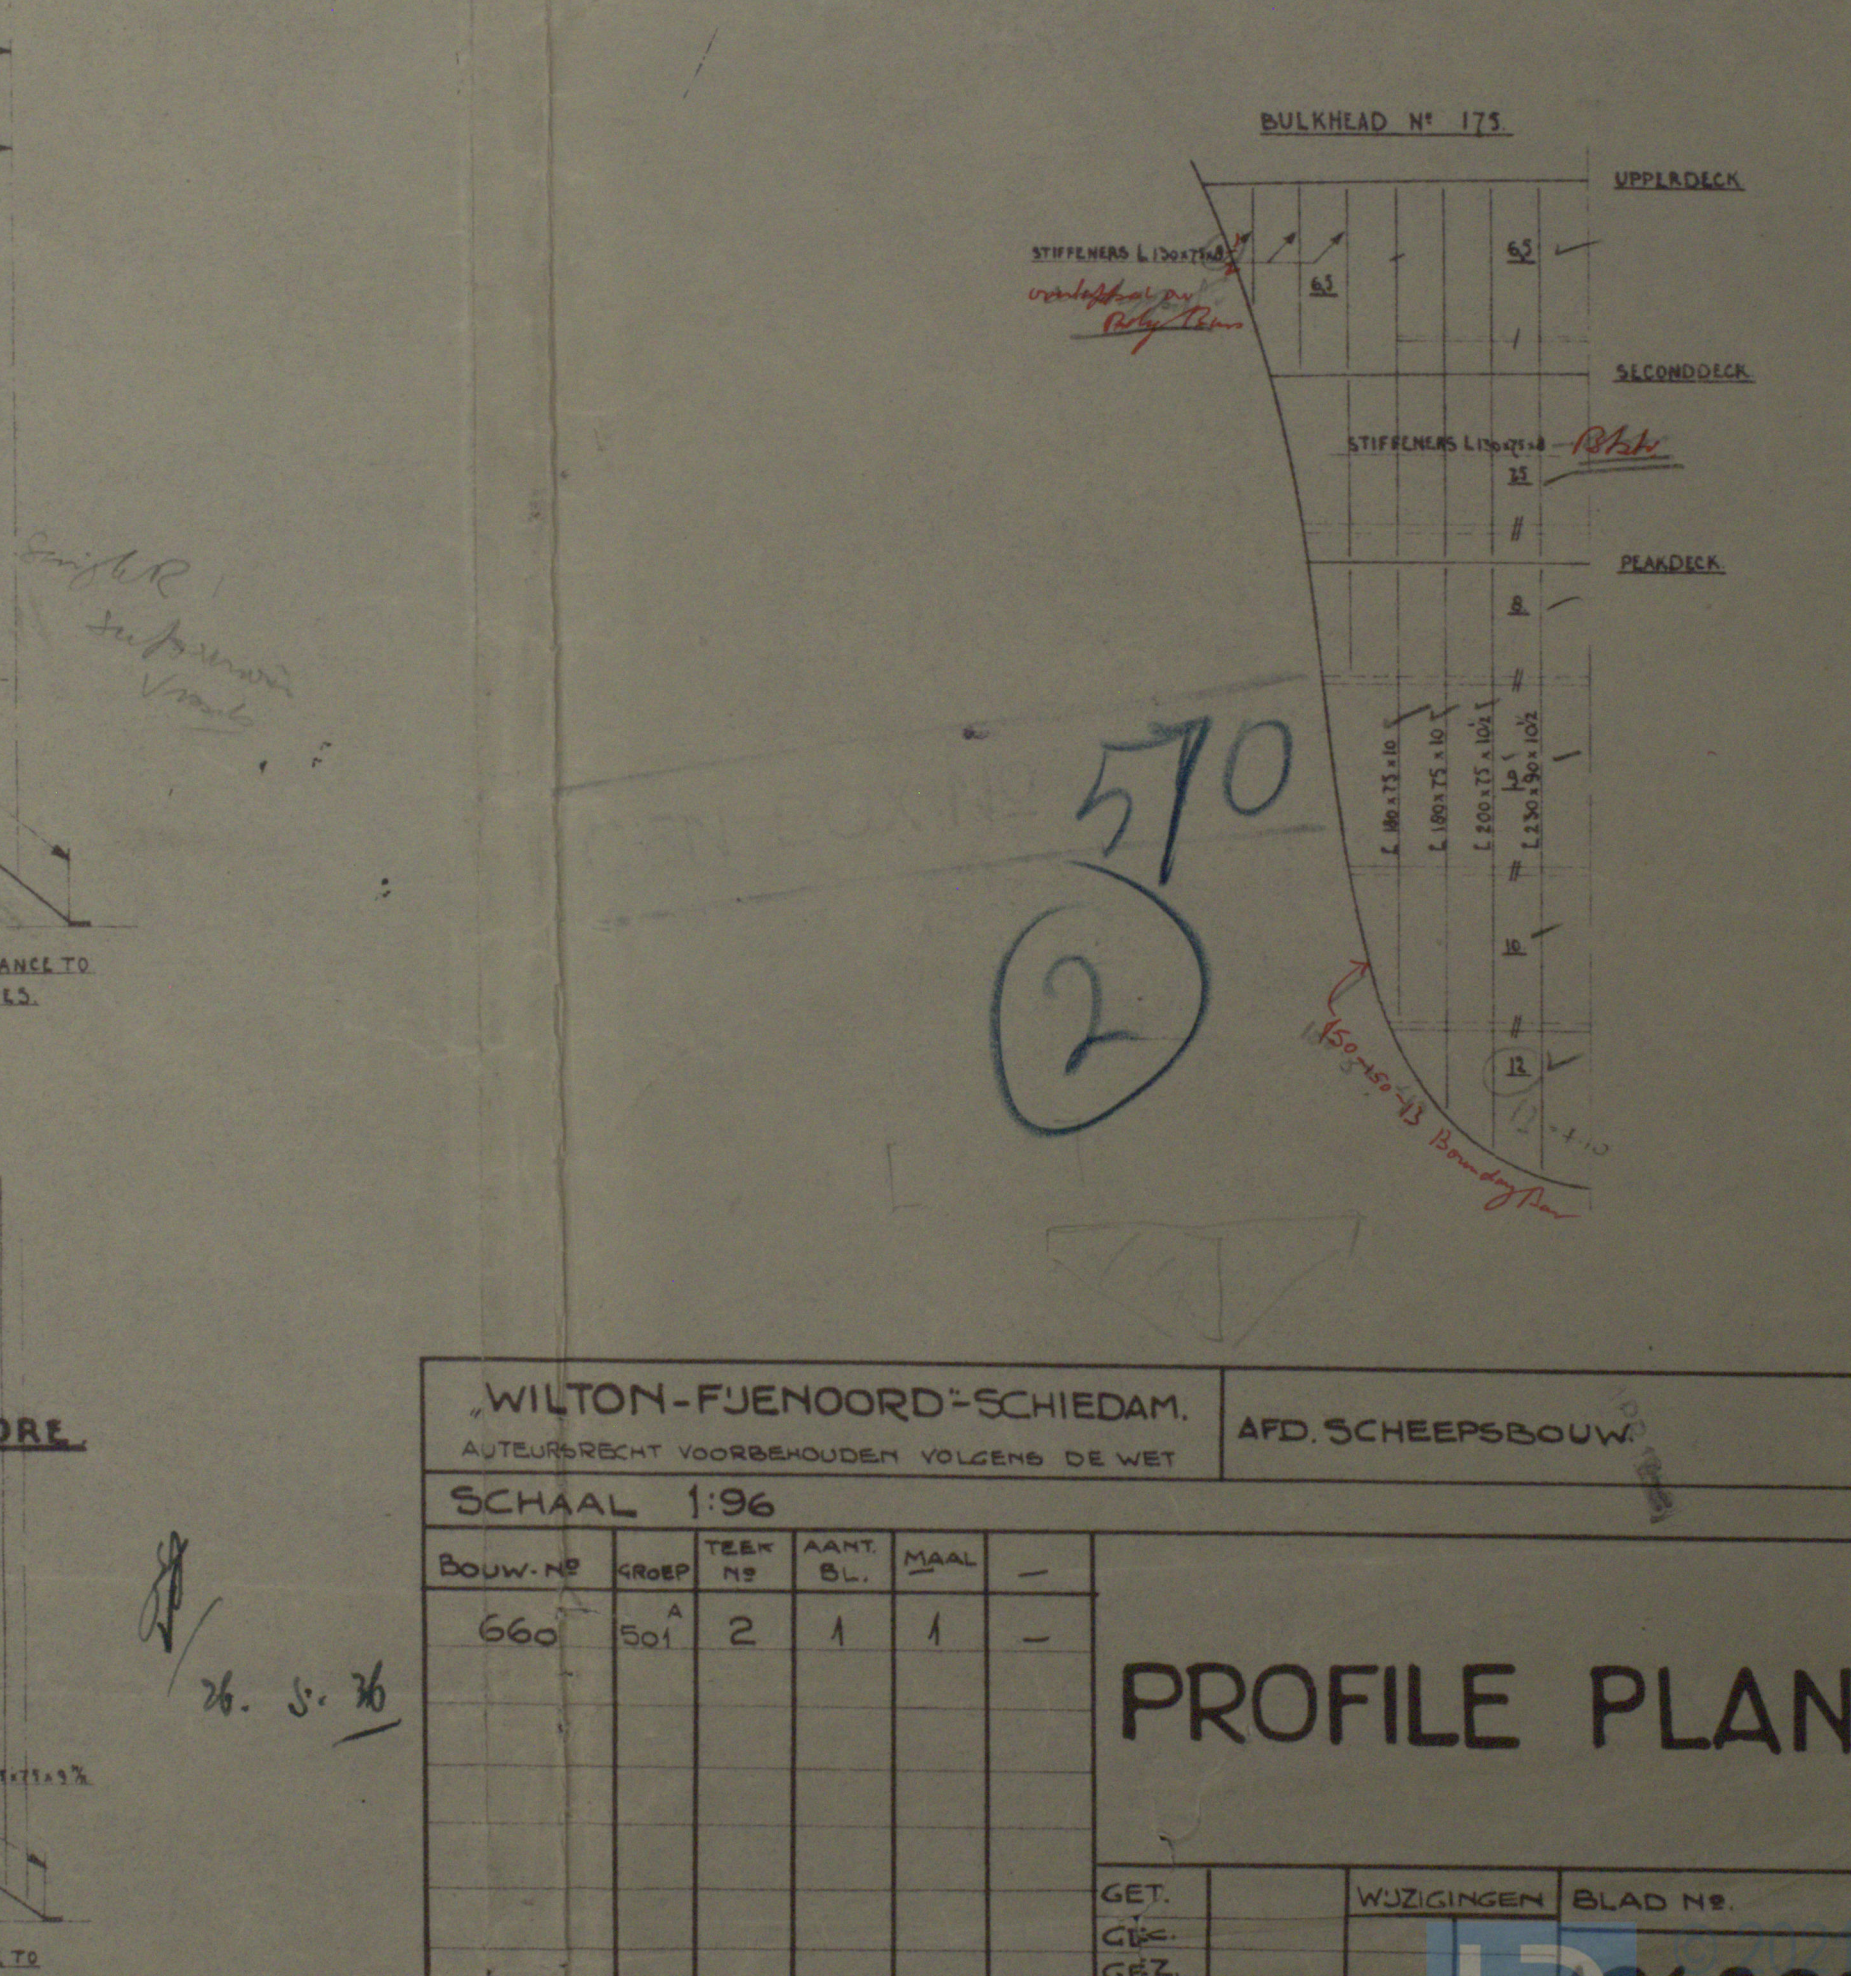 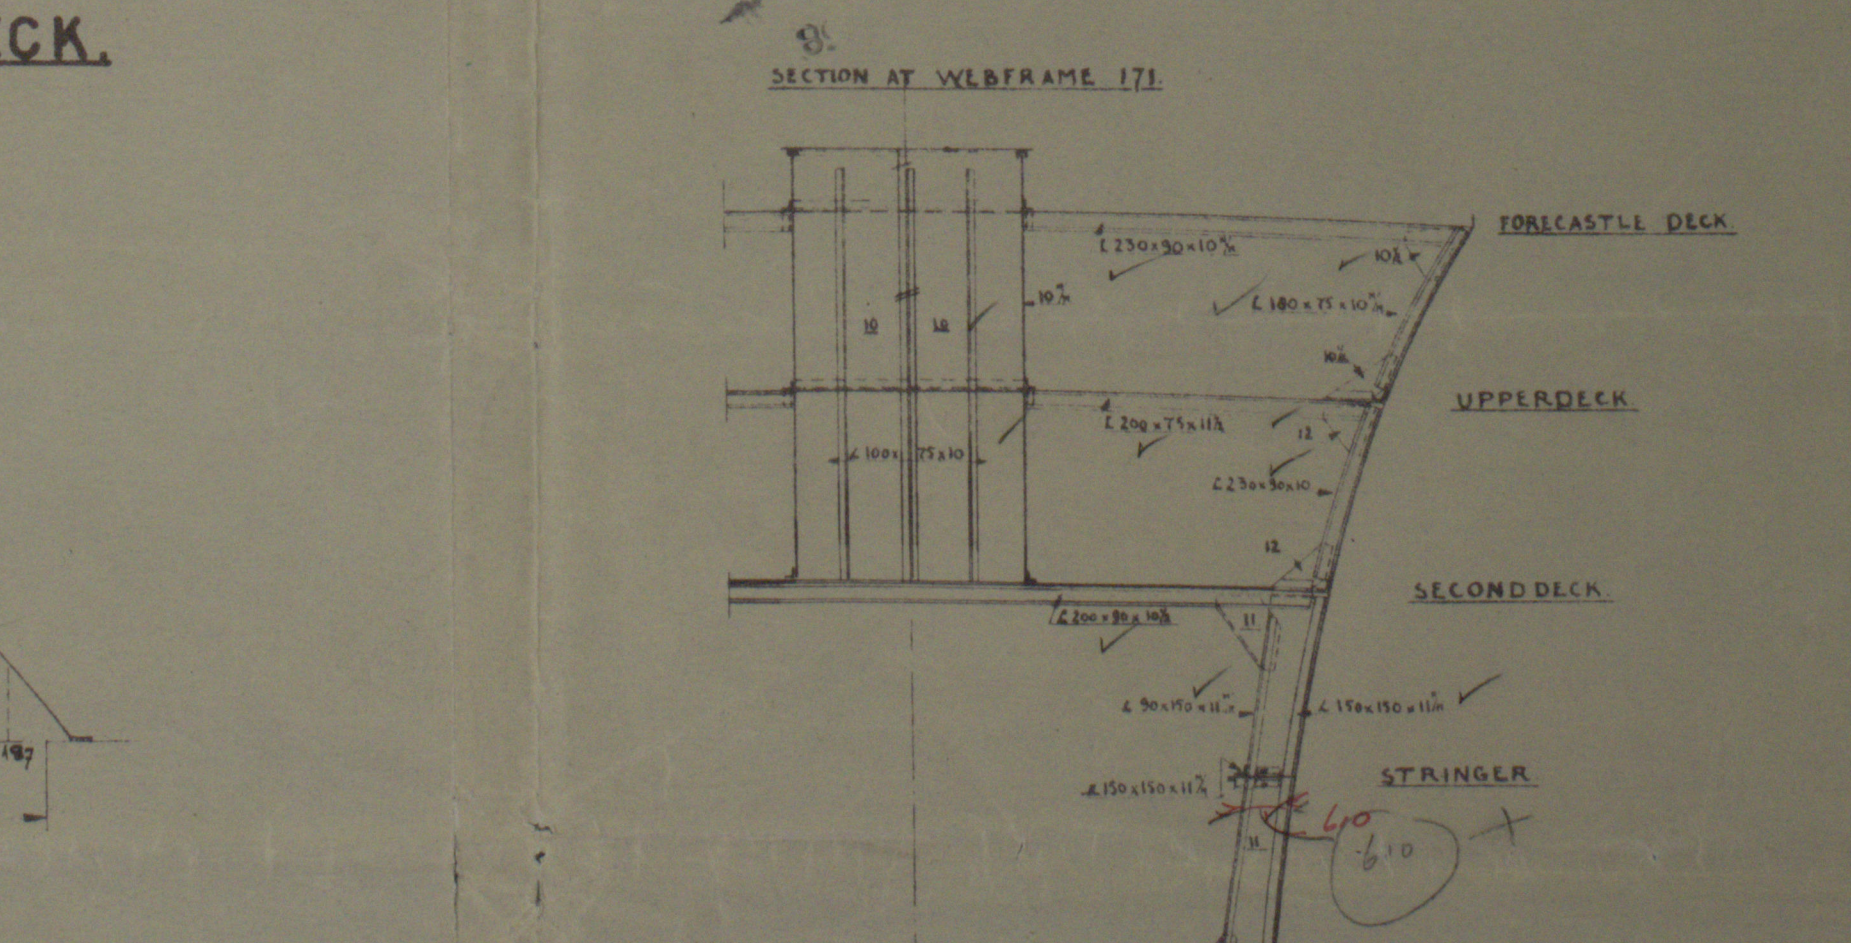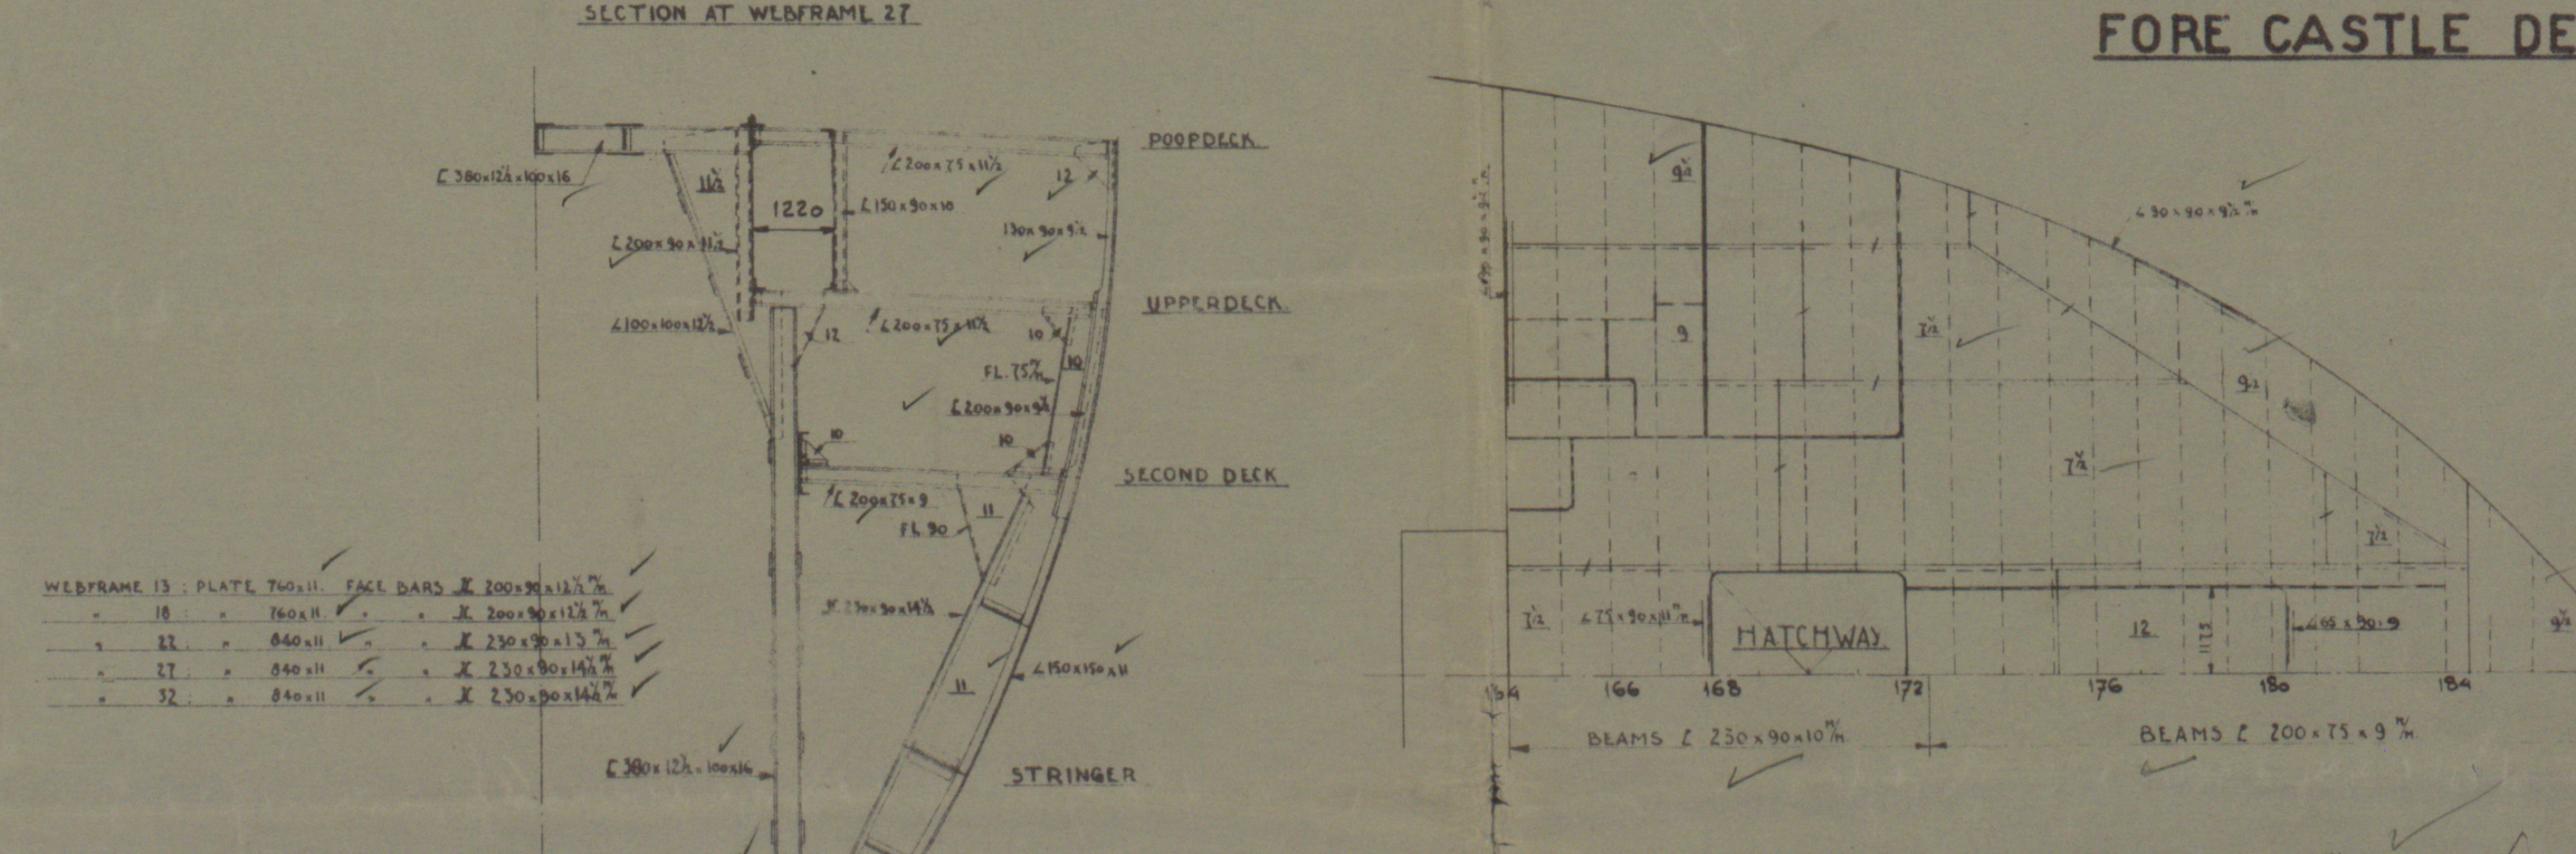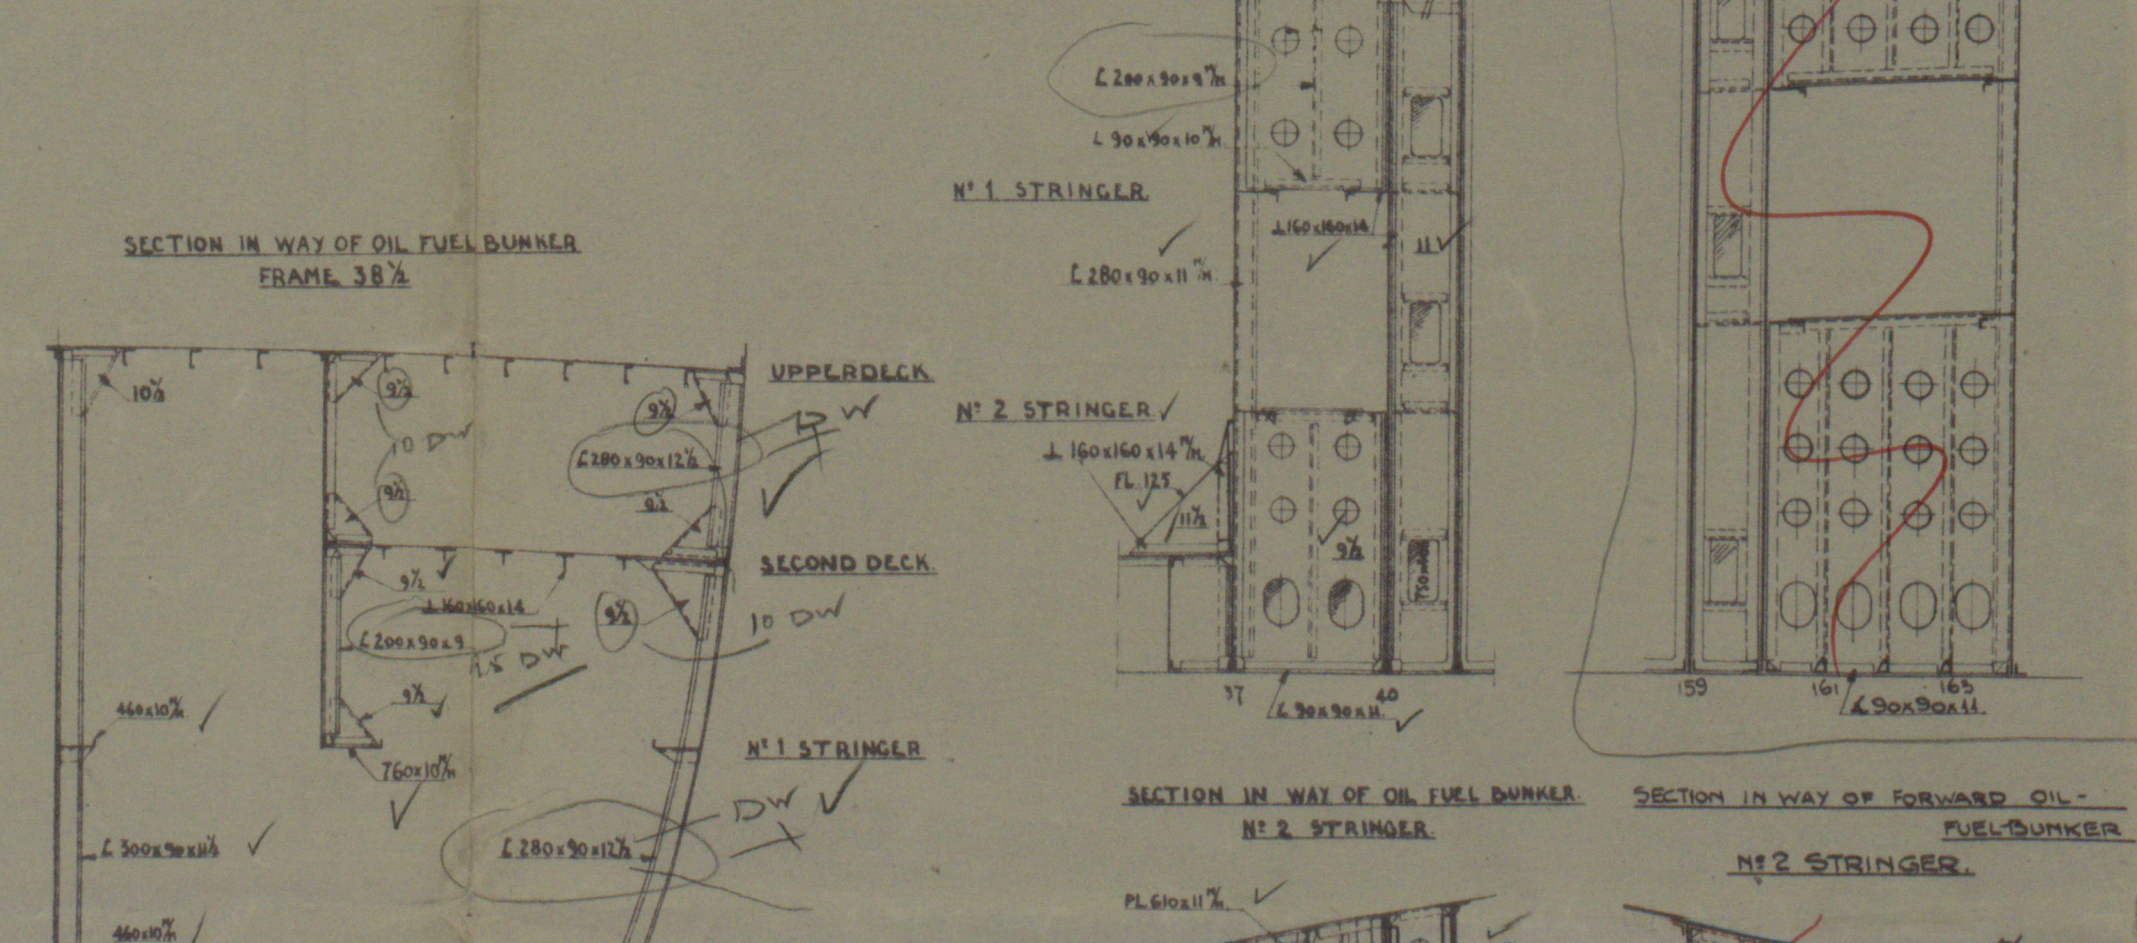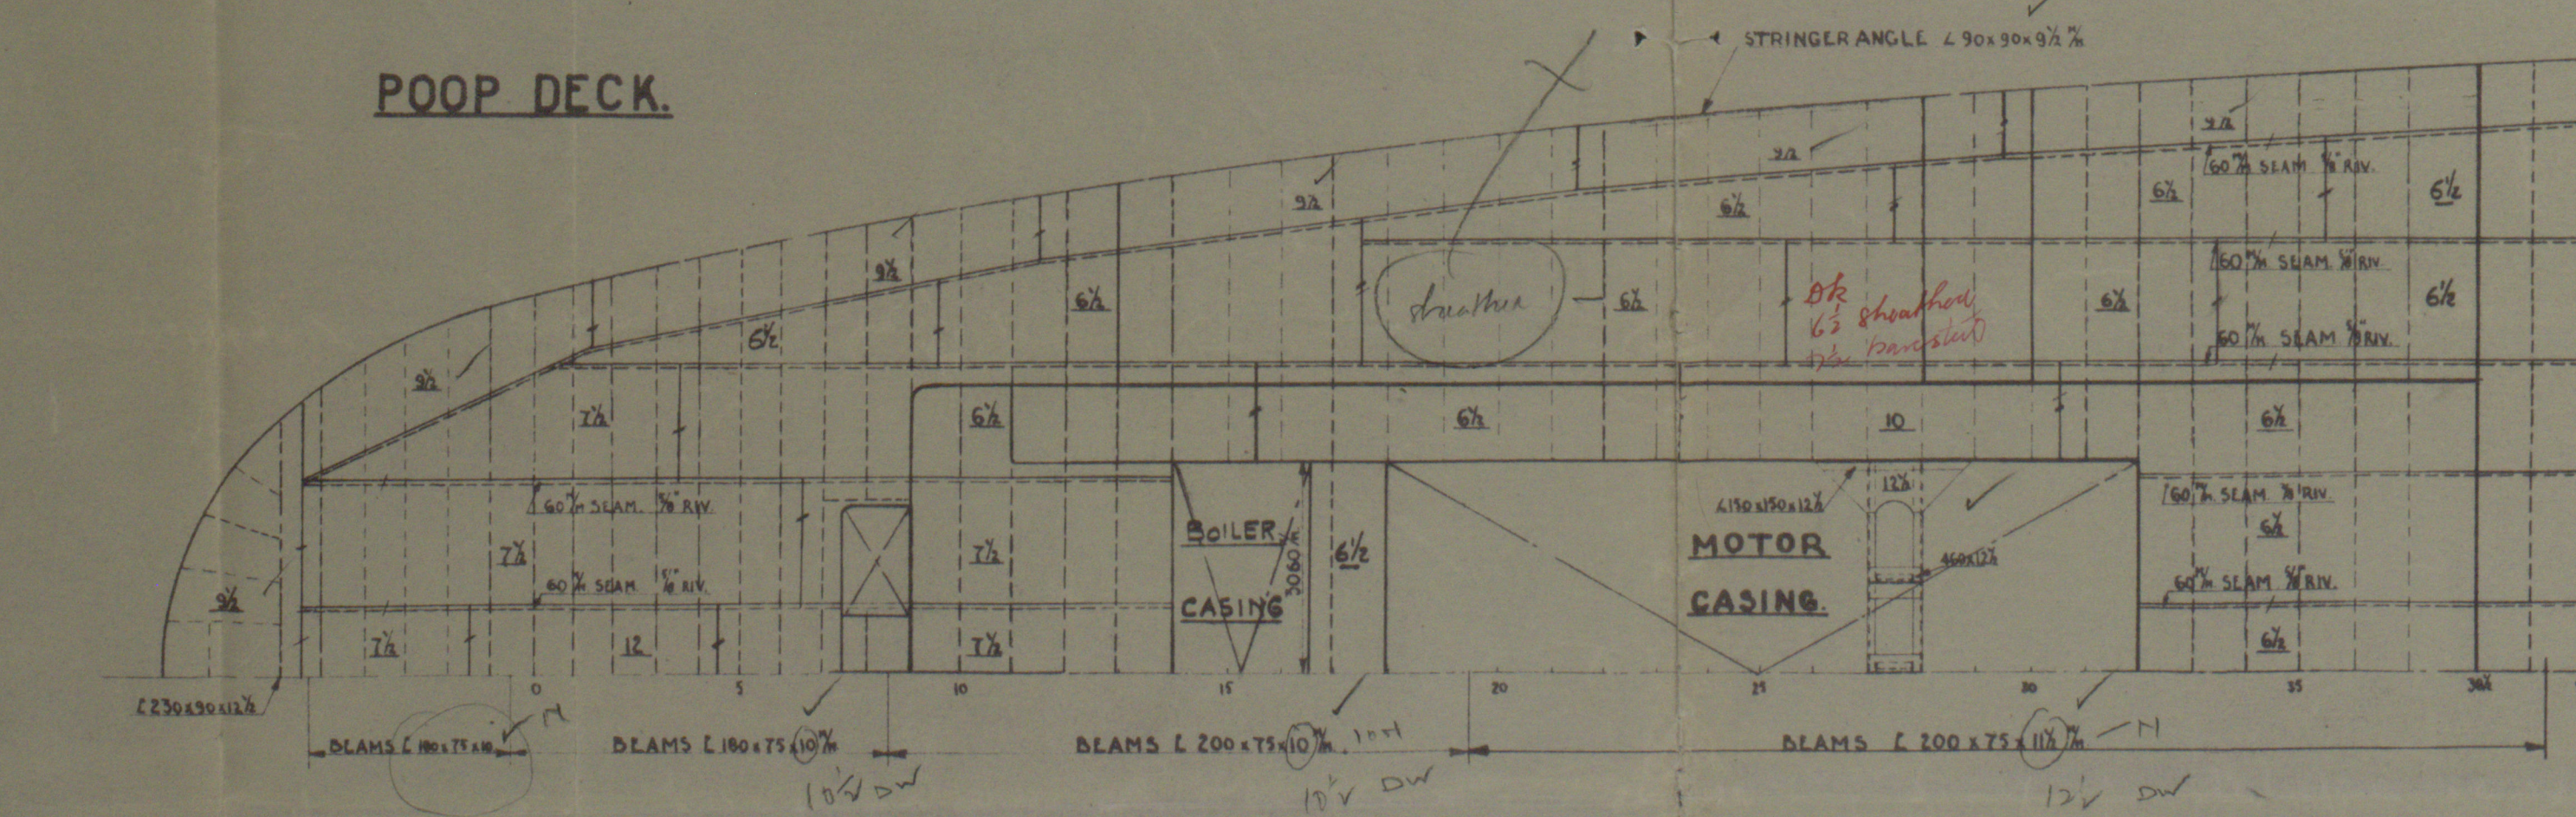

WILTON-FUENORD-SCHIEDAM.		AFD SCHEEPBOUW.	
SCHAAL 196			
BOUW NR.	TEK. NR.	PART. NR.	BLAD NR.
660	2	1	1

PROFILE PLAN.

104223

WILTON - FYENOORD.

660.

PROFILE OF DECKS.

NEDERLAND

002762-002769-0100



© 2021

Lloyd's Register
Foundation