

STEEL SCREW STEAMER

GENERAL STEELWORK PLAN

SCALE 1/4" = 1 FOOT

19.2.17
S.3.17
16/2/19 (no 28)

W.T. Bulk^o 65

NON W.T. TRANSOM


PLAN OF CASING TOP

W.T. RECESSED BULK^o 4-5

W.T. BULKHEAD 21

W.T. BULKHEAD 57

W.T. TANK TOP 57-58

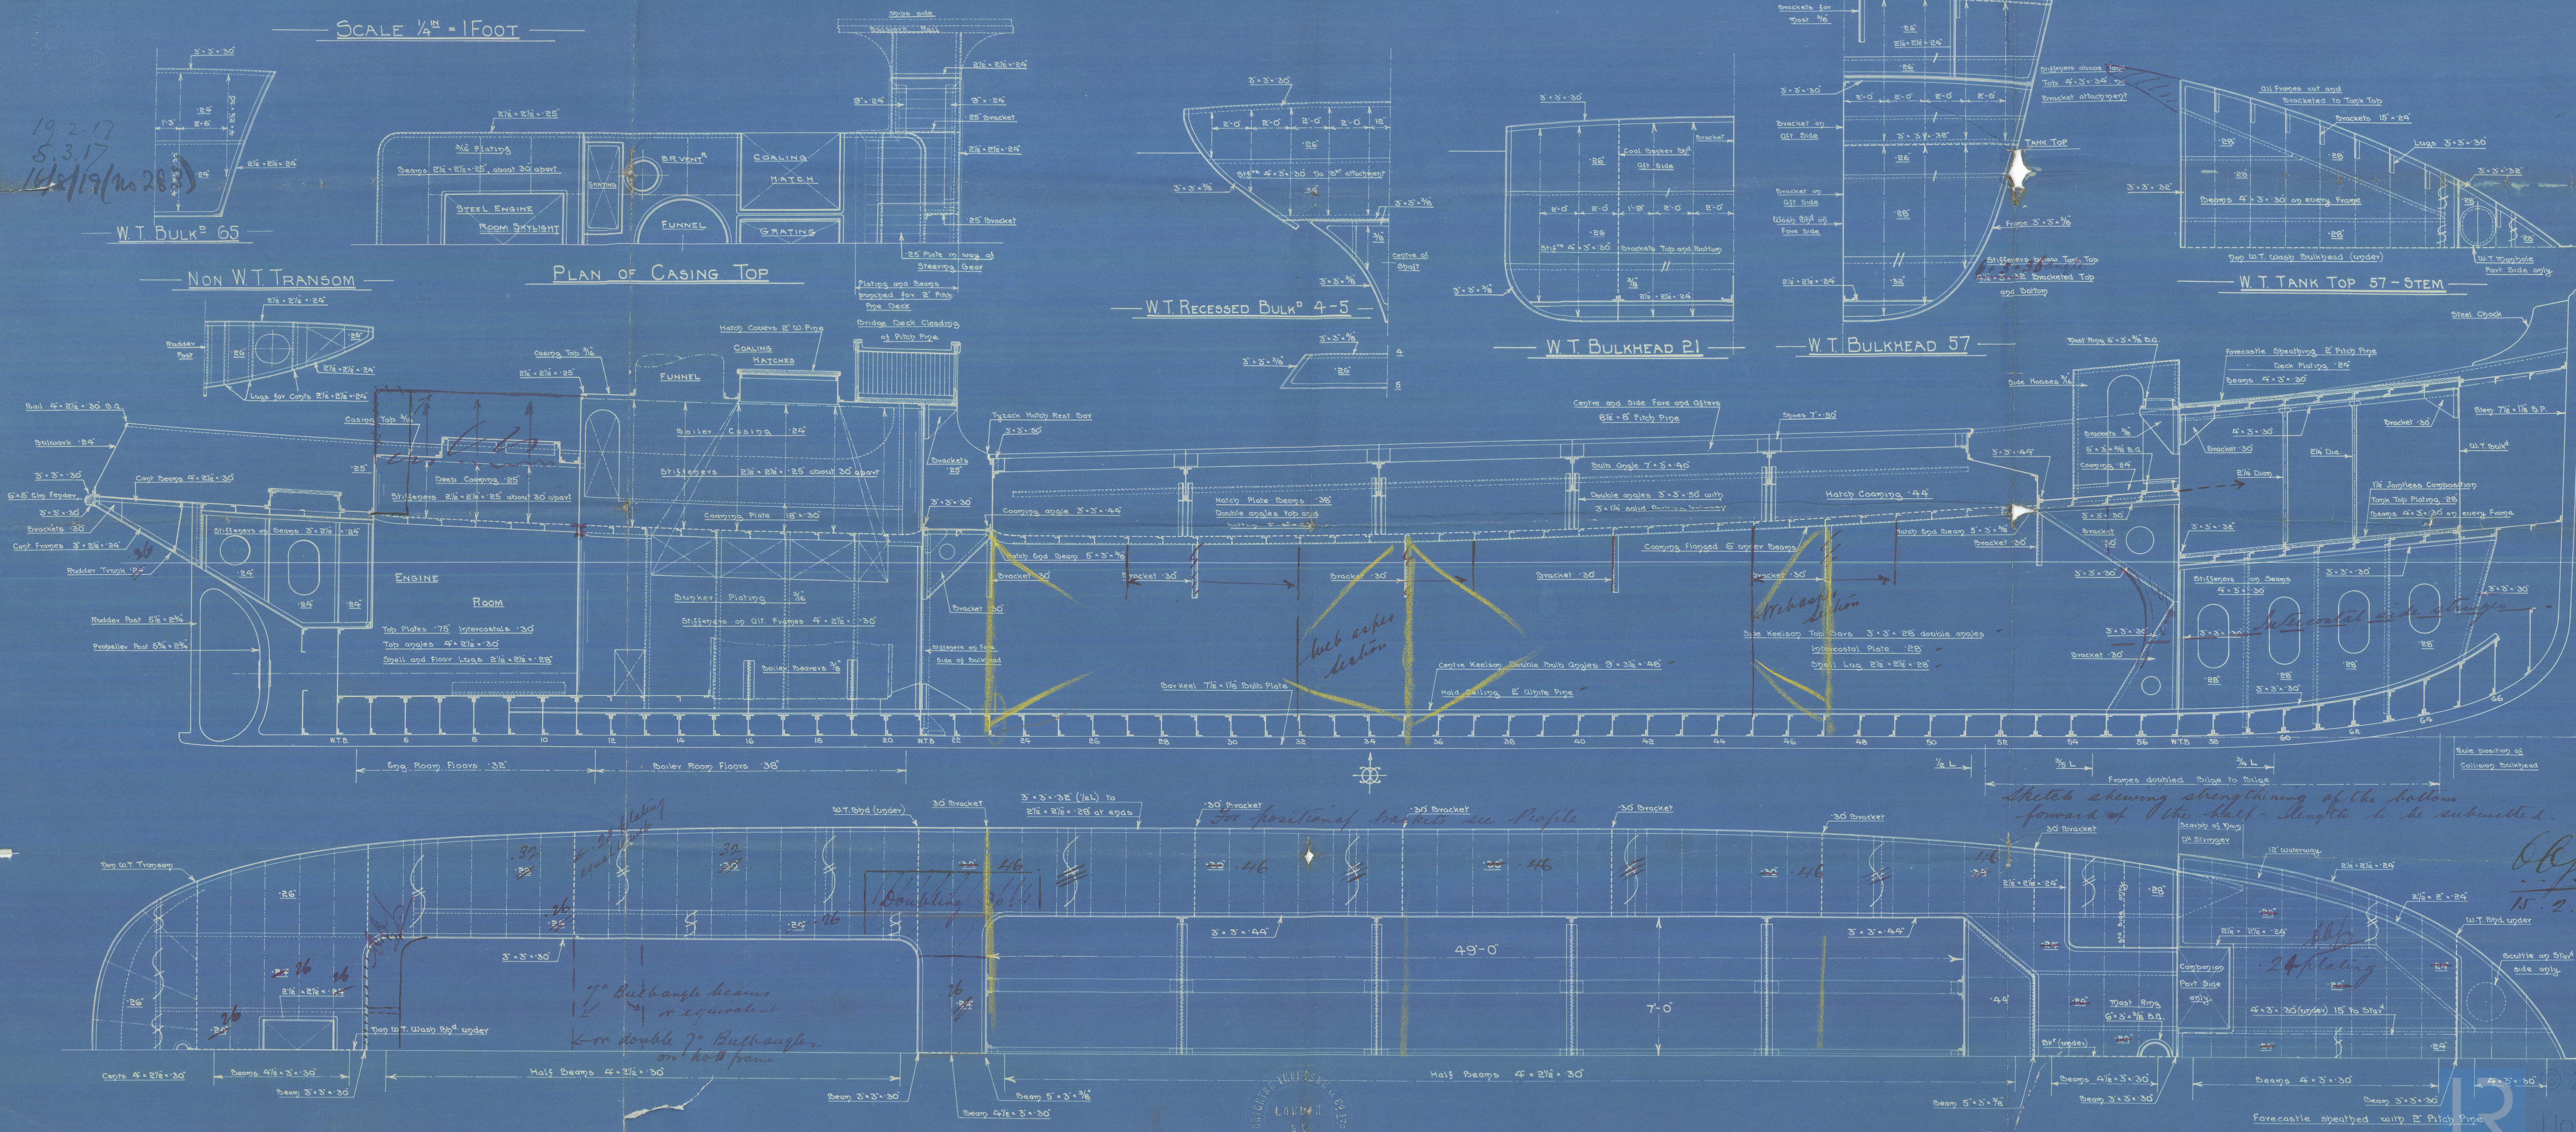

15.2.17.

24/17

2020

Lloyd's Register Foundation

W. Carr. Ltd.

Gross 259 + 283
~~120~~ 120 11-
net

Profile


RECEIVED FROM LLOYDS

19/8/19

s/s Inverlyne

Hull Report to 321 40 (Freeboard)

" " " 32207

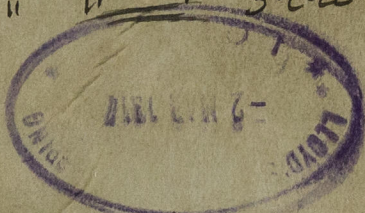

s/s Inverlyne

Hull Rph 7hd. 32277

" " " 32311



© 2020

Lloyd's Register
Foundation

002770-002783-0093