

Lloyd's Register of Shipping.

SURVEYS FOR FREEBOARD.—STEAM SHIPS.

*N.W.C.
6/9/32*

NOTES RELATING TO ALL STEAM SHIPS EITHER FLUSH DECKED, OR WITH
GALLANT FORECASTLES, SHORT POOPS AND BRIDGE HOUSES DISCONNECTED, OR
TOP GALLANT FORECASTLES HAVING LONG POOPS, OR RAISED QUARTER DECKS
CONNECTED WITH BRIDGE HOUSES, OR OTHERWISE.

Port of Survey *Dull.*
Date of Survey *17th September 1920.*
Name of Surveyor *Arthur Sculard.*

Ship's Name	Port of Registry and Nationality	Official Number	Gross Tonnage	Date of Build	Particulars of Classification
<i>S.S. "Inverlyne"</i>	<i>London British</i>	<i>145048</i>	<i>259.48</i>	<i>New Vessel</i>	<i>+ 100 A.1. Carrying oil fuel in bulk Class Contemplated</i>
Number in Register Book					
Registered dimensions from ship's Register.	LENGTH. <i>120.2</i>	BREADTH. <i>23.15</i>	DEPTH. <i>9.3</i>	UNDER DECK TONNAGE. <i>207.25</i>	Moulded Depth as measured..... <i>10'-0"</i>
Length on LOADLINE.	Length <i>120.0</i>	Frame Depth <i>4'</i> Ceiling <i>+ .20"</i> Rule <i>"</i> <i>3'</i> Sheer <i>+ .346"</i>	Peak <i>Inc</i>	Tanks	Addition for Keel below base line for draught record <i>7 1/2</i> inches.
CORRECTED DIMENSIONS.	<i>120.0</i>	<i>23.032</i>	<i>9.846</i>	<i>207.25</i>	
Co-efficient of fineness.....	<i>.76 .751</i>				
Any modification necessary [Para. 4 (a) to (e)]*	<i>v</i>				
Co-efficient as corrected.....	<i>.76 .75</i>	<i>35.23</i> <i>22.00</i>			Table C. (if required.)
Sheer { Stem <i>48.0</i> at Sternpost <i>19.5</i>	<i>67.5 ÷ 2 = 33.75</i>	Mean	<i>36</i> <i>12.49</i>		
			<i>346</i>		
Sheer at $\frac{1}{2}$ of the length from Stem <i>30.75</i> Sternpost <i>8.0</i>	<i>38.75 ÷ 2 = 19.375</i> Mean <i>÷ .55 = 35.227</i>				
Gradual mean Sheer <i>33.75 + 35.227</i>	<i>= 34.49.</i>				
Standard mean Sheer [Table, Para. 18]	<i>22.0</i>	Correction			
Difference.....	<i>12.49 ÷ 4 = 3.12</i>				
§ If limited as Para. 18 (f)			<i>say - 3"</i>		
Rise in Sheer { At front of bridge house.....					
from amidships { At after end of forecastle.....					
[Para. 18 (e)]					
Fall in Sheer { <i>1 1/4" at frame 28</i>					
Para. 18 (d)	<i>1 1/4" ÷ 2 = .625</i>				
Length uncovered			<i>Correction + 1/2"</i>		
ALLOWANCE FOR DECK ERECTIONS :—					
Freeboard, Table C.....			<i>0 - 2 1/2"</i>		
Correction for Length, if required (Para. 12, 13, and 14)			<i>v</i>		
Freeboard by Table A, corrected for sheer, and for length, if required (Para. 12, 13, and 14)			<i>1 - 1 3/4"</i>		
Difference			<i>0 - 11 1/4"</i>		
Percentage as below.....			<i>10.07</i>		
			<i>1.13</i>		
Correction for R. Q. Dk. if engine and boiler openings not covered by bridge house (Para. 11)					
Allowance for Deck Erections			<i>- 1/4"</i>		
<i>5' 4" = 13.166</i> Length.	<i>19.75</i>	Length allowed.	<i>13.166</i>	Height.	<i>4' 0"</i>
Forecastle.....					
Bridge House <i>7.00</i> <i>49 × 14</i> <i>29.82 × 14</i> <i>1/2 × 1/2</i> <i>5.96</i>					
↑ Raised Qr. Dk. <i>28</i>					
Poop.....					
Total <i>49.57</i> <i>4.193</i>	<i>13.166</i> <i>8</i>		<i>.877</i>		
Length of Ship <i>120.0</i>			<i>.159</i>		
Corresponding percentage (Para. 11, 12, 13, or 14) <i>10.07</i>	<i>4.20%</i>				
FREEBOARD recommended amidships from centre of Disc to top of Statutory Deck Line, <u>Wood</u> (Iron) Deck :—					
Fresh Water Line	above centre of Disc	
Indian Summer Line	" "	
Winter Line	below "	
Winter North Atlantic Line	" "	

frames, skin planking, or ceiling are of unusual thickness the breadth of vessel to inside of ceiling should be reported.

The height of the R.Q.D. is to be taken from the level of the top of the amidship beam.

In flush-decked vessels the total standard mean sheer means the sheer measured at the stem and stern-post. In vessels having poops and forecastles, it means the sheer measured at points distant one-eighth of the vessel's length from stem and stern-post.

* State dimensions of freeing port area on back of this form.

The Surveyor should state whether the fall in sheer as reported is measured relatively to the straight line of keel or to the water line. If measured relatively to water line the vessel's draft at time of survey, and also the usual load draft forward and aft should be reported.

24.9.20 *1/2 2020*

Lloyd's Register
Foundation

4 deck

Do all the Frames extend to the top height in the Poop? Yes Raised Quarter Deck? ✓ Bridge House? ✓ Forecastle? ✓

To what height do the Reverse Frames extend? None

Has the Poop or Raised Quarter Deck an efficient Iron Bulkhead at the fore end? ✓

Give particulars of the means for closing the openings in Bulkhead ✓

Is the Poop or Raised Quarter Deck connected with the Bridge House? ✓ Has the Bridge House an efficient Bulkhead at the fore end? ✓

Give particulars of the means for closing the openings in Bulkhead ✓

What is the thickness of the Bridge Front plating? ✓ and Coaming plate? ✓

Give scantlings and spacing of the Stiffeners ✓

Are bracket plates fitted at each end of the Stiffeners? ✓ Are hor'l. brackets fitted connecting Bridge Bulk'd. with Bulwarks? ✓

Has the Bridge House an efficient Iron Bulkhead at the after end? ✓

How are the openings closed? ✓

Is the Forecastle at least as high as the main or top-gallant rail? Yes Has the Forecastle an efficient Iron or Wood Bulk'd. at aft' r end? Yes

Are the Engine and Boiler openings covered by a Bridge, Poop, Raised Quarter Deck, or enclosed by a Strong Iron or Steel Deckhouse? Yes

If the openings are not so protected are the exposed parts of the Casings efficiently constructed? Yes

Give thickness of plating; scantlings and spacing of Stiffeners Coaming .30, plating .24. Stiffeners $2\frac{1}{2} \times 2\frac{1}{2} \times 25$ spaced about 32"

What is the height of the exposed Casings? 6'-6" Are suitable means provided for closing all openings in them in bad weather? Yes

Are the Weather Deck Hatchways efficiently constructed and at least equal to the requirements of Section 28 of the Rules for 1904-5? Give particulars below:— Yes

Position and Size.		Oil Hatches 2'-6" x 2'-6": 2 ft. 1" 2 agt each side								
Item.	Ship.	Rule.	Ship.	Rule.	Ship.	Rule.	Ship.	Rule.	Ship.	Rule.
COAMING. Height above top of DECK		13" above Expansion Trunk								
Thickness { Sides..... Ends.....		3/8"								
SHIFTING BEAMS OR WEB PLATES.		Number								
		Section and Scantlings								
		Material								
* FORE AND AFTERS.		Number								
		Section and Scantlings								
		Material								
HATCHES Thickness		Plate covers								
Remarks.....		3/8" thick								

* The depth of Fore and Afters should be stated from the underside of the hatches in all cases.

(If the sill of the lowest side scuttle will be less than 6 inches above the Indian Summer Load Line if assigned under the tables, state vertical distance from top of deck at side amidships to lower edge of lowest side scuttle.)

The following information is to be given in all Cases of vessels dealt with under Paras. 11, 12 (under 15 feet Moulded depth) and under Shelter Deck Rules.

that is the thickness of the Bridge Sheerstrake? Strake between Main and Bridge Sheerstrakes?

Delete the words { The Crew are, are not, berthed in the bridge house.

that do not apply { The arrangements to enable them to get backwards and forwards from their quarters are, are not satisfactory.

Length of Bulwarks in well



Area of Freeing Ports required by Para. 11 (e) each side of vessel = Sq. ft.

Ft. Tenth. Ft. Tenth. No.

x	x	x	x	Freeing Ports (each side of vessel) =	Sq. ft.
---	---	---	---	--	---------

Total deficiency or excess = Sq. ft.

Lev. 4'-6" x 21". 12" down from Trunk

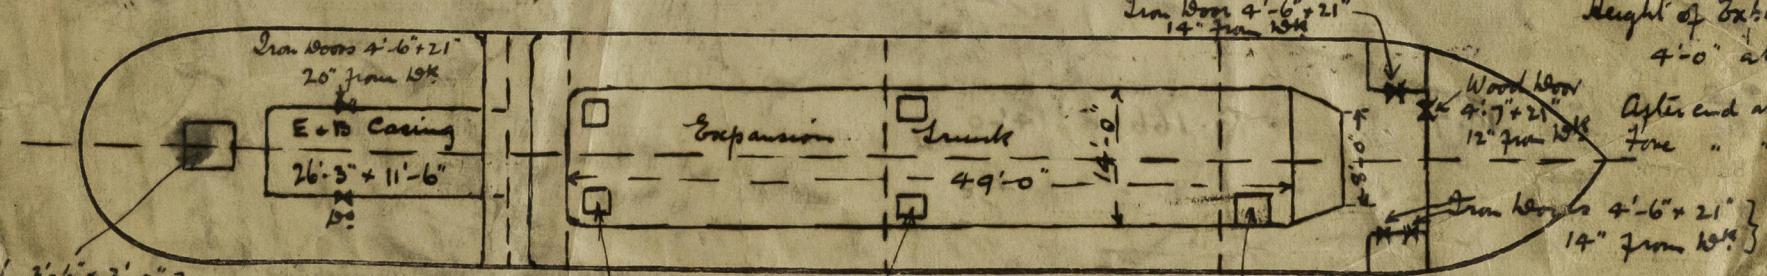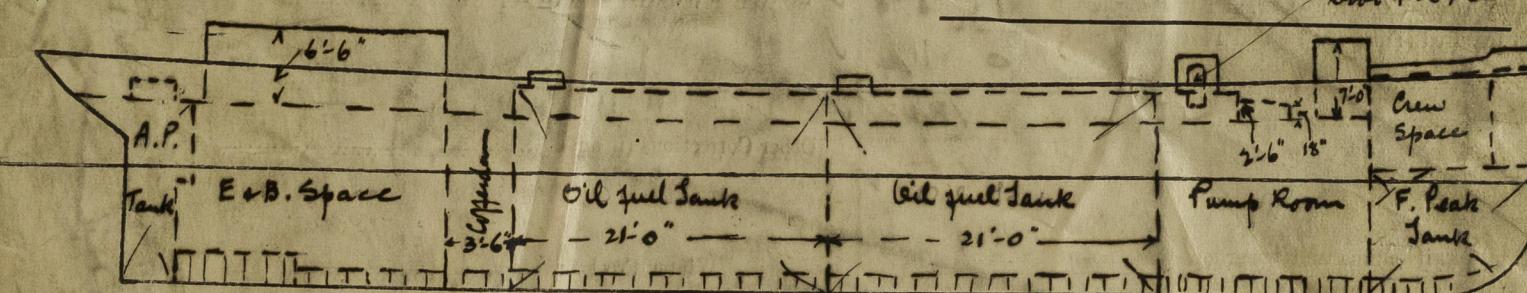

Hatch 3'-6" x 3'-0" 12" from LK
plate covers

Show hereon line of Floors or Tank Top with position of any Breaks in same; also height of Peak Tank tops, &c., &c.

Hatches 2'-6" x 2'-6": 13" from Trunk

Pump Room Entrance 2'-7" x 3'-6" + 4'-0" from

State any special features in the construction of the Vessel This report refers to Messrs. H. Scanl & Co. of Hendle
S.S. Invertryne No 259. The approved plans of which are forwarded for reference

Owners British Mexican Petroleum Co.

" Address 21 Bury St. London E.C. 3.

Fee £ 1 : 1 : 0

Received by me

2020

Lloyd's Register Foundation