


Lloyd's Register of Shipping.
SURVEYS FOR FREEBOARD.
(CONDITIONS OF ASSIGNMENT.)

Ship's Name S.S. "U. S. S. R Victory" Port of Survey Los Angeles Harbour.
Official Number 245257 174182 Surveyor's Signatures A. Nislop & E. J. Boomer.
Nationality and Port of Registry British - Calcutta. Date of Survey 10th April. 1947.

Disposition and dimensions of superstructures, trunks, deckhouses and machinery casings to be inserted in the diagrams and tabular statement : --

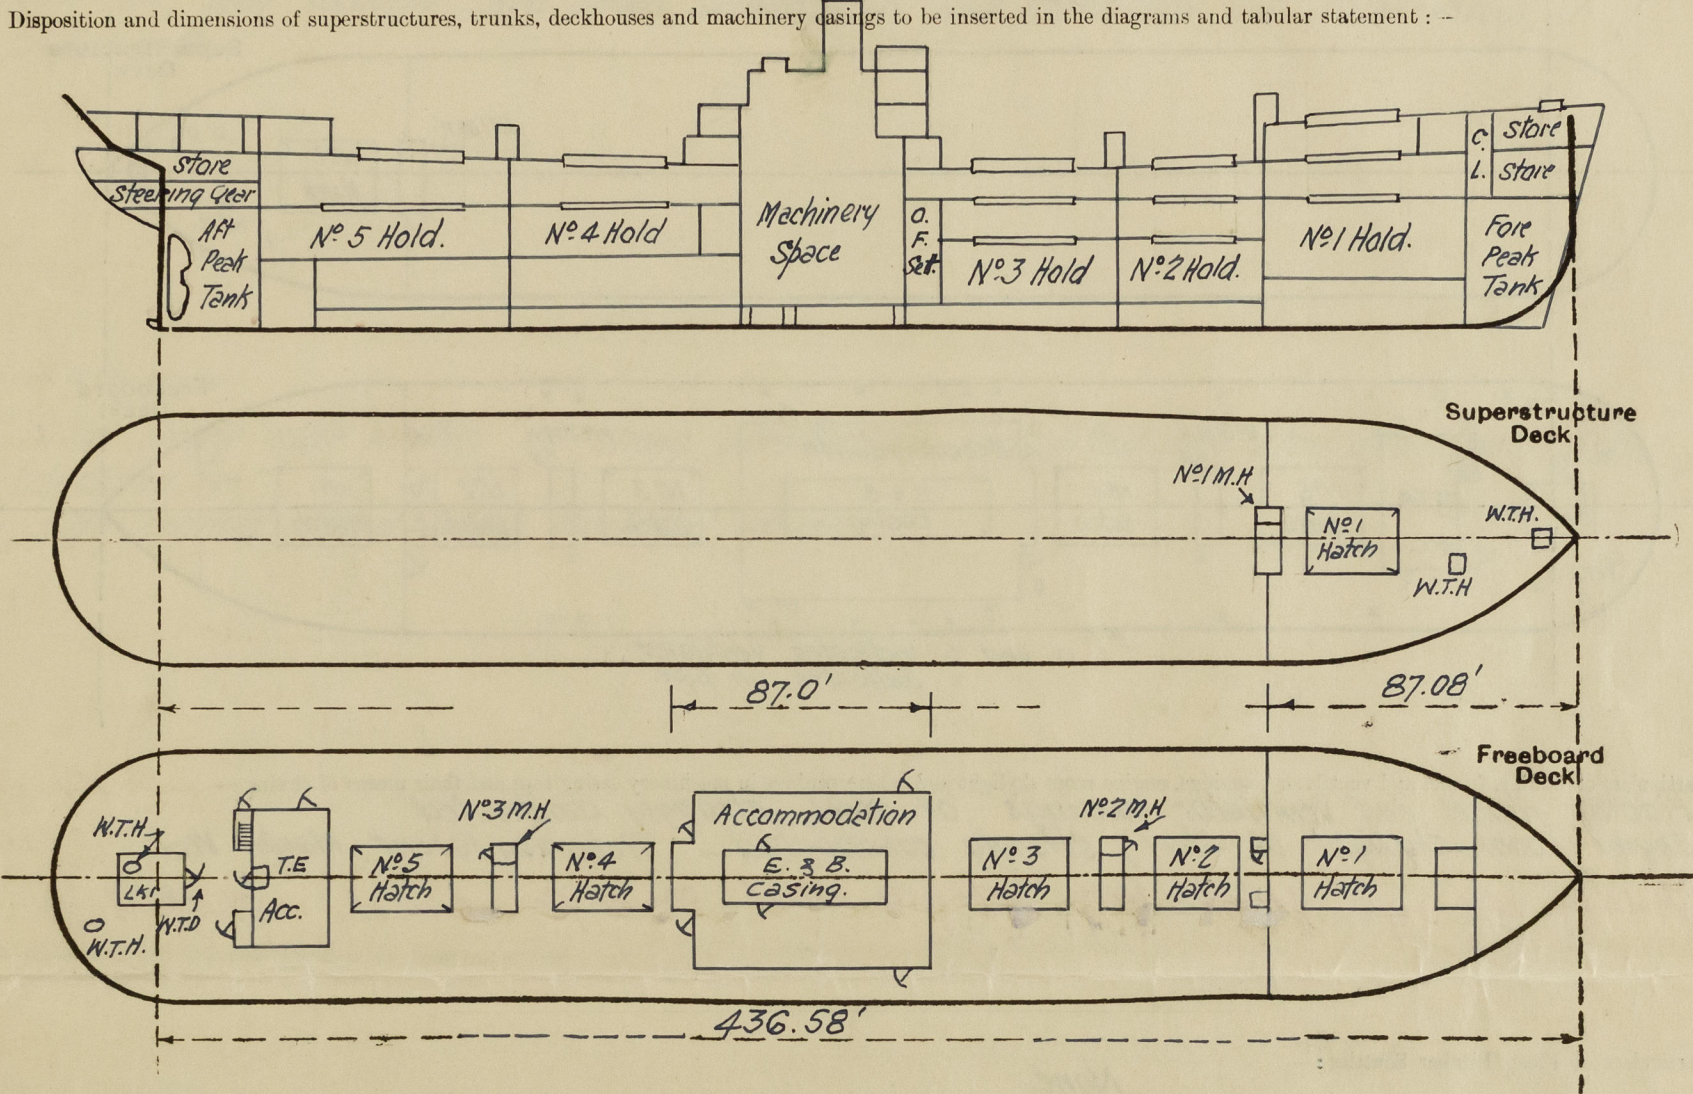

Particulars of Superstructures, Trunks, Casings, Deckhouses.								
	Coaming	Plating	Stiffeners	Spacing	End Attachments of Stiffeners	Size of Openings	Height of Sills	Height of Casings
Poop Bulkhead								
Raised Quarter Deck Bulkhead ...								
Bridge, After Bulkhead								
Bridge, Forward Bulkhead								
Forecastle Bulkhead	38"	38"	4"x3"x31" inverted angle	36"	-	-	-	9.0' ✓
Trunk, Aft								
Trunk, Forward								
Exposed Machinery Casings on Freeboard or Raised Quarter Decks ...								
Exposed Machinery Casings on Superstructure Decks								
Machinery Casings within Superstructures not fitted with Class I Closing Appliances								
Deckhouses on Flush Deck Ships ...								
Particulars of Closing Appliances (state if capable of being manipulated from both sides).								
Poop Bulkhead								
Raised Quarter Deck Bulkhead ...								
Bridge, After Bulkhead								
Bridge, Forward Bulkhead								
Forecastle Bulkhead	- NO OPENINGS.							
Exposed Machinery Casings on Freeboard or Raised Quarter Decks ...								
Exposed Machinery Casings on Superstructure Decks								
Machinery Casings within Superstructures not fitted with Class I Closing Appliances								
Deckhouses on Flush Deck Ships ...	Hinged steel W.T. doors, capable of being manipulated from both sides.							

0313 213

PARTICULARS OF PROTECTION TO OPENINGS, ETC.

HATCHWAYS ON FREEBOARD AND SUPERSTRUCTURE DECKS									
On Freeboard Deck					On Forecastle Deck				
Description of Hatchway	Nº2 Cargo	Nº3 Cargo	Nº4 Cargo	Nº5 Cargo	W.T.H. to Stores	Nº1 Cargo	W.T.H. to Stores	W.T.H. to Basins Store.	
Dimensions of Hatchway	22'4" x 24'	22'4" x 36'	22'4" x 36'	22'4" x 24'	24" x 16"	22'4" x 25'	37' x 37"	37' x 37"	
COAMINGS	Height above Deck	40"			18"		18"		
	Thickness	44			38"		38"		
	Sides				None		None		
	Ends				None		None		
HATCH BEAMS	Stiffeners	10" x 3 1/2" x 32.3 lb B.A.			None		None		
	Brackets, Stays	6" x 4" x 12 lbs O.A.			None		None		
	Number	7			5				
	Spacing	63"			72"				
FORE AND AFTERS	Scantling and Sketch								
	Bearing Surface	None			None		None		
	Number	None			None		None		
	Spacing	None			None		None		
HATCH COVERS	Material	Steel Pontoon Type			Steel		Steel		
	Thickness	see detail.			38"		38"		
	How fitted	3"			Hinged Rubber		Hinged Rubber		
	Bearing Surface	3"			4 dogs		4 dogs		
Spacing of Cleats	24"			24"					
Number of Tarpaulins	2			2					

*Are wood fore and afters steel shod at all bearing surfaces? Yes


Are battens and wedges efficient and in good condition? Yes

Are tarpaulins in good condition and in accordance with rule requirements? Yes

Are lashings provided in accordance with rule requirements? Yes.

Particulars of any special features:—

Pontoon Type Hatch cover.

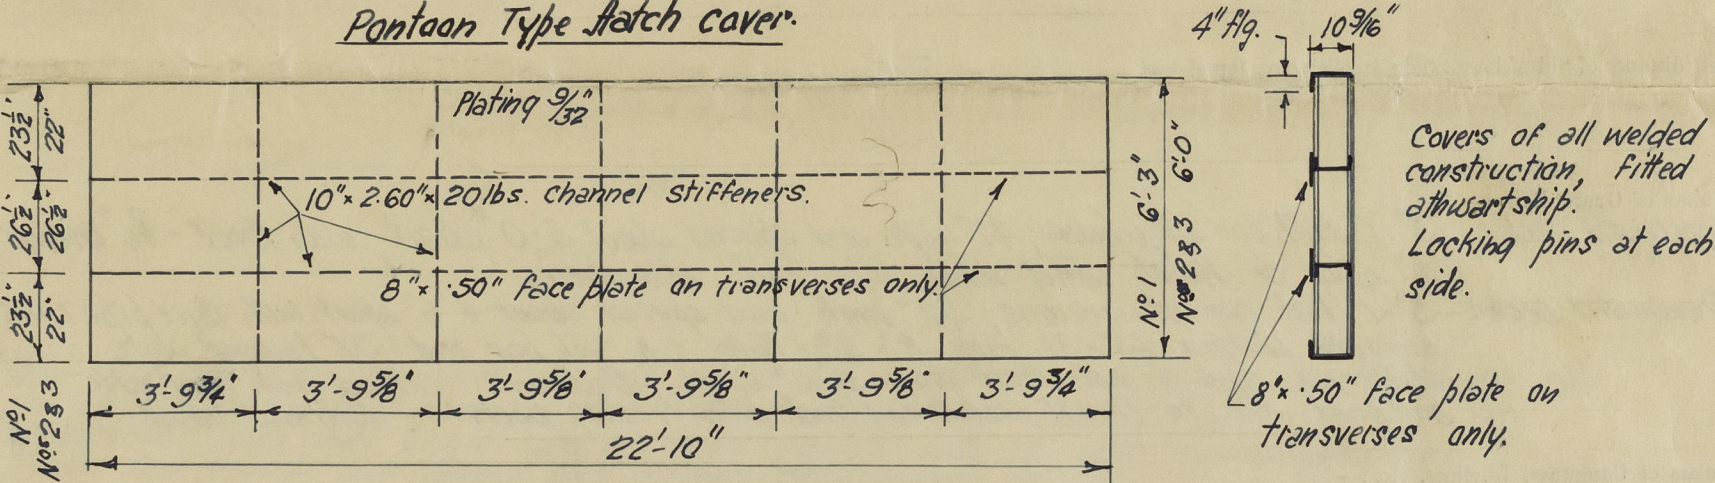

Endorsement at first survey and at surveys for renewal of Certificate:—

The fittings and appliances are in accordance with the particulars shown on this form (or as now modified) and are in good condition.



© 2020
Lloyd's Register
Foundation