

Midship Section No 244.

CLASS 100 A. I. LLOYDS.
Length B.P. 300-0 Breadth mld 45-9 Depth mld 20-3
Scale 1" = 18ft.

NOTE - Intermediate frames may be dispensed with in Bridge.
The main frames to extend to the bridge deck for four frame spaces at each end of the Bridge.
NOTE - Int. frames to be fitted but need not be connected at lower end.
NOTE - Int. frames to be fitted and to be accepted to main frames below brackets to upper deck.

Equipment Numerals

300 (45.75 + 20.25)	= 19800.00
Body 18.66 x 7.75	= 97.96
Bridge 52 x 7.75	= 273.00
Fale 23.35 x 7.75	= 122.48
Roof 106 x 5	= 530.00
Covering 52 x 7.75	= 182.00
Equipment No	= 21005.44 - (outfit increased ops grade above Rules)

Outfit. One Grade above Rules

3 Stockless Bower Anchors	42 1/2 cwt each 128 cwt coll
1 Ordinary Stream	12 - 6x Stock
1 " Kedge	5 1/2 - " "
270 Fathoms Stud Chain Cable	1 1/2" diam
10 " Stream Wire	4 1/2 steel wire
100 " Towline	4 - " "
2 at 90 " Hawser	2 1/2 - " "
" " Warp	2 1/4 - " "


Bridge Deck

M.O.U.T.

Bridge Sheer	58
Butts Treble Riv	58
Fale Sides	58
Roof	58

K out

Sheerstrake in Well

45 x 82 for 1/2 L to 42	54
Bridge to 1/2 L	54
Butts Treble to Treble	54

J. 112

- 60 - 62 to 42 at ends
- + 04 in lieu of Side Stringers
- = 46 to 46 - 42 in Reels
- Reduced in Way of Bridge to 54 + 04 = 58
- Overlap Butts Treble to double
- To Treble at ends

H. out

- 60 - 54 for 1/2 L to 42 at ends
- + 04 in lieu of Side Stringers
- = 58 to 46 - 42 in Reels
- Overlap Butts Treble to double

G. 112

- 60 - 54 for 1/2 L to 42 at ends
- + 04 in lieu of Side Stringers
- = 58 to 46 - 42 in Reels
- Overlap Butts Treble to double

F. out

- 48 1/2 - 54 for 1/2 L to 42 at ends
- Overlap Butts Treble to double

E. 112

- 51 1/2 - 54 for 1/2 L to 42 at ends
- Overlap Butts Treble to double

D. out

- 68 - 50 for 1/2 L to 42 at ends
- 50 for 1/2 L to 42 at ends
- 50 for 1/2 L to 42 at ends

C. in

- 68 - 50 for 1/2 L to 42 at ends
- 42 at ends
- 50 for 1/2 L to 42 at ends

B. out

- 68 - 54 for 1/2 L to 42 at ends
- 54 for 1/2 L to 42 at ends
- 54 for 1/2 L to 42 at ends

Numerals

B	= 45.75
D	= 20.25
L	= 66.00
L	= 200
	= 19800 - Long 170
Dentils to Length	= 14.81
Warp Die	= 11.88
R. O. Dk	

- Tank Top 36 for 1/2 L to 22 at ends
- + 08 under hatches in lieu of Ceiling
- = 44 to 40 Overlap Butts
- double to single

TUNNEL

- 2 G. 1/2
- 3-0 Start

W. out

- 3 - 3 - 24
- 3 - 3 - 24
- 3 - 3 - 24

Flat Keel

- 44 - 54 for 1/2 L to 42 at ends
- 54 for 1/2 L to 42 at ends
- 54 for 1/2 L to 42 at ends

- Single Butts Treble to double
- Quad Riv 1/2 L to Treble
- Seam 1 to 1/2

Raised Quarter Deck

- Sheerstrake 44 - 64 for 1/2 L to 42 at ends
- Increased to 74 from 3/4 L aft
- to Breake - 84 at breake
- Overlap Butts Treble to double
- To Treble at ends

K. out

- 60 - 54 for 1/2 L to 42 at ends
- + 04 in lieu of Side Str - 58 to 46
- 42 in Reels Overlap Butts Treble

J. 112

- 60 - 54 for 1/2 L to 42 at ends
- + 04 in lieu of Side Str - 58 to 46
- 42 in Reels Overlap Butts Treble to double

H. out

- 60 - 54 for 1/2 L to 42 at ends
- Overlap Butts Treble to double

G. 112

- 60 - 54 for 1/2 L to 42 at ends
- Overlap Butts Treble to double

F. out

- 48 1/2 - 54 for 1/2 L to 42 at ends
- Butts Treble to double

E. 112

- 51 1/2 - 54 for 1/2 L to 42 at ends
- Overlap Butts Treble to double

D. out

- 68 - 54 for 1/2 L to 42 at ends
- 54 for 1/2 L to 42 at ends
- 54 for 1/2 L to 42 at ends

C. in

- 68 - 50 for 1/2 L to 42 at ends
- 42 at ends
- 50 for 1/2 L to 42 at ends

B. out

- 68 - 54 for 1/2 L to 42 at ends
- 54 for 1/2 L to 42 at ends
- 54 for 1/2 L to 42 at ends

SUNDERLAND

Messrs OSBOURNE, GRAHAM & CO. L^d

MIDSHIP SECTION

No. 244

S.S. - S.N.A.B


N.N. "CIMBRIA"

SUNDERLAND RPT. No. 28212




258

Cyber. Rpt. No. 12409
6/5 4/5

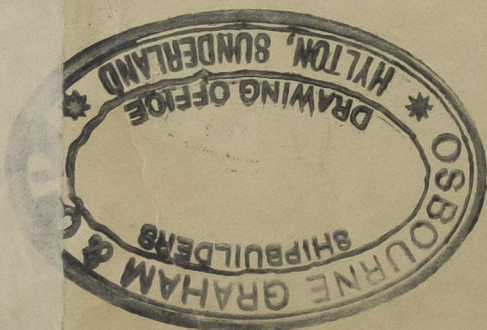

002790-002797-0194

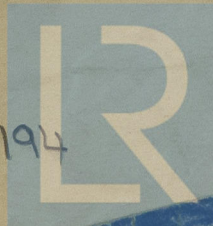

© 2020

Lloyd's Register
Foundation