


ЧЕРТЕЖ №16818.


ОДНОВИНТОВОЙ РЕФРЕЖИРАТОРНЫЙ ТЕПЛОХОД ГРУЗОПОДЪЕМН. В 2500 МТ.  
ДЛЯ ПЕРЕВОЗКИ ПАССАЖИРОВ И СКОРОПОРТЯЩИХСЯ ГРУЗОВ.

ПУТИЛОВСКАЯ БЕРФЬ  
О-ВА ПУТИЛОВСКИХ ЗАВОДОВЪ

—1:100—

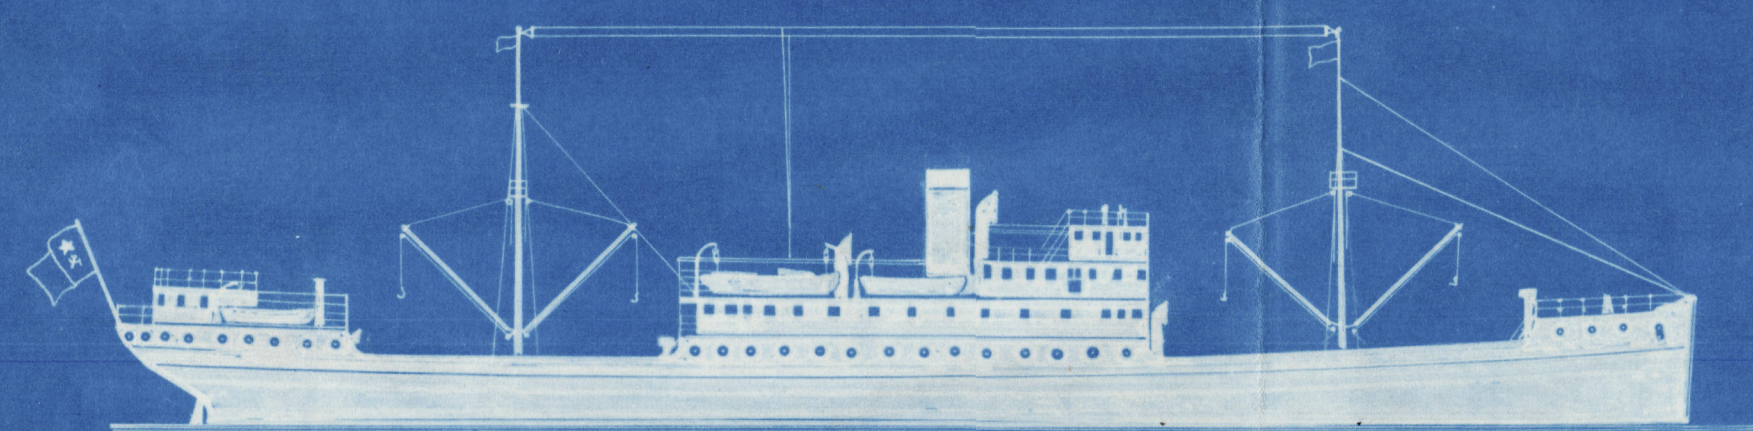

Продольный разрез.

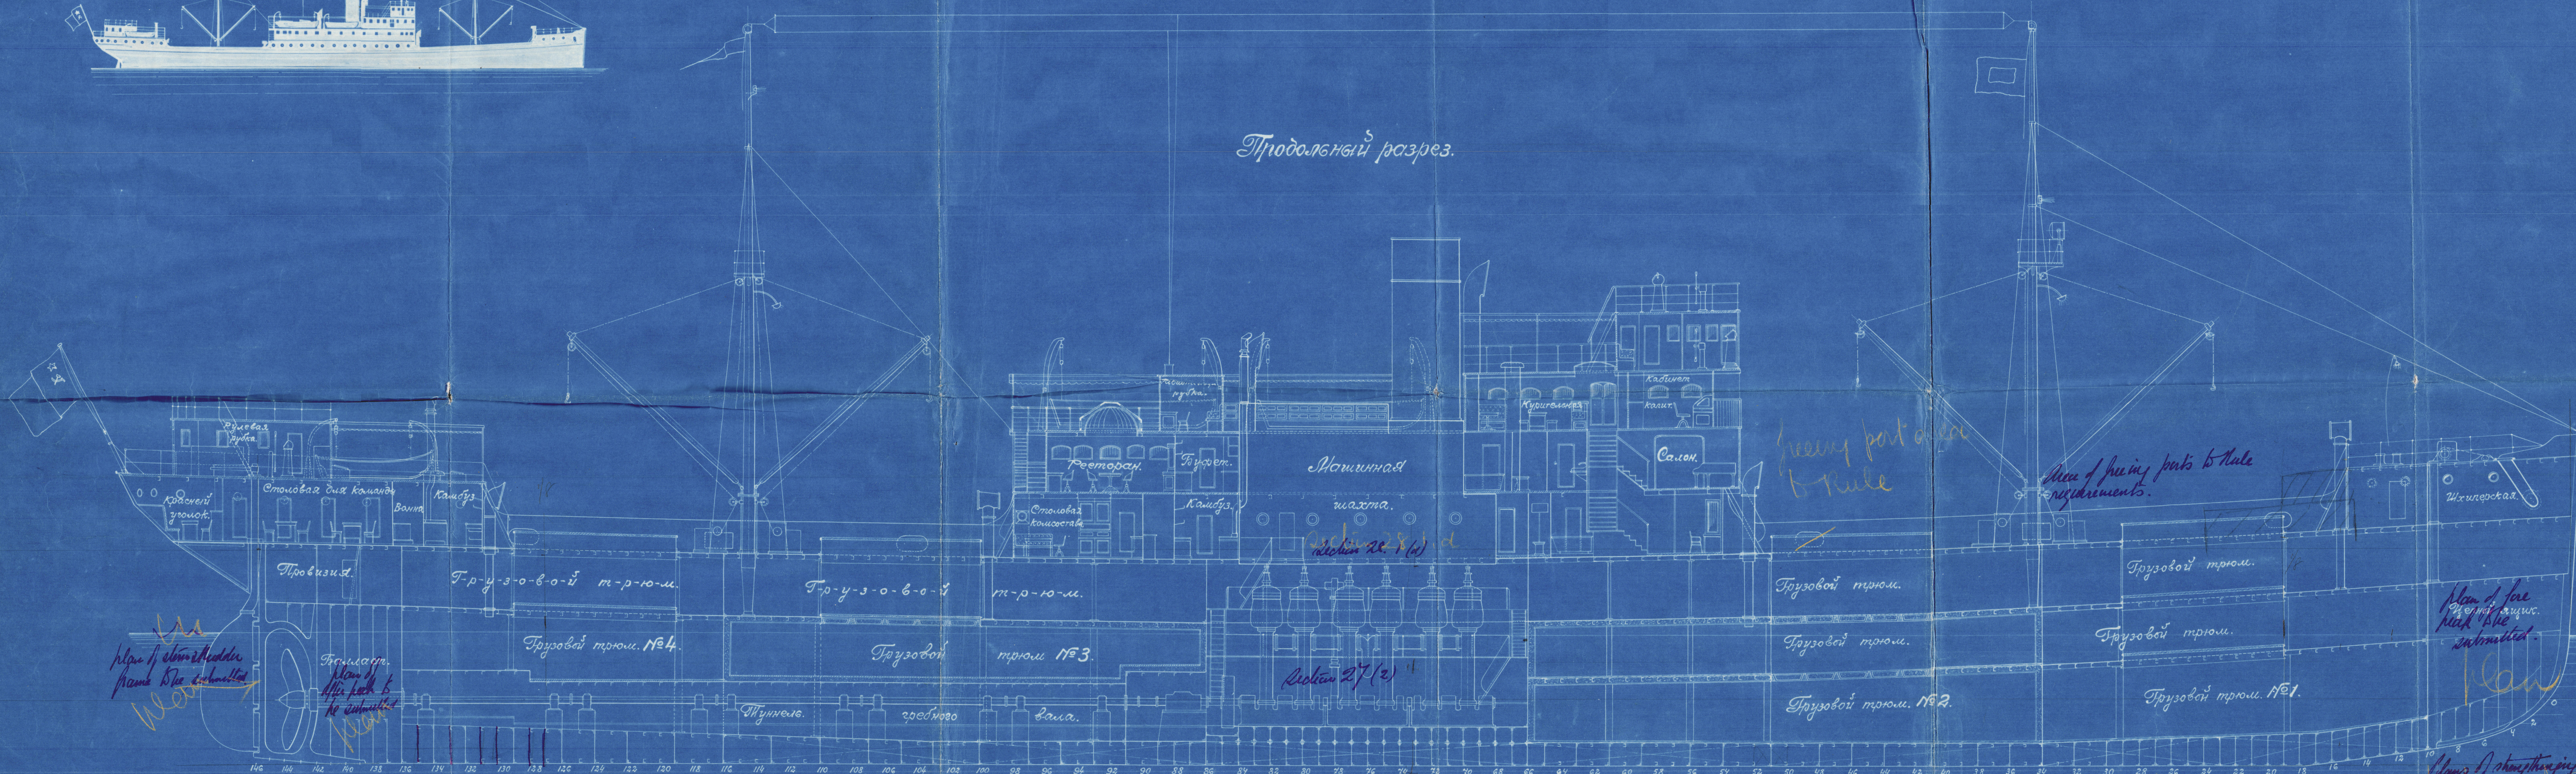

Plan of stern structure  
frame to be submitted  
W.C.

Plan of  
stern to  
be submitted  
W.C.

Making profile plan to be  
submitted.

Plan of  
stern to be  
submitted

Rule, requirements regarding the carriage  
of oil fuel to be complied with.

Plan of engine room to be  
submitted

Plan of bulkheads to be submitted.  
Bulkheads to be submitted.  
Экспертный  
Содержатель: W.C.

Rules regarding carriage of oil fuel to  
be complied with

Plan of fuel ports to be  
submitted

Plan of fuel ports to be  
submitted

Plan of fore  
peak to be  
submitted


Plans of strengthening in double bottom  
forward, framing, and ice strengthening  
arrangements to be submitted.

ice strengthening to be  
submitted

Начальник Мех. К-ры по Судостроению  
Корабельный Инженер: W.C.

W.C.  
9.4.25



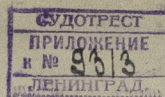

Office copy

Propels Pootilovskie Trakts  
Baltic SBshech. Wark. Leningrad

322 x 47 x 28.

Refrigerating motorship

for Box 586.

S.S. ALEXEY RYKOFF  
LEN. 22.

002816 - 002824 - 0019



© 2021

Lloyd's Register  
Foundation