

DETAIL OF COUPLING  
2 1/2" x 8"  
SCALE 1 1/2" = 1 FOOT.

N<sup>o</sup> 158-9 SHIPS ALSO 165 SHIP.

RUDDER PLAN.

— SCALE  $\frac{1}{2}'' = 1$  FOOT. —

FULL SIZE DETAIL OF STOPPER.

QUADRANT TILLER.


SECTION SHEWING MAINPIECE  
INCREASED IN WAY OF ARMS.

Hand kept  
files - 168

JAN. 17<sup>TH</sup> 1918



IKLA

RUDDER &  
QUADRANT TILLER

MESSRS CROWNS 165  
WHITWOOD

SUNDERLAND RPT. No. 27495




168

DEERWOOD

SUNDERLAND RPT. No. 27641

002816 - 002824 - 0259

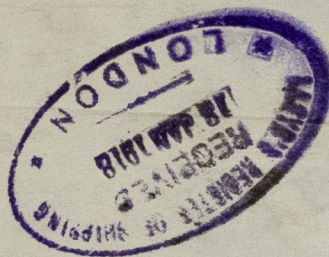

© 2021

Lloyd's Register  
Foundation