

No. 1099

~ MIDSHIP SECTION. ~

STEEL SCREW TRAWLERS.

~ Lord Beaverbrook ~

DIMNS: 150'-0" B.P. x 25'-6" EXT. x 14'-0" MLD.

1/2" SCALE.

TO CLASS + 100.A. STEAM TRAWLERS.

EQUIPMENT.


1ST BOWER ANCHOR 8 3/4 CWT'S STOCKLESS.
2ND " " 8 3/4 " "
KEDGE " 3 1/2 " EX STOCK.
120 FATHOMS 13/16" STUD LINK CABLE.
60 " 6" HAWSER.
60 " 5 1/2" WARP.

NUMERALS.

L x D ----- 2100.
L x (B + D) ----- 5906.

RIVETING.

ALL LANDING EDGES TO BE DOUBLE RIVETED.
EXCEPT TOP EDGE OF SHEERSTRAKE, WHICH
SHALL BE SINGLE RIVETED.
BUTTS OF SHEERSTRAKE STRAPPED AND
TREBLE RIVETED FOR 1/2 LENGTH.
BUTTS OF E AND F STRAKES OVERLAPPED
AND TREBLE RIVETED FOR 1/2 LENGTH.
REMAINDER TO BE DOUBLE RIVETED.

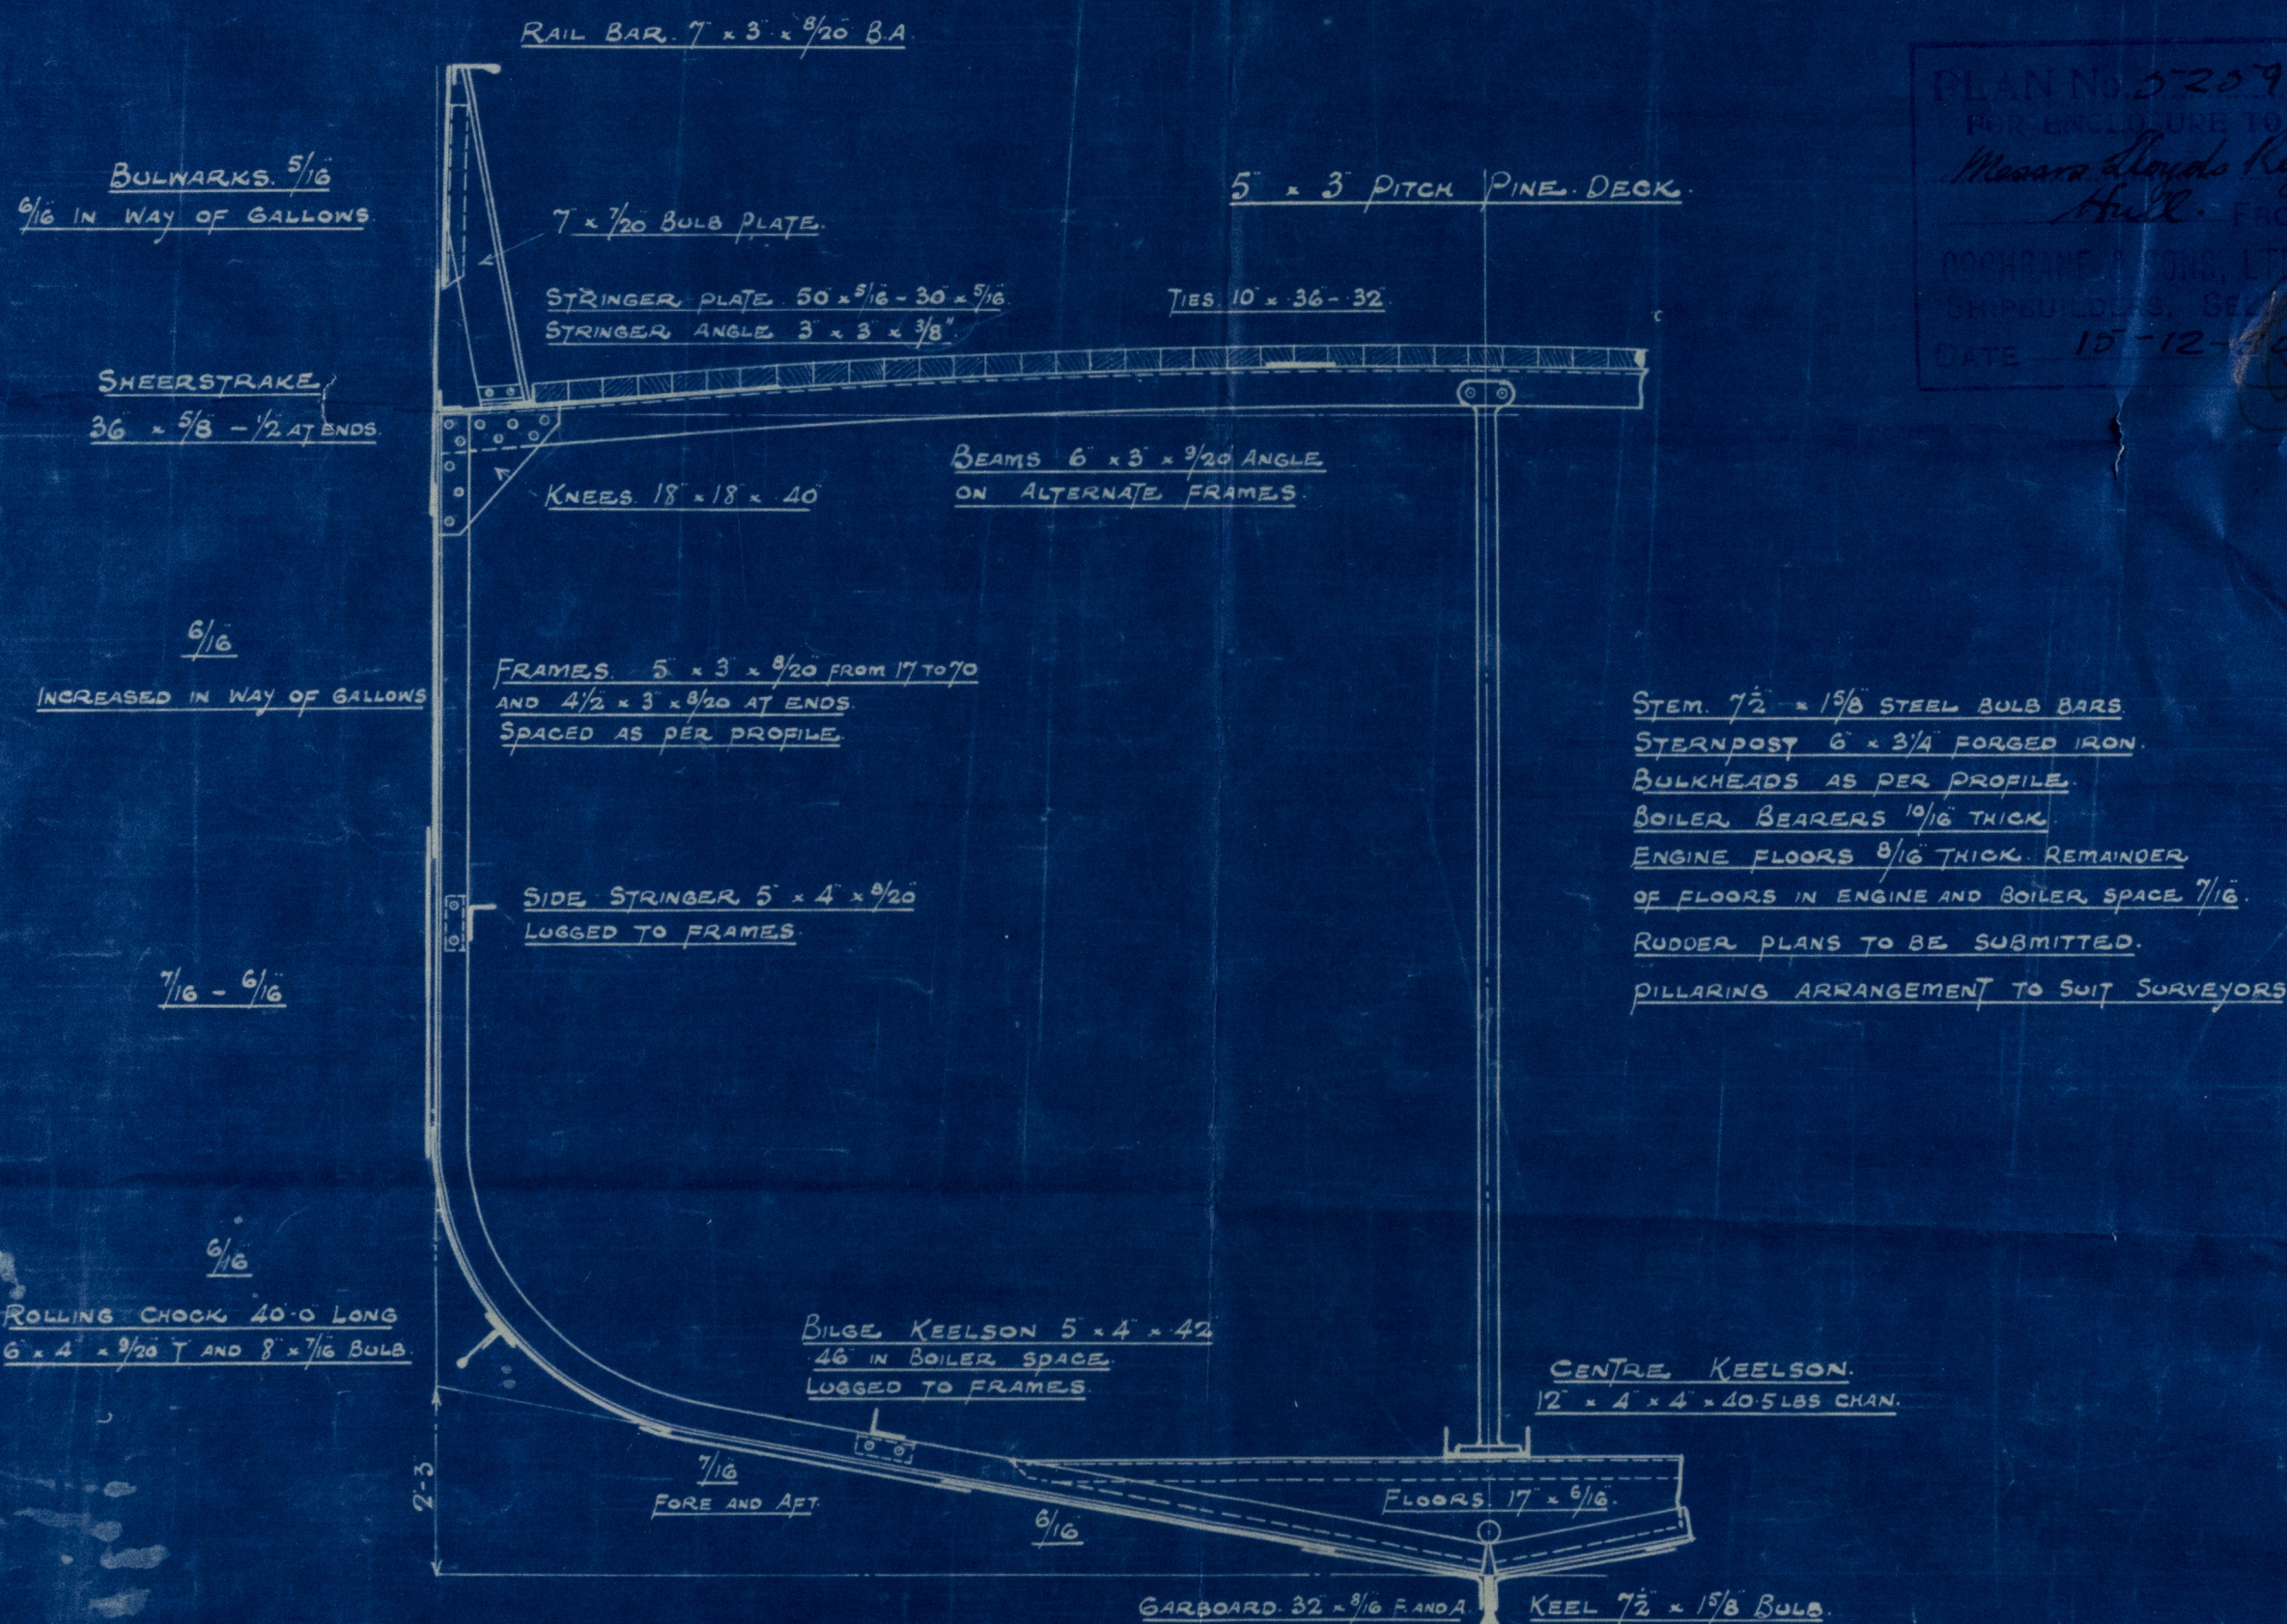

PLAN No. 57207

FOR ENCLOSURE TO

Messrs. Lloyd's Register of Shipping




DATE 15-12-1910.



© 2020

Lloyd's Register Foundation

002838-002845-0138

No. 1099

Midship Section (as built)

Cochran & Sons Ld.

S.S. "Lord Beaverbrook"

HULL REPORT No. 41516



© 2020

Lloyd's Register
Foundation

002838-002845-0133