

SHIP No 404 MIDSHIP SECTION.

To CLASS 100 A.I. WITH FREEBOARD CORRESPONDING TO A.F.S. VESSEL WITH 63' SUPERSTRUCTURES

DIMENSIONS: LENGTH B.P. 265'0" BREADTH M.L. 43'0" DEPTH M.L. TO UPPER DECK 19'6"

SCALE: 1/2" = 1'0"

LLOYD'S NUMERALS

L	265'0"
B	43'0"
D	19'6"
L+D	51'6"
Lx(B+D)	16562
LD	13'59"
d in HOLD	16'60"
d in E.R.	13'5"

NUMERALS FOR EQUIPMENT




ITEM			
HULL	Lx(B+D)	265'0" x 51'6"	16562

EQUIPMENT (LETTER P)





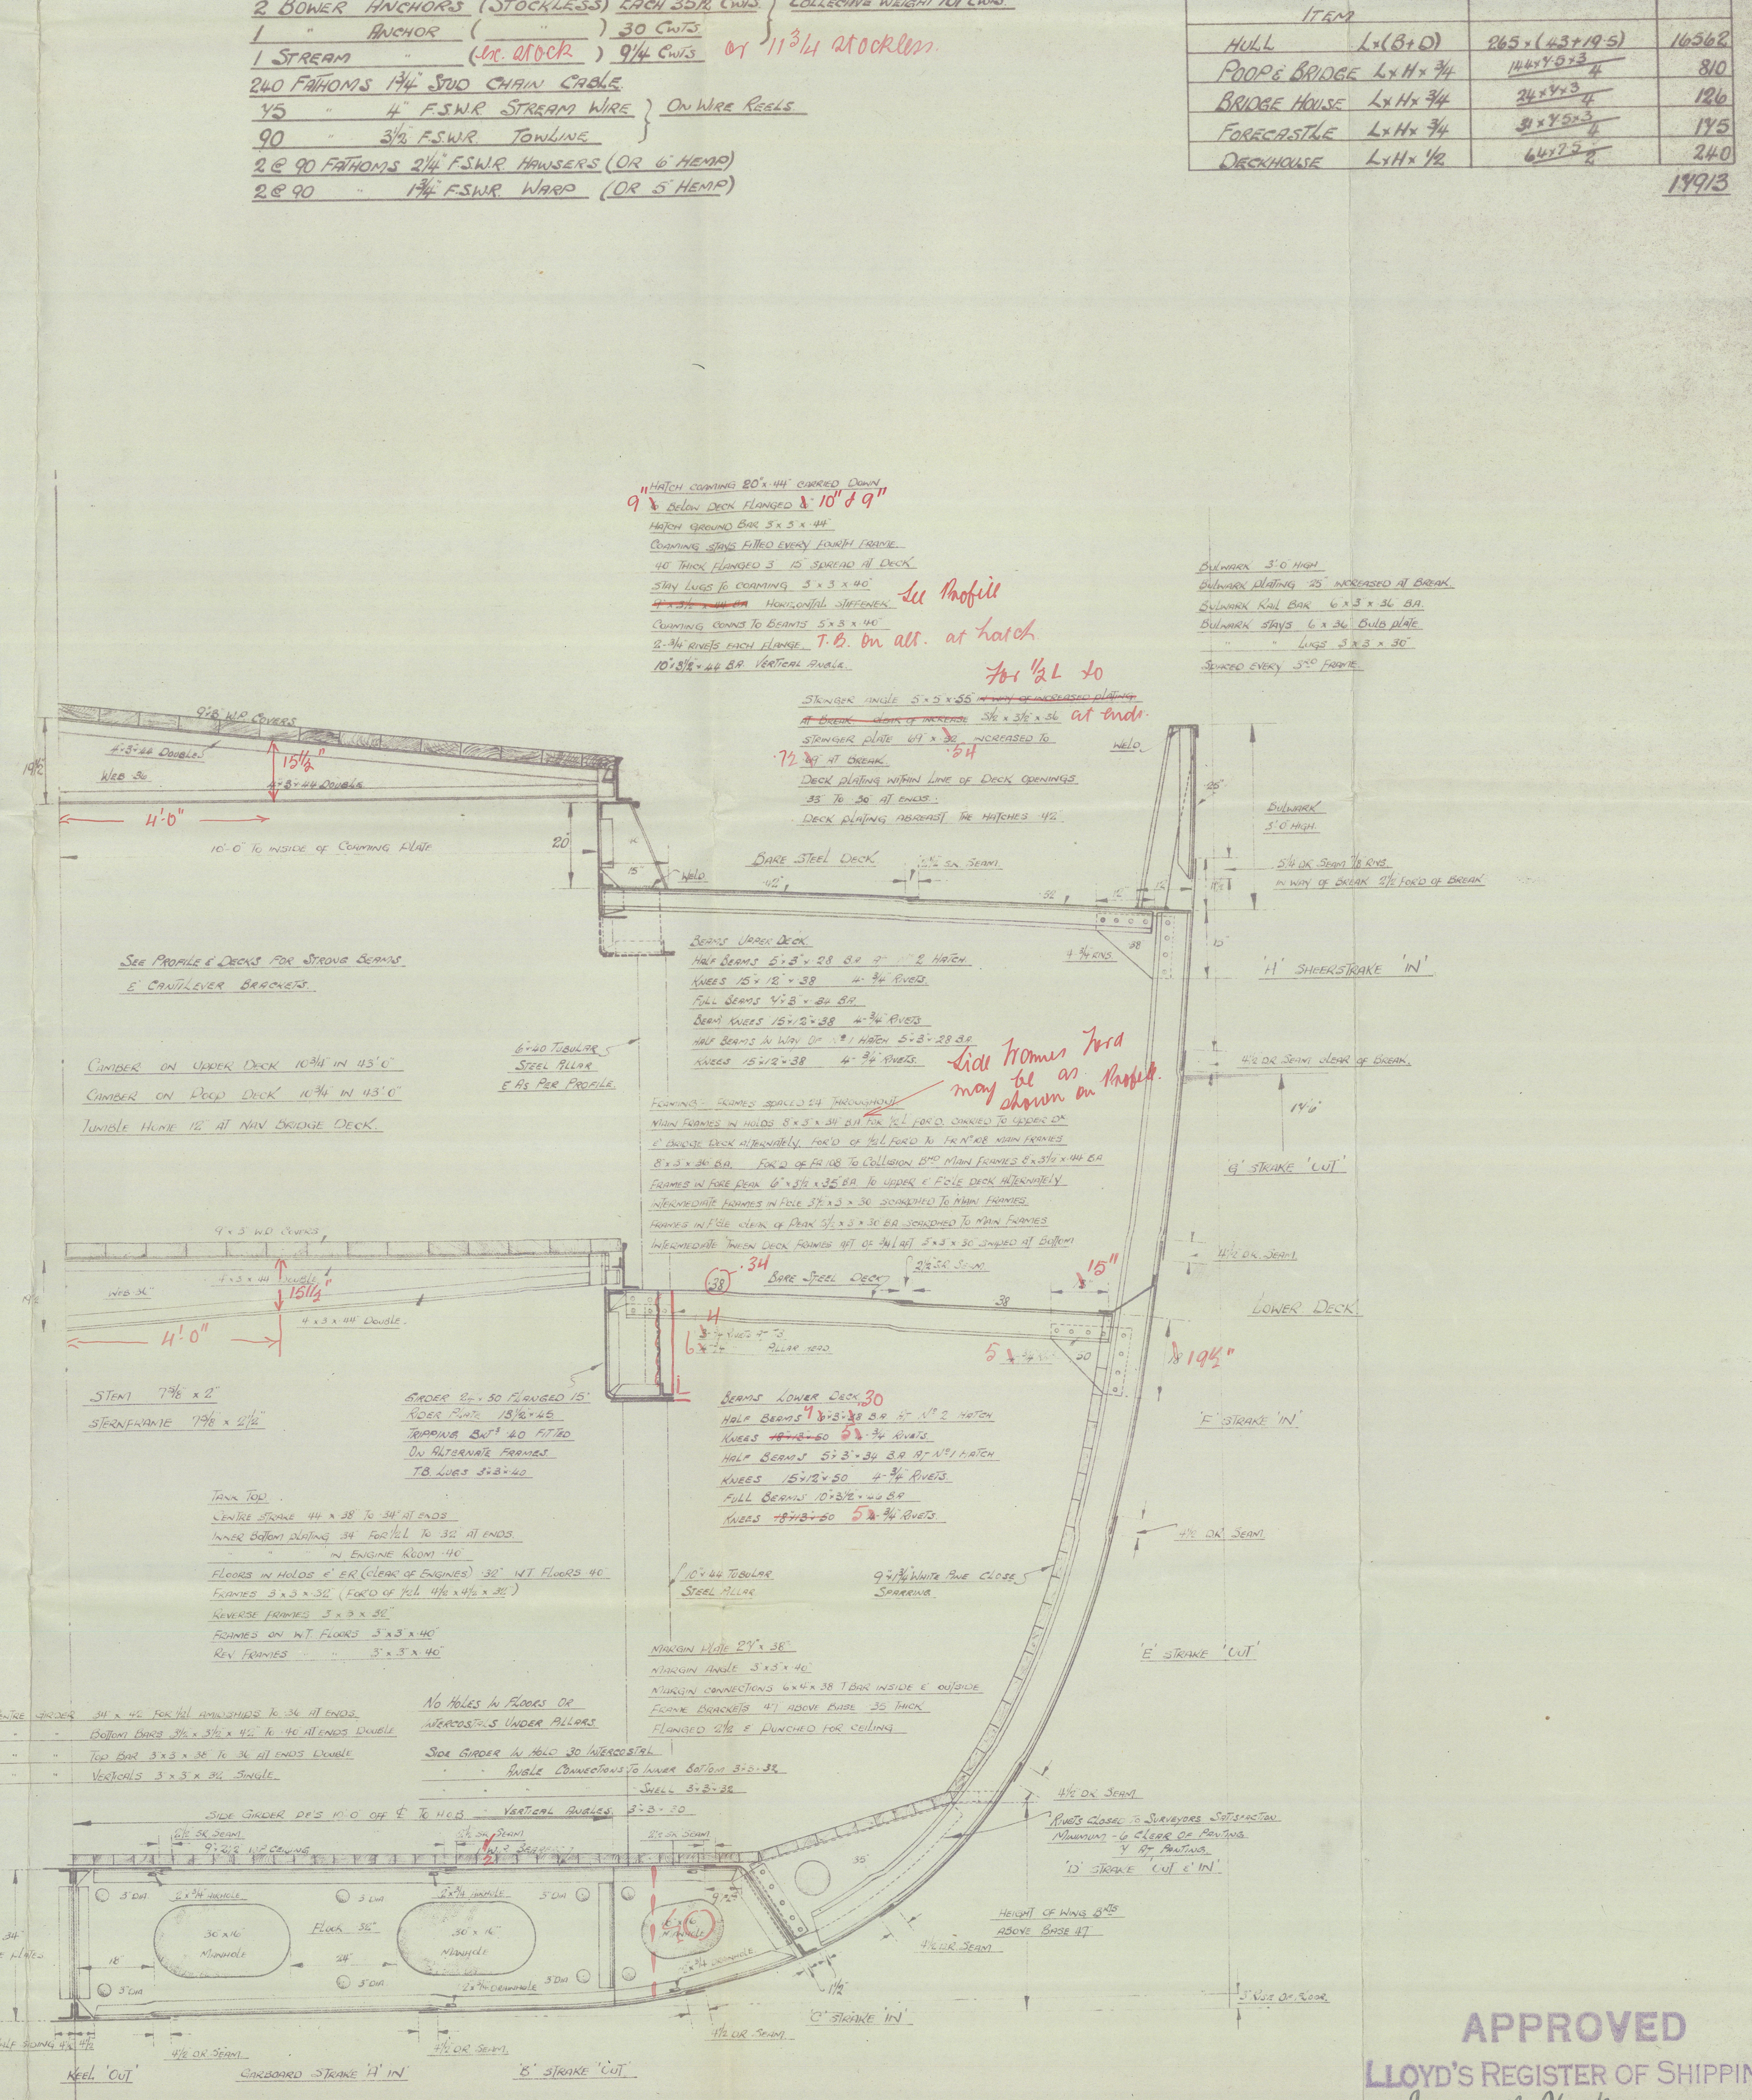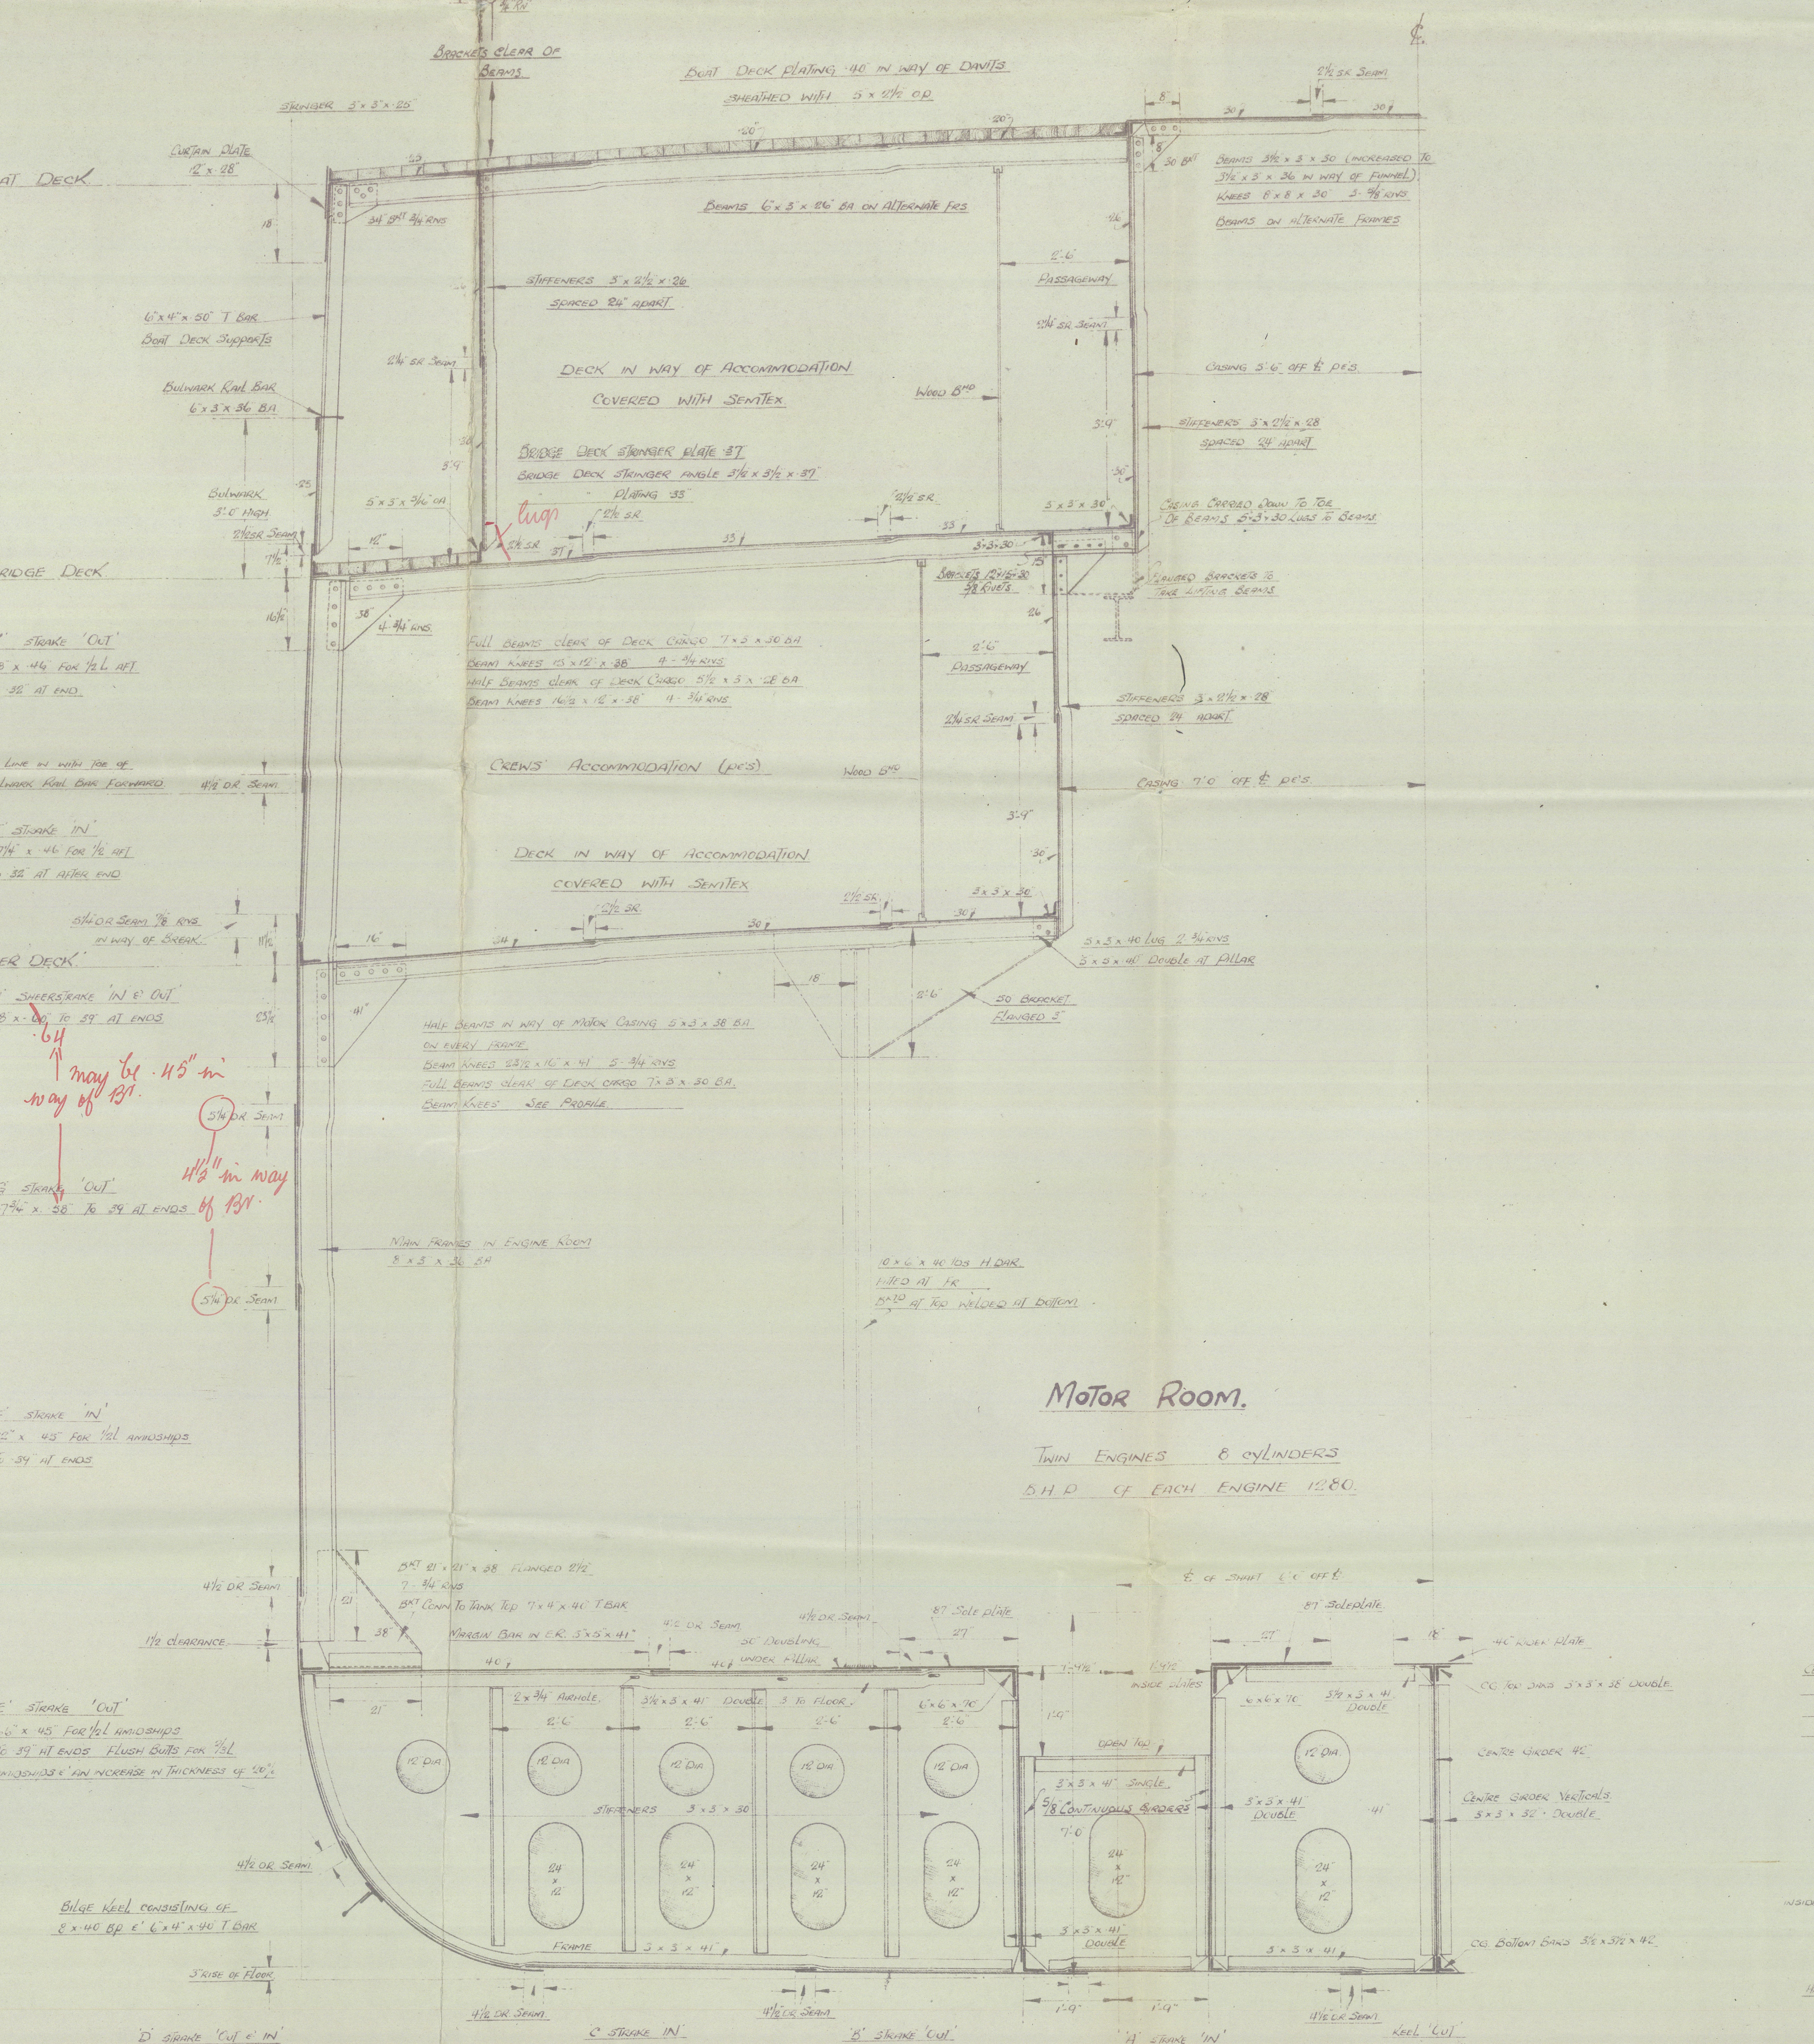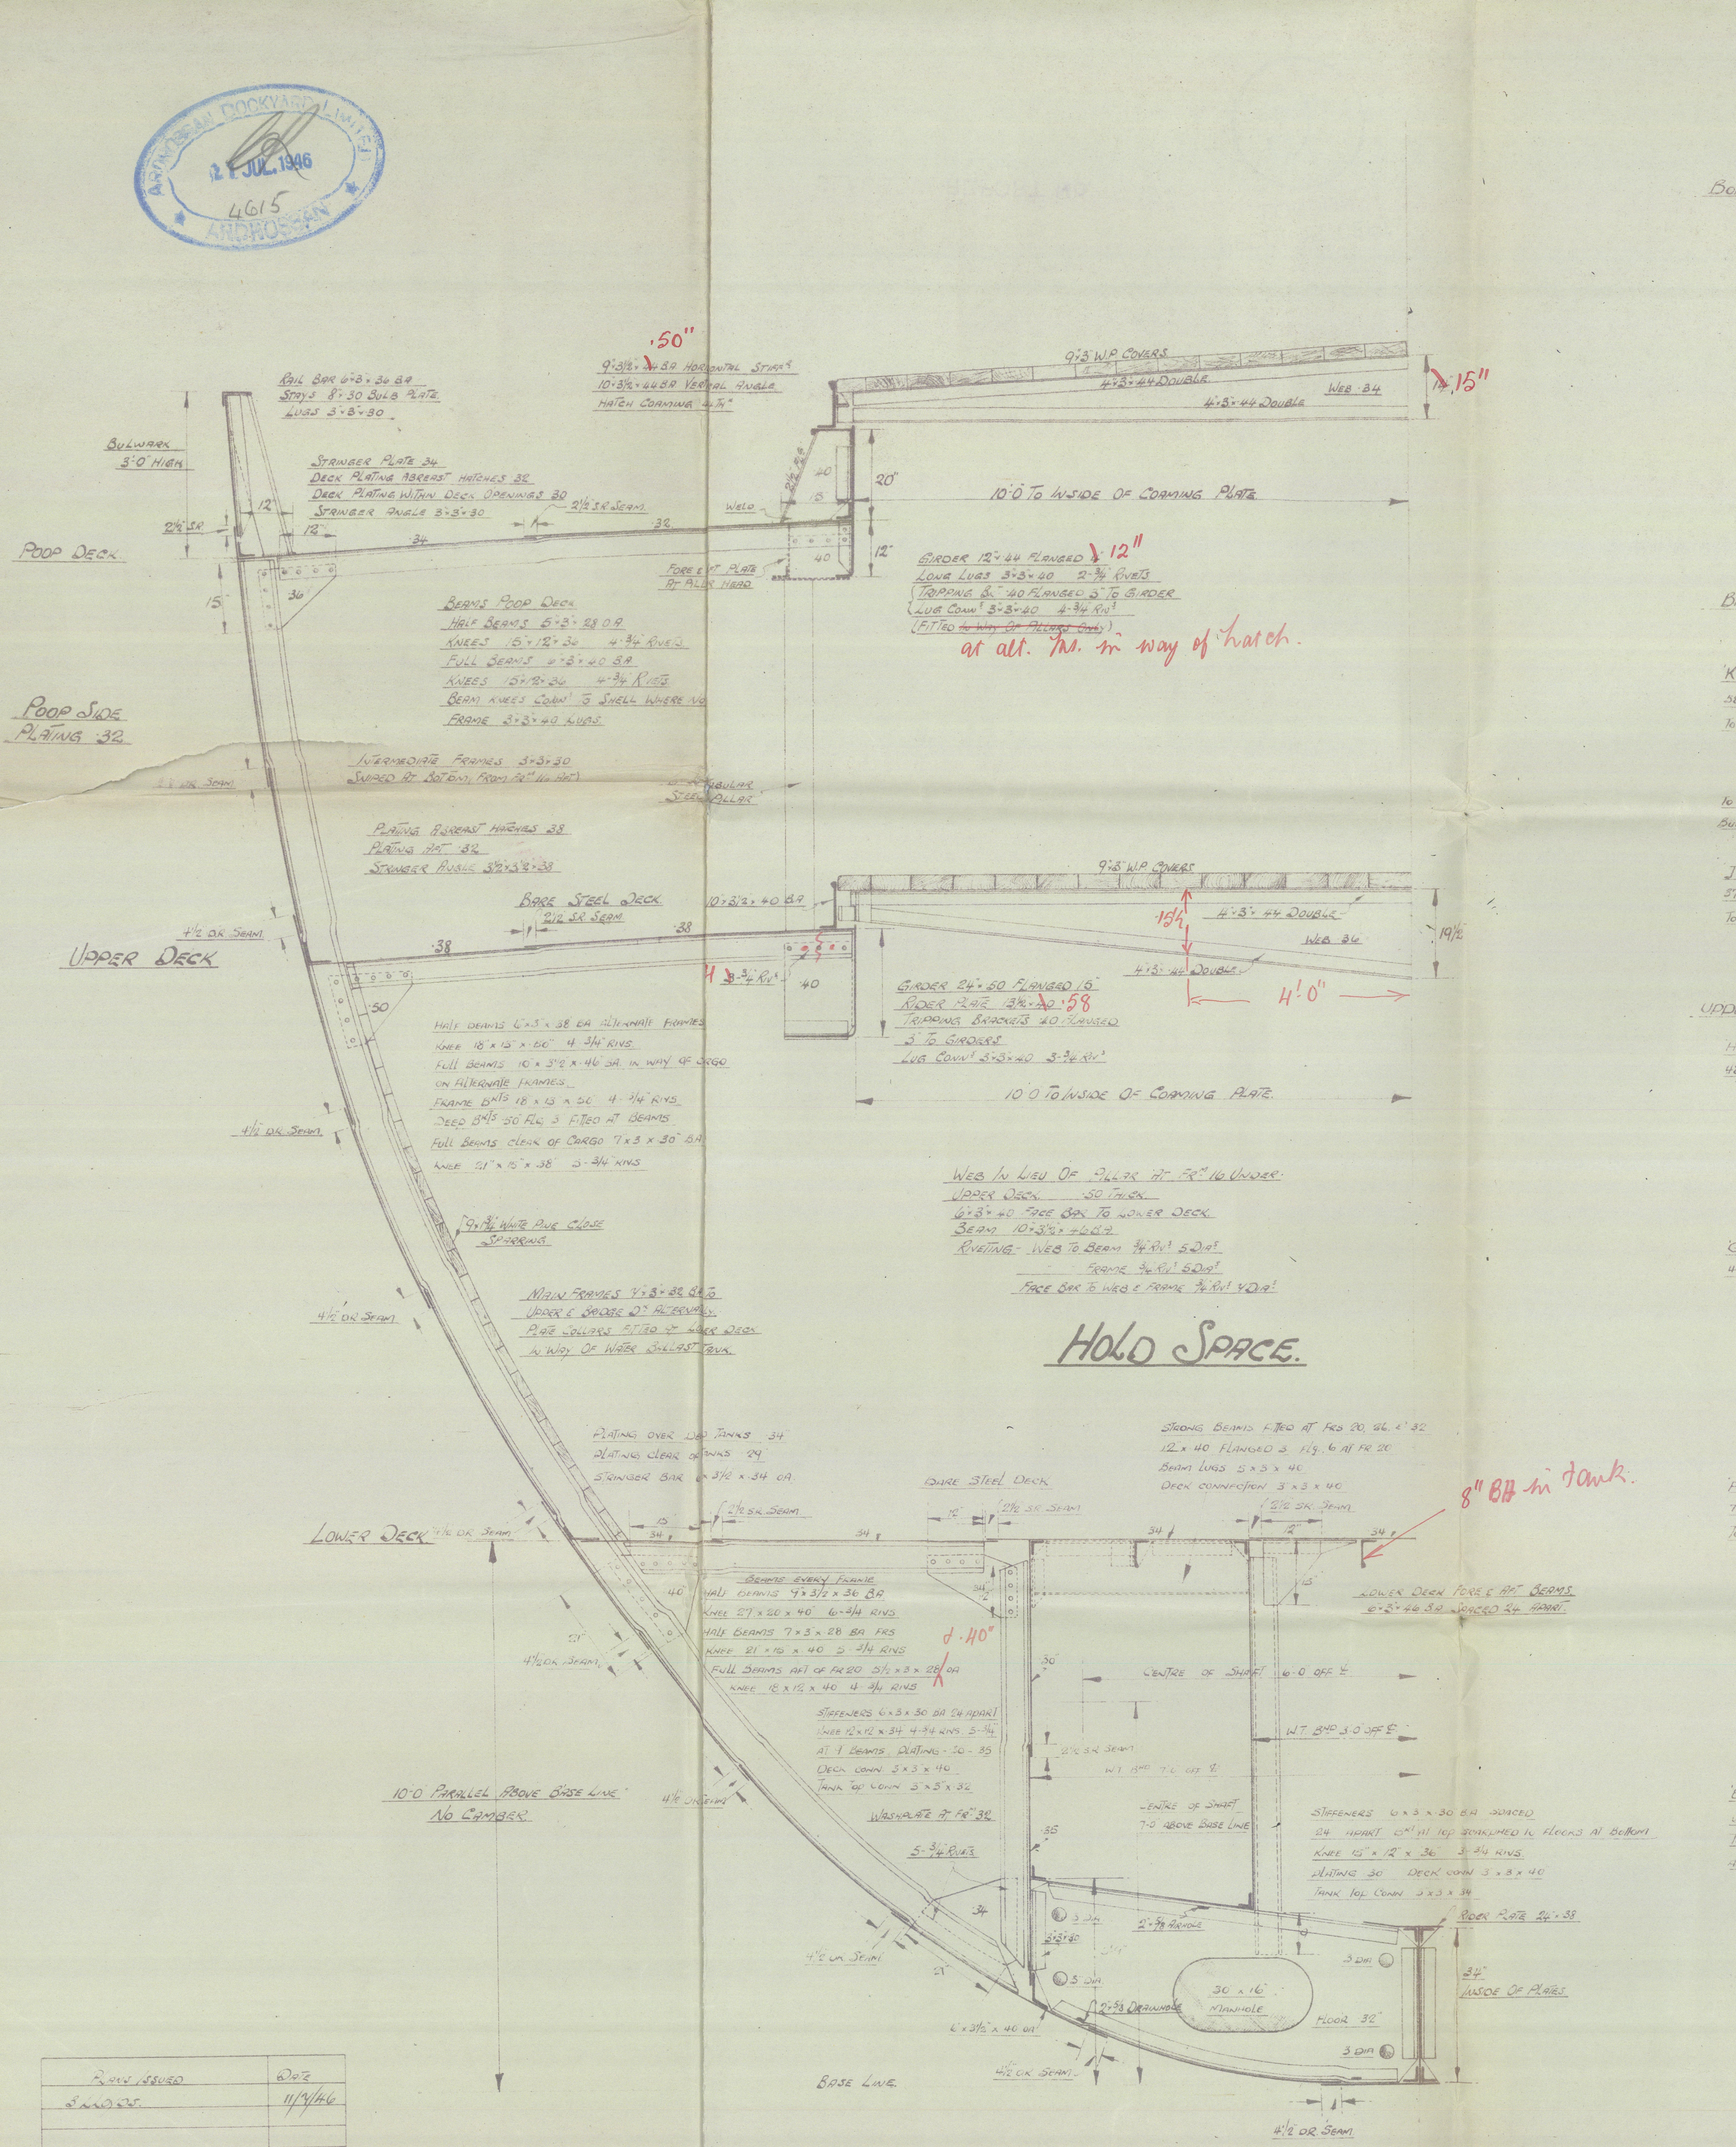

LLOYDS

002846-002852-0079 © 2020

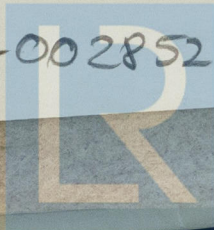

Lloyd's Register
Foundation

Ardrossan Dockyard Gt

Yards 404


Battle Case ★

—
Mudship Section

764
— Glasgow Rpt to 72711

GLASGOW REPORT No. 72960

RECORDS DEPT.,
LONDON

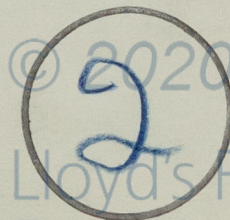

Lloyd's Register
Foundation

002846-002852-0079