


PROFILE & DECKS.

SCALE: 1/8" = 1 FOOT.

TO CLASS 100 A1 WITH FREEBOARD CORRESPONDING TO A F.S. VESSEL WITH 63 3/4" SUPERSTRUCTURES.

GLASGOW REPORT NO. 72960
Balks Crest

PARTICULARS
LENGTH B.P. 265'0"
BREADTH M/L 43'0"
DEPTH TO UPPER D. 19'6"

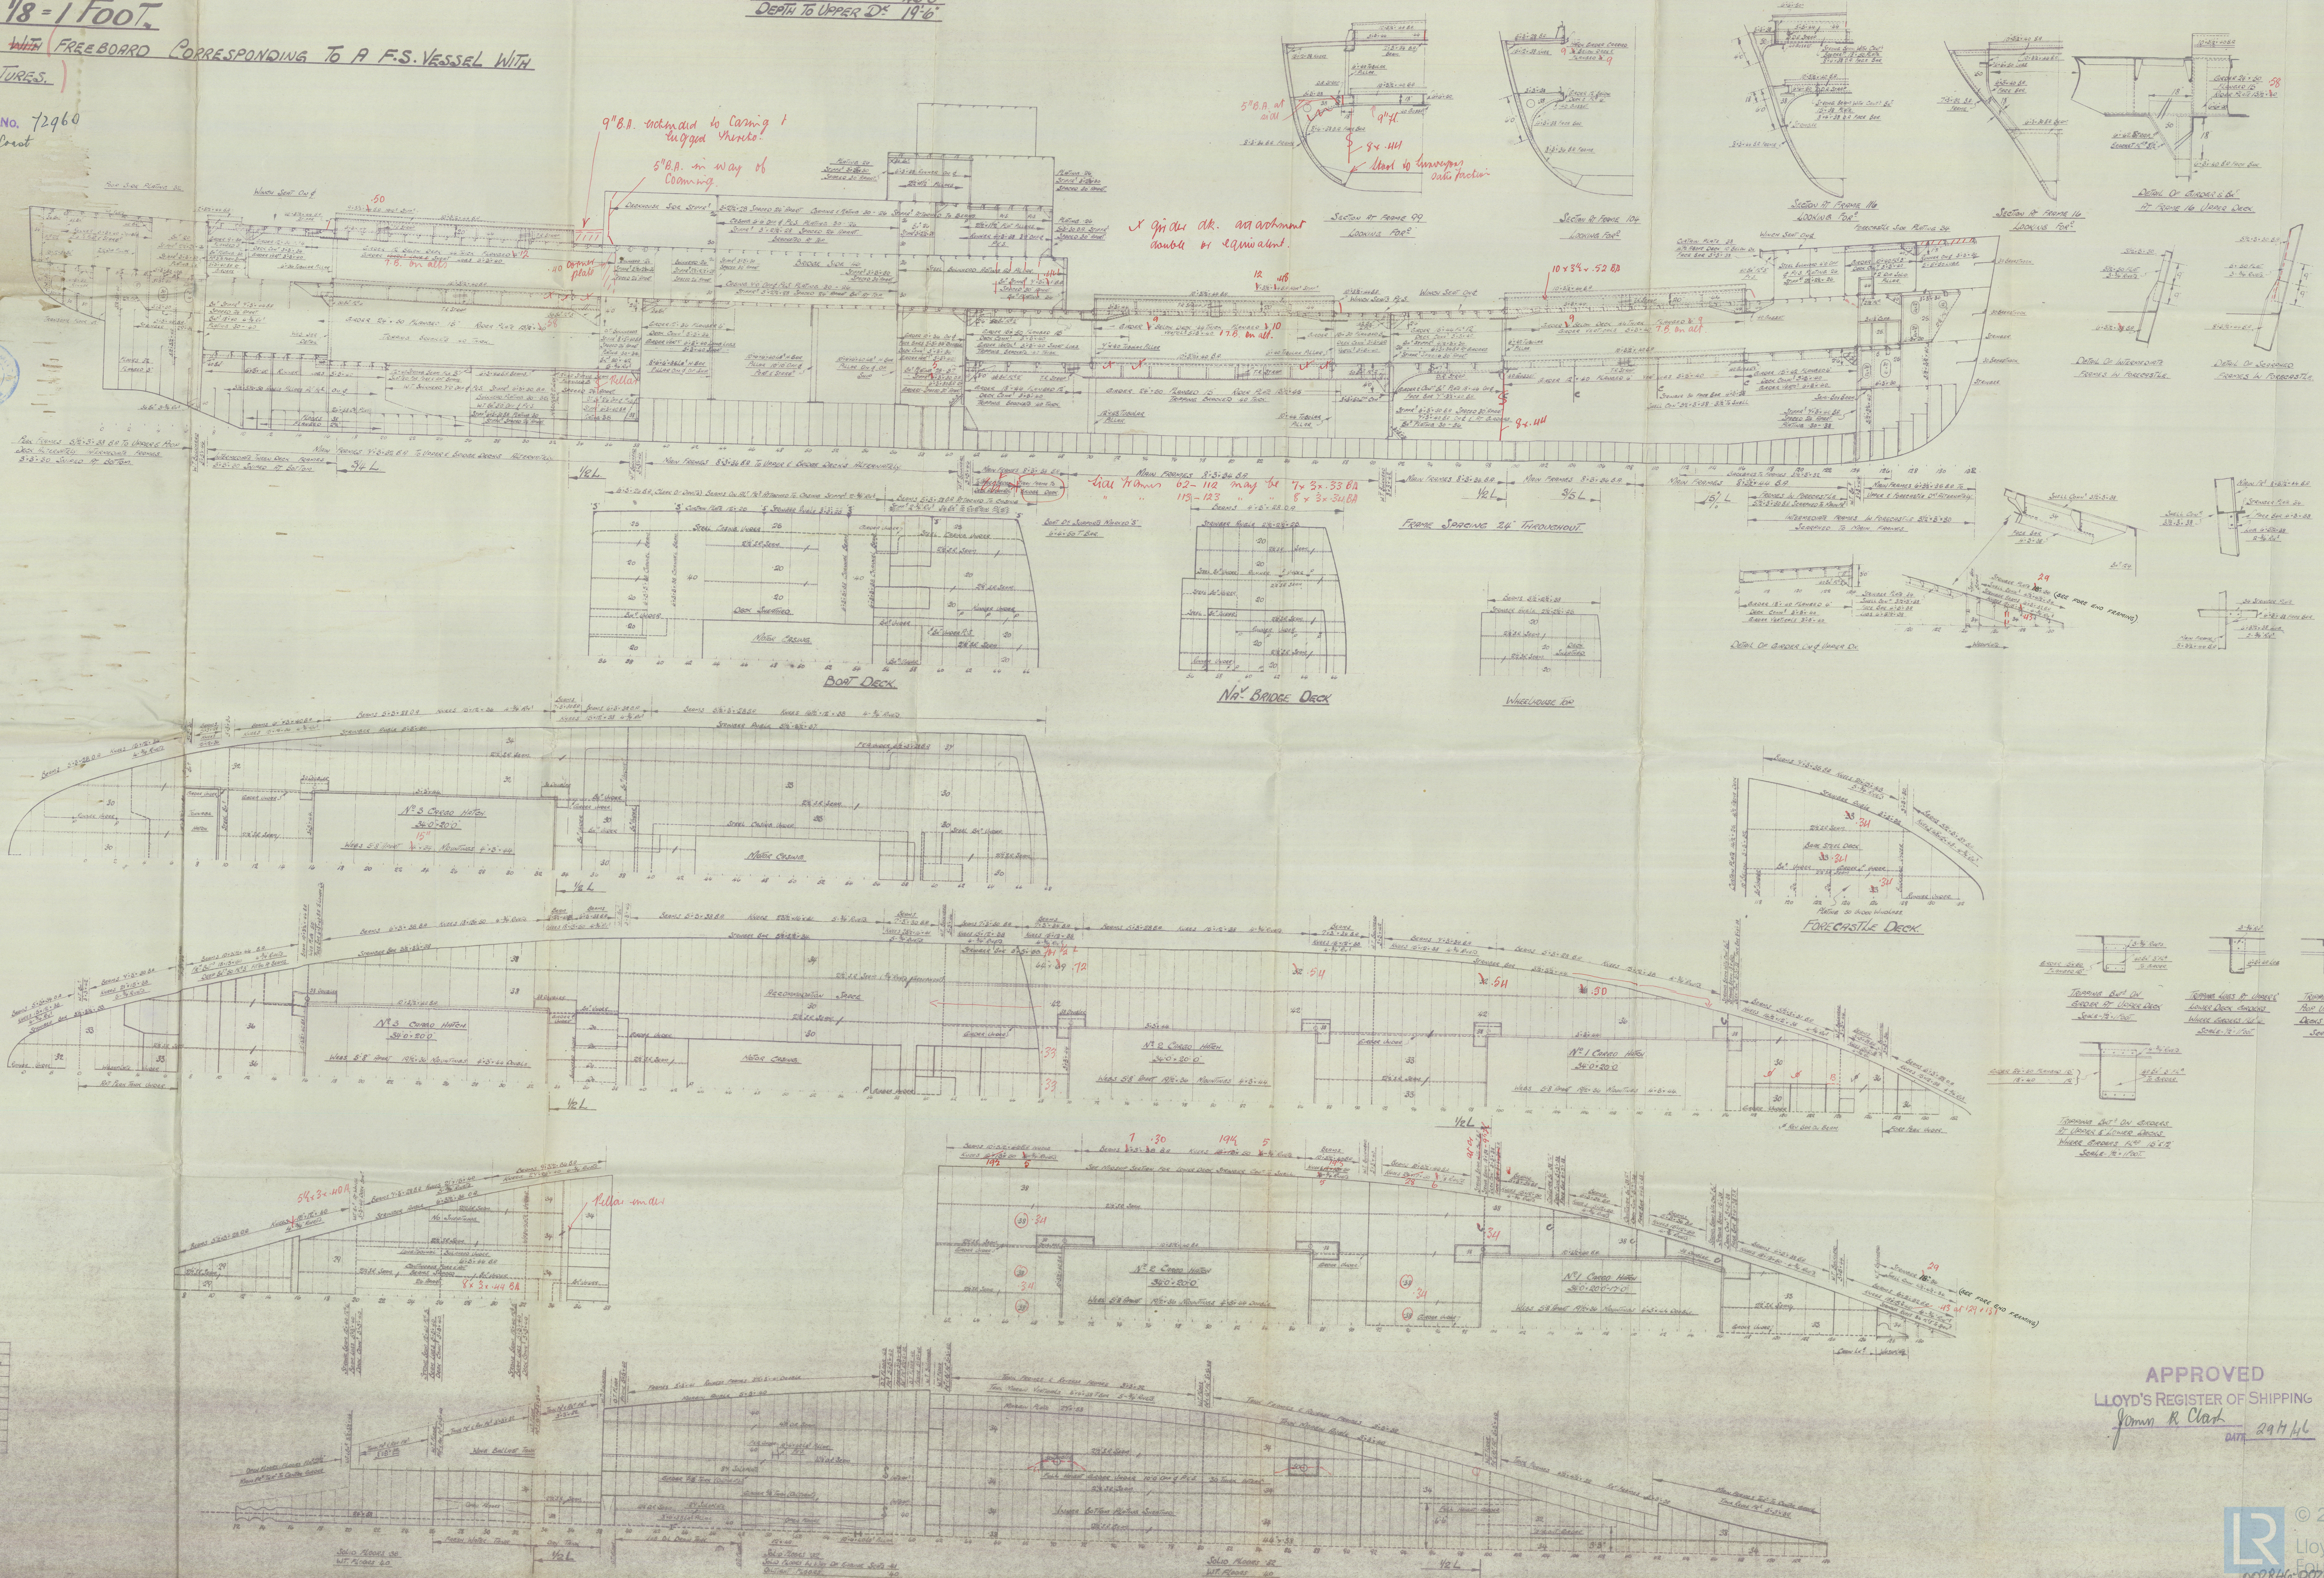

Plank Deck	2012
Plank Deck	1946


APPROVED
LLOYD'S REGISTER OF SHIPPING
John R. Clark
29/7/46

"BALTIC COAST"



Profile & decks

RECORDS DEPT.,
LONDON

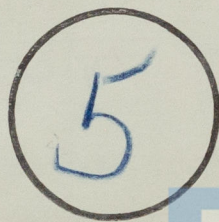

© 2020

Lloyd's Register
Foundation

002846-002852-0080