
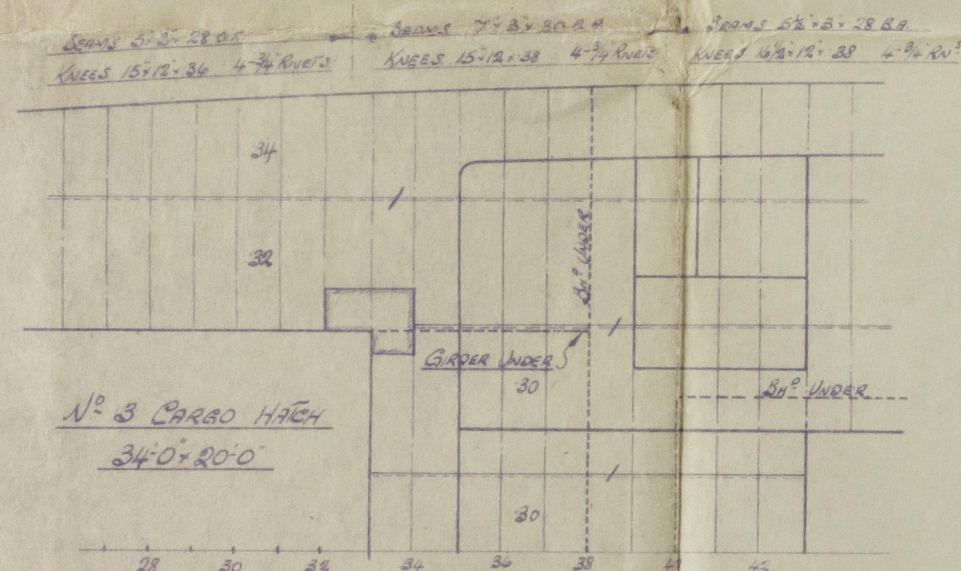
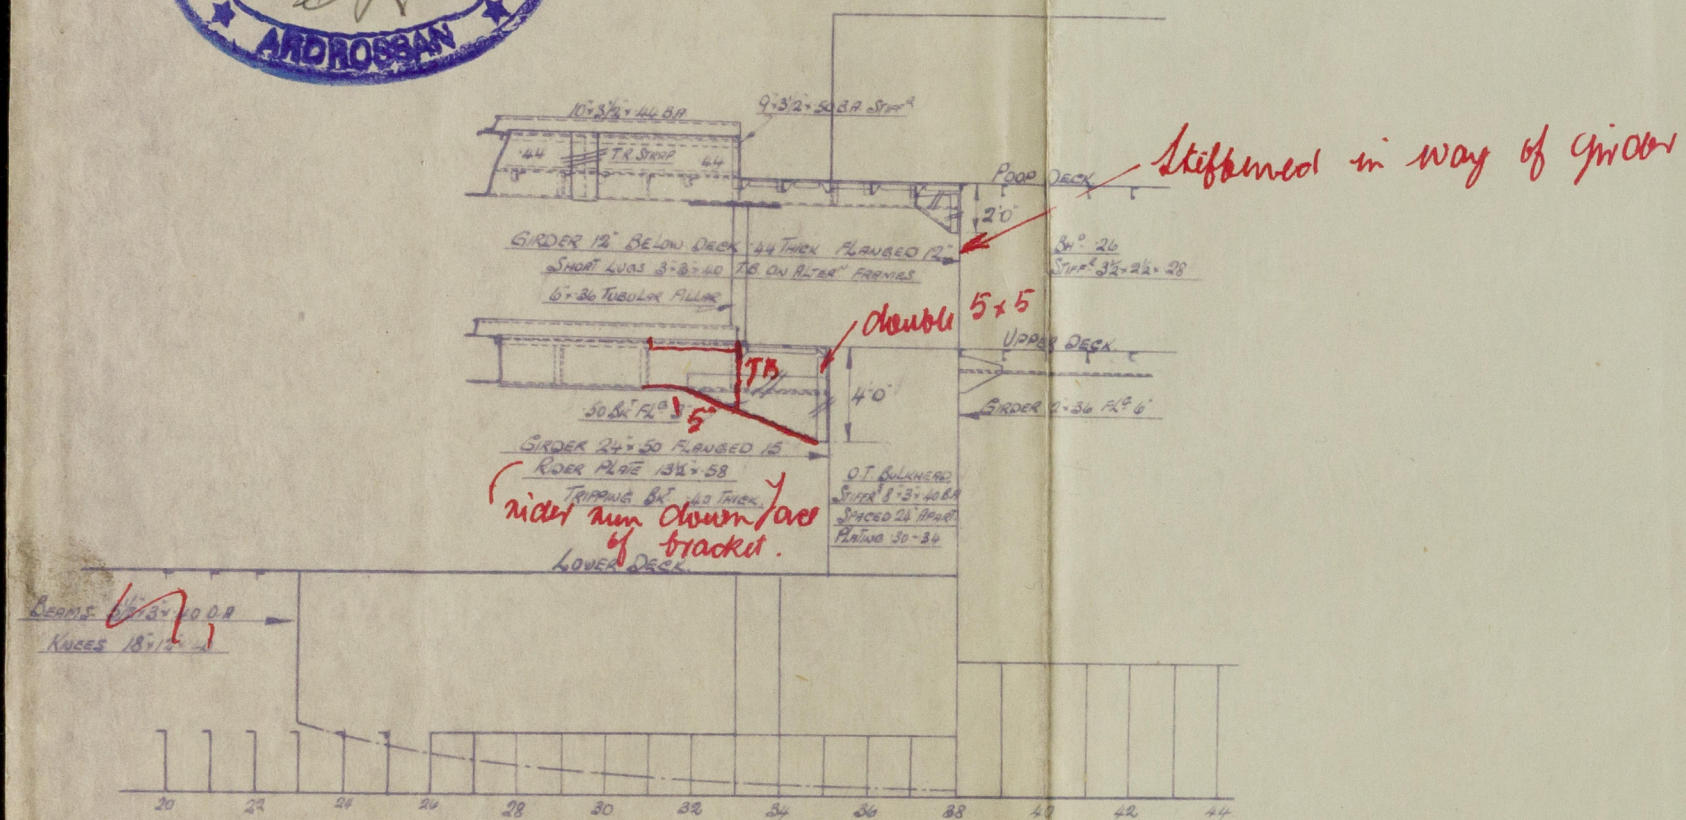



SHIP NO 404

PROFILE & DECKS (MODIFICATIONS)

SCALE: 1/8" = 1 FOOT.

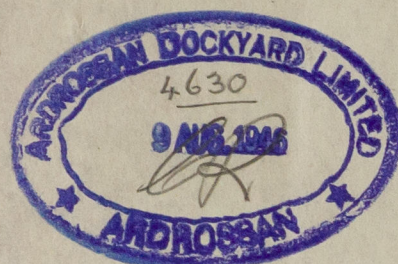

POOP DECK

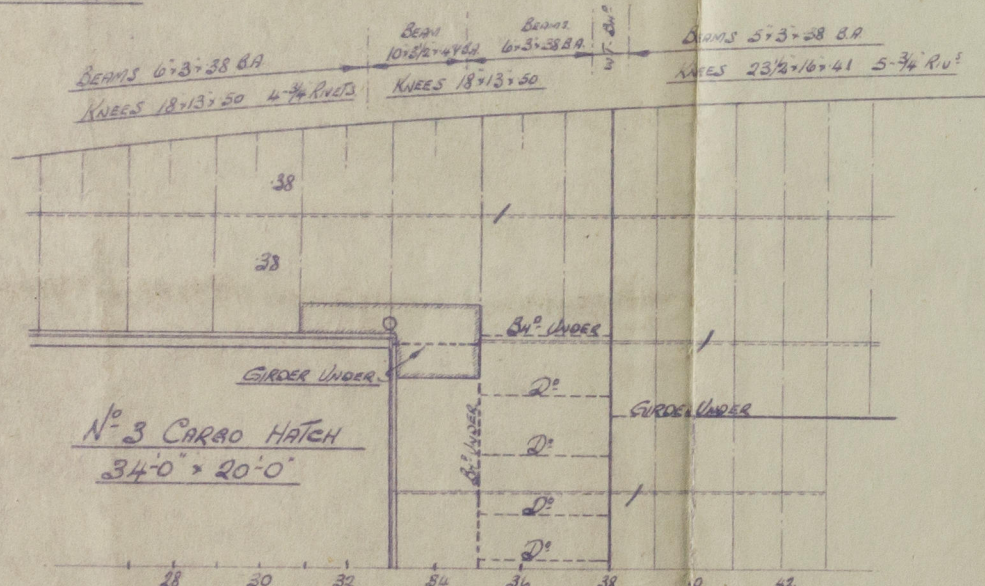


UPPER DECK

PLANS ISSUED	DATE
3 LLOYD'S	9/8/46


Weight assumed not to exceed that represented by 8'0" of Car 90 at a density of 100 c.f./sqm.

DECK CARGO


Side frames 8 x 3 x 34 BA.

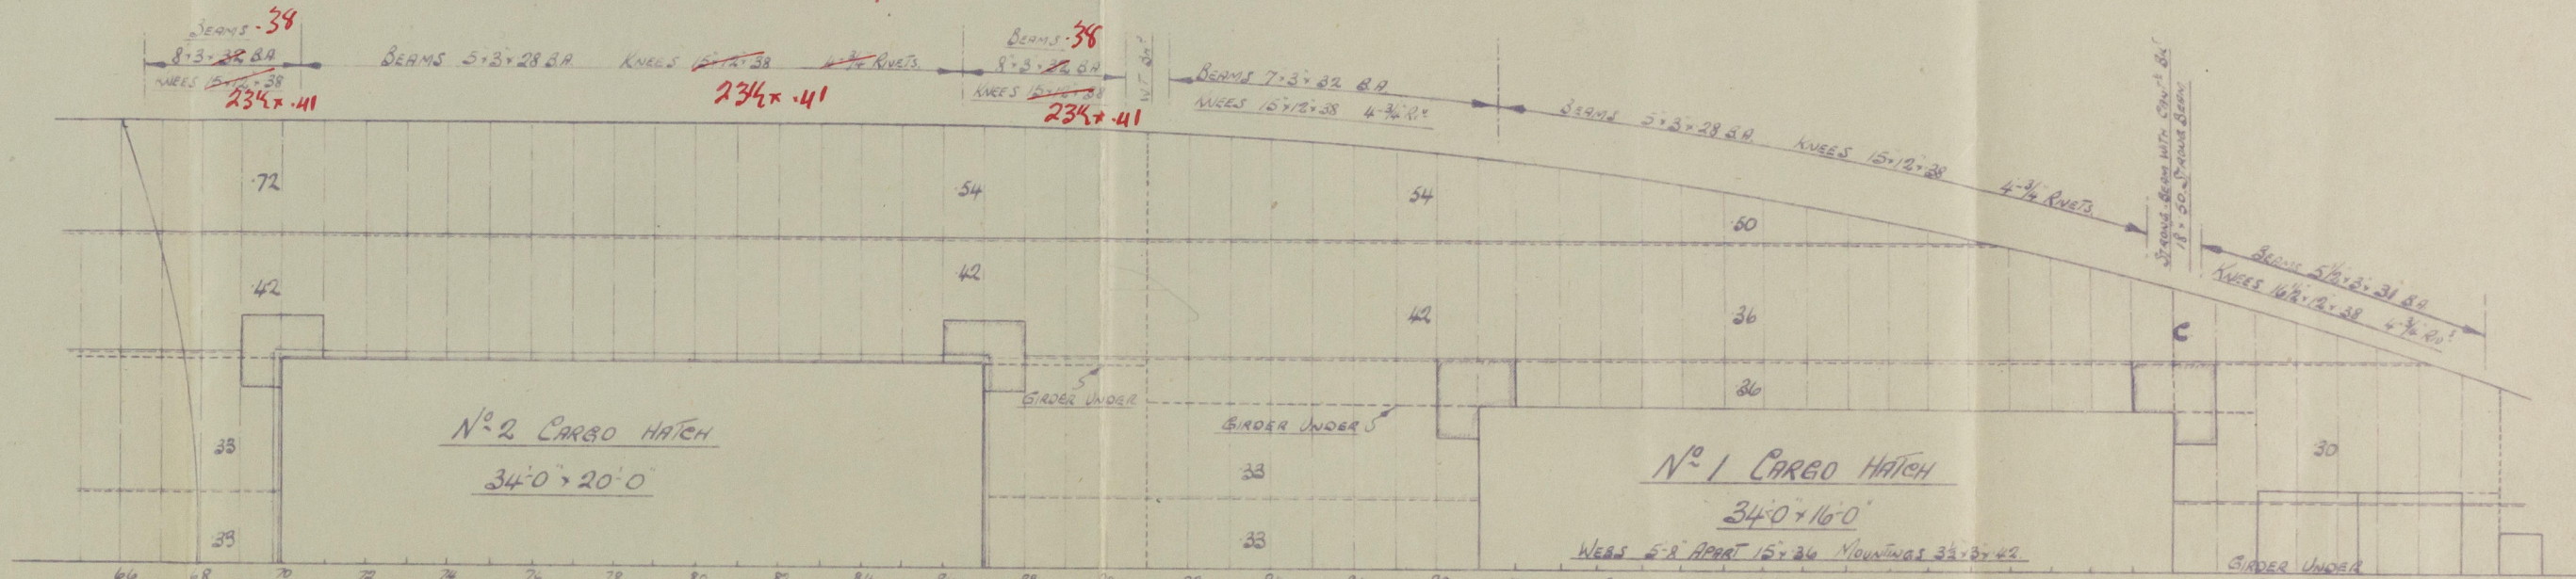


UPPER DECK

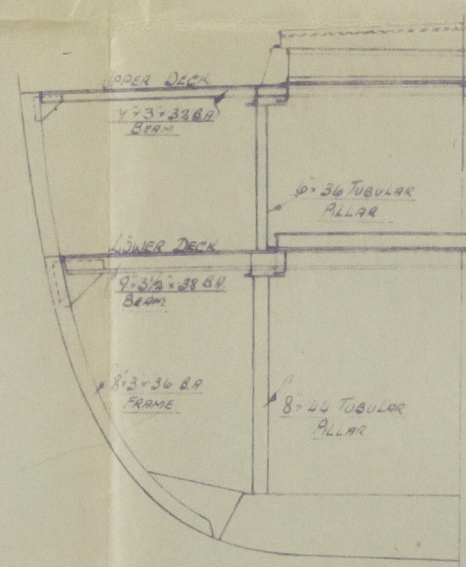

SECTION AT FRAME 99

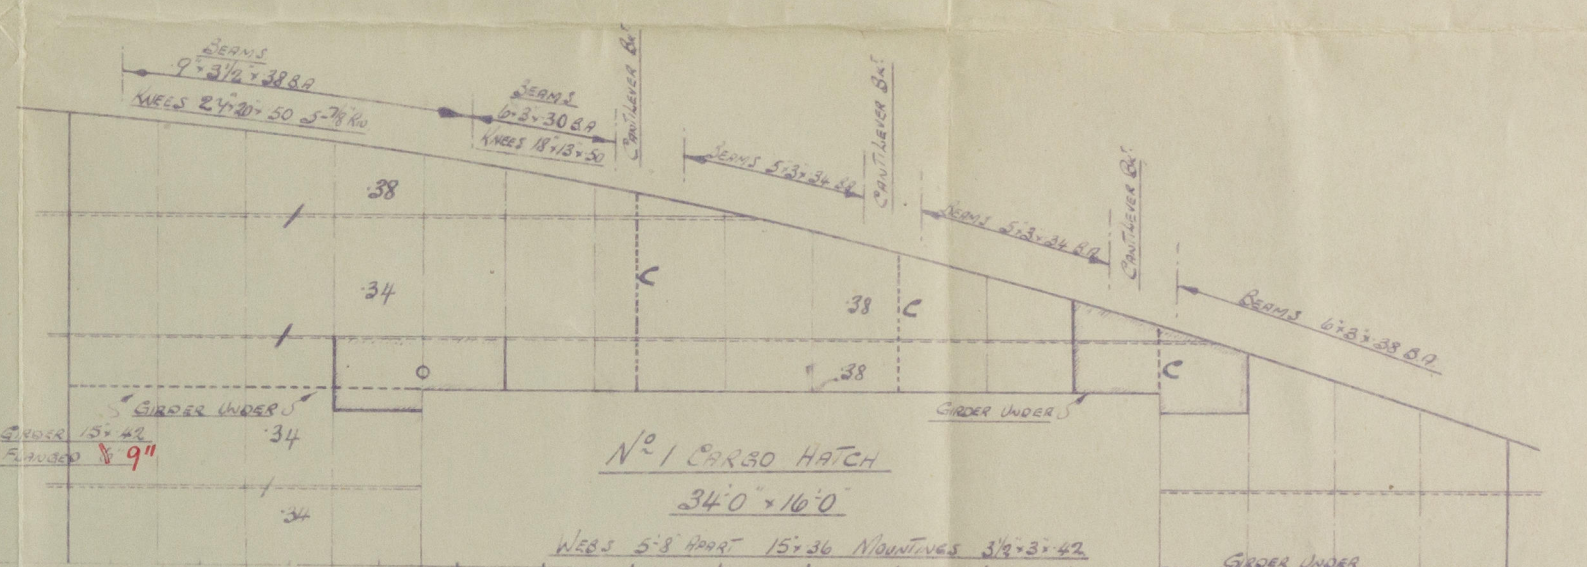

LOWER DECK

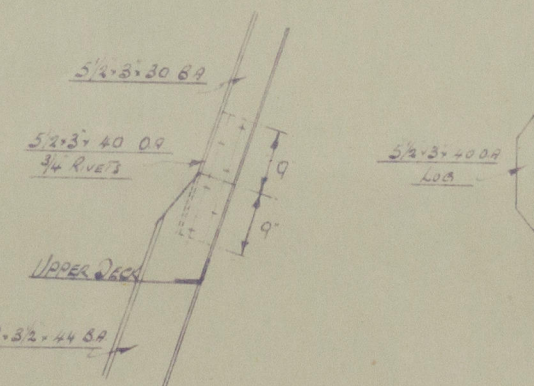

DETAIL OF SCARFED FRAMES IN FORECASTLE


ALL OTHER SCANTLINGS
AS PER APPROVED PROFILE 29/4/46.

APPROVED
LLOYD'S REGISTER OF SHIPPING
James R Clark
DATE 16/8/46

"BALTIC COAST" ★

Profile & decks (modification)

RECORDS DEPT.,
LONDON

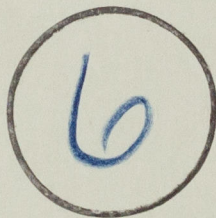

© 2020

Lloyd's Register
Foundation

002846-002852-0081